

S S FLYING SPITFIRE

OIL FUEL BUNKER BULKHEADS

SCALE: $\frac{1}{2}'' = 1' 0''$


SHEET No 2




24 SEP 1947

Approved
13.10.47
W. J. H. per Luck


DIAGRAMS
AT FRS 26, 28, 30

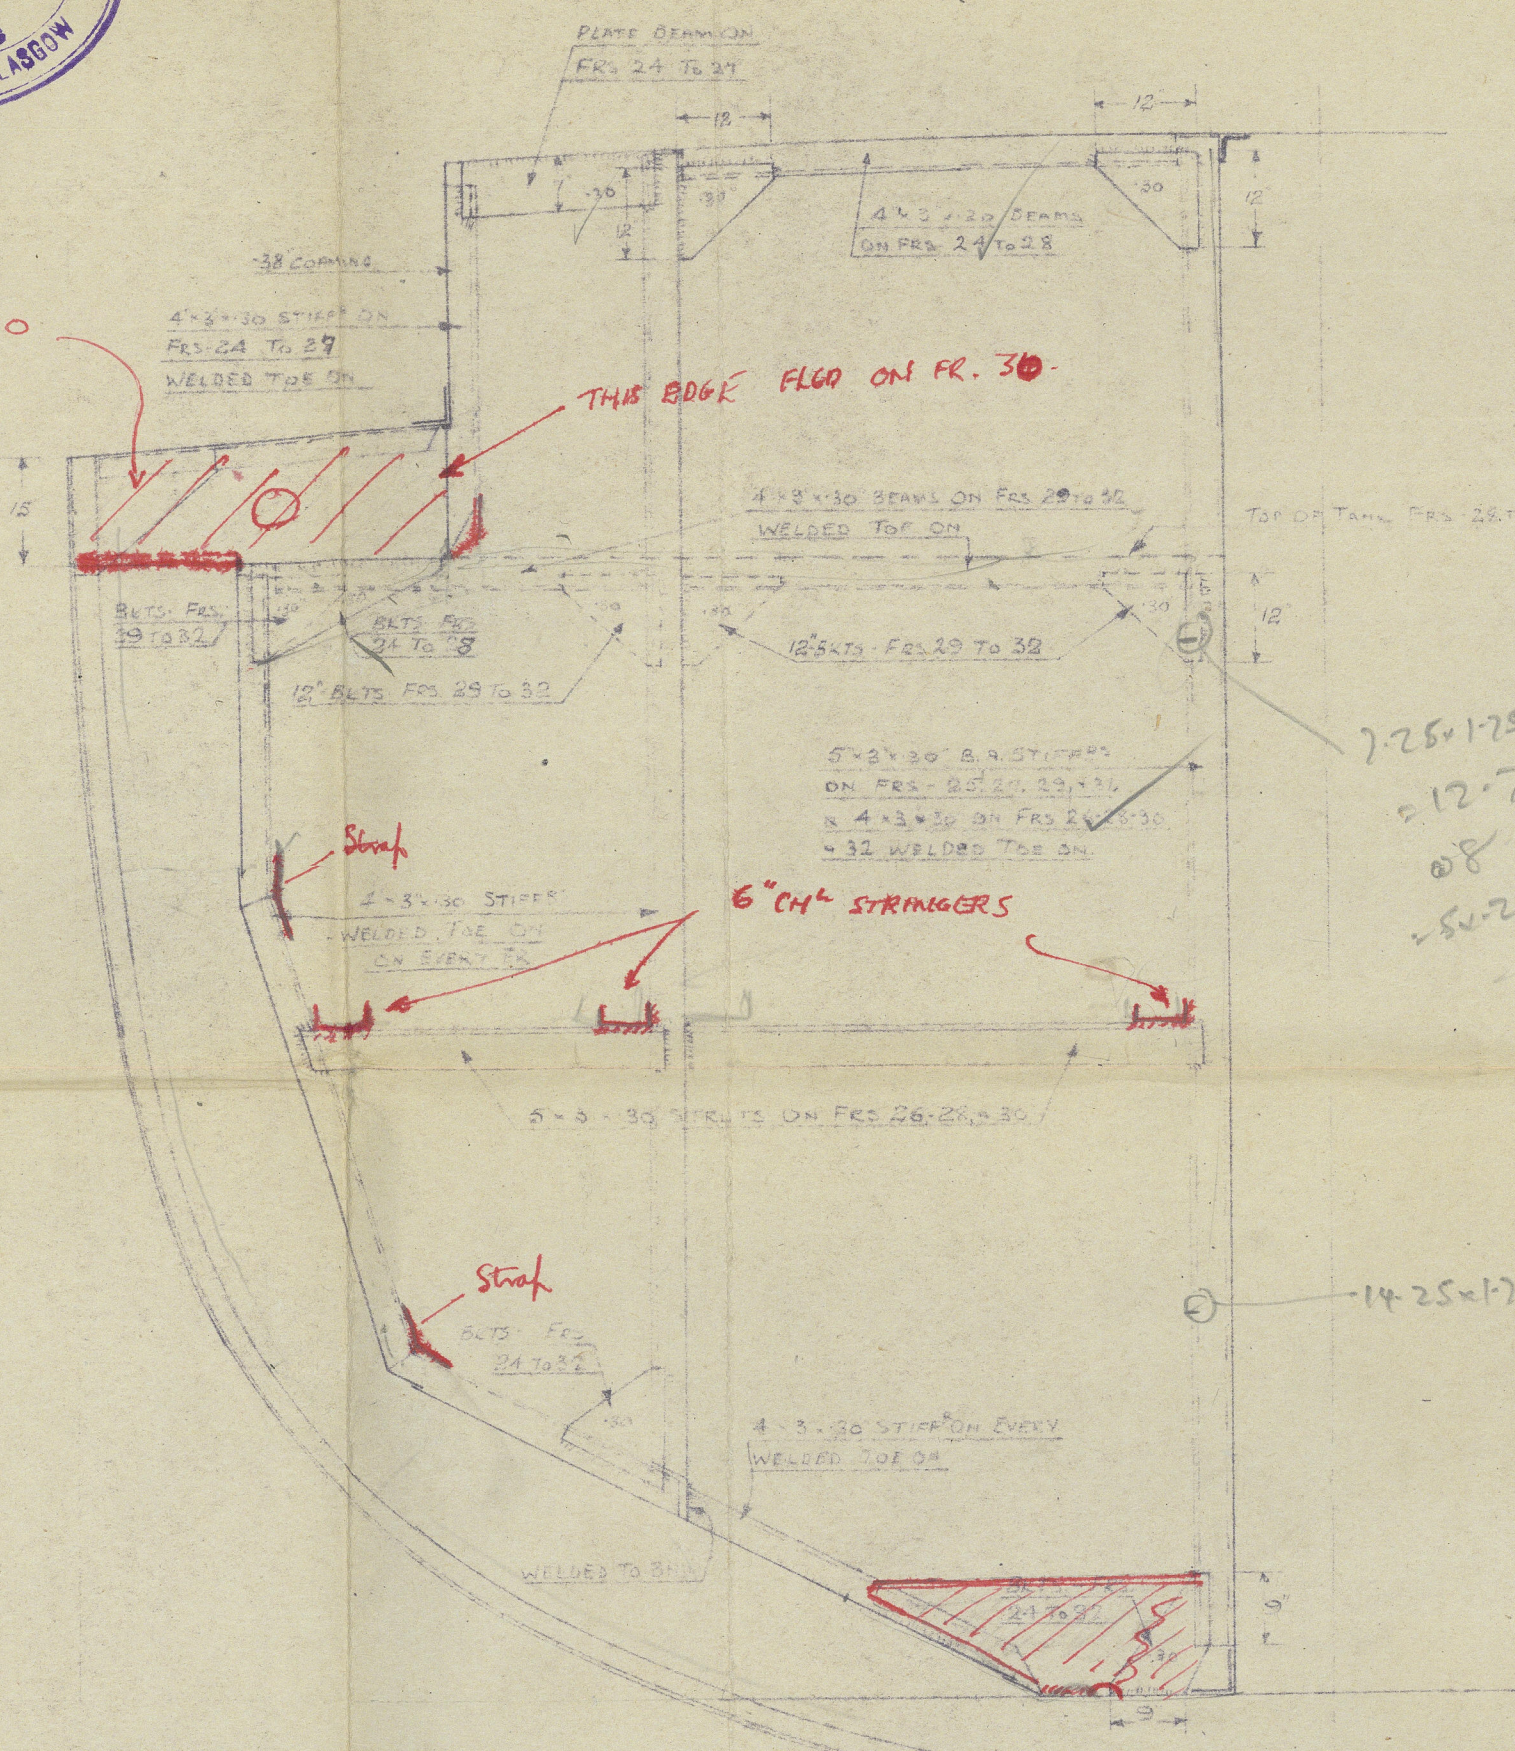


SECTION THROUGH BUNKER
LOOKING FORWARD

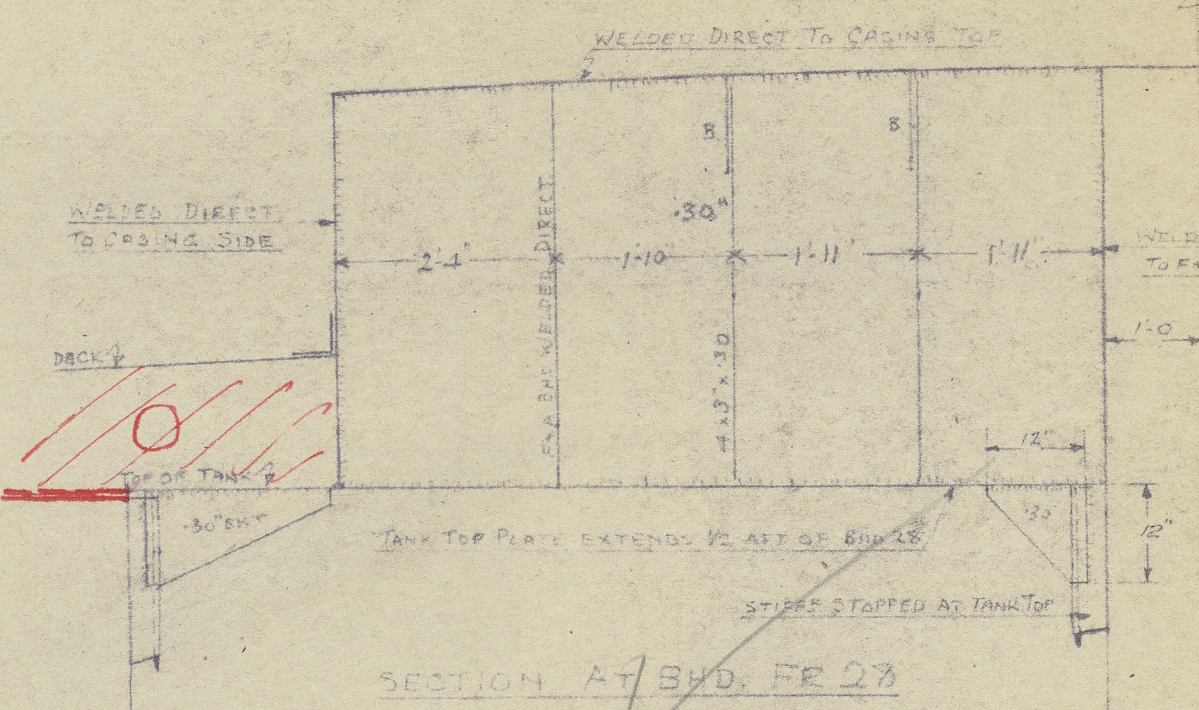


LOOKING FORWARD

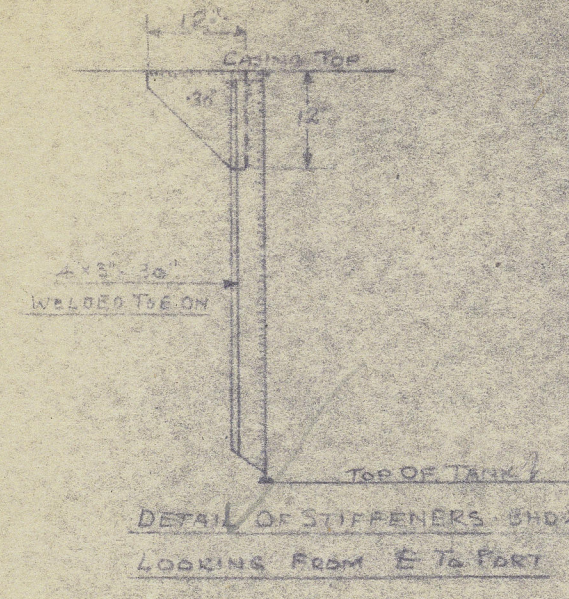


LOOKING FROM E TO PORT

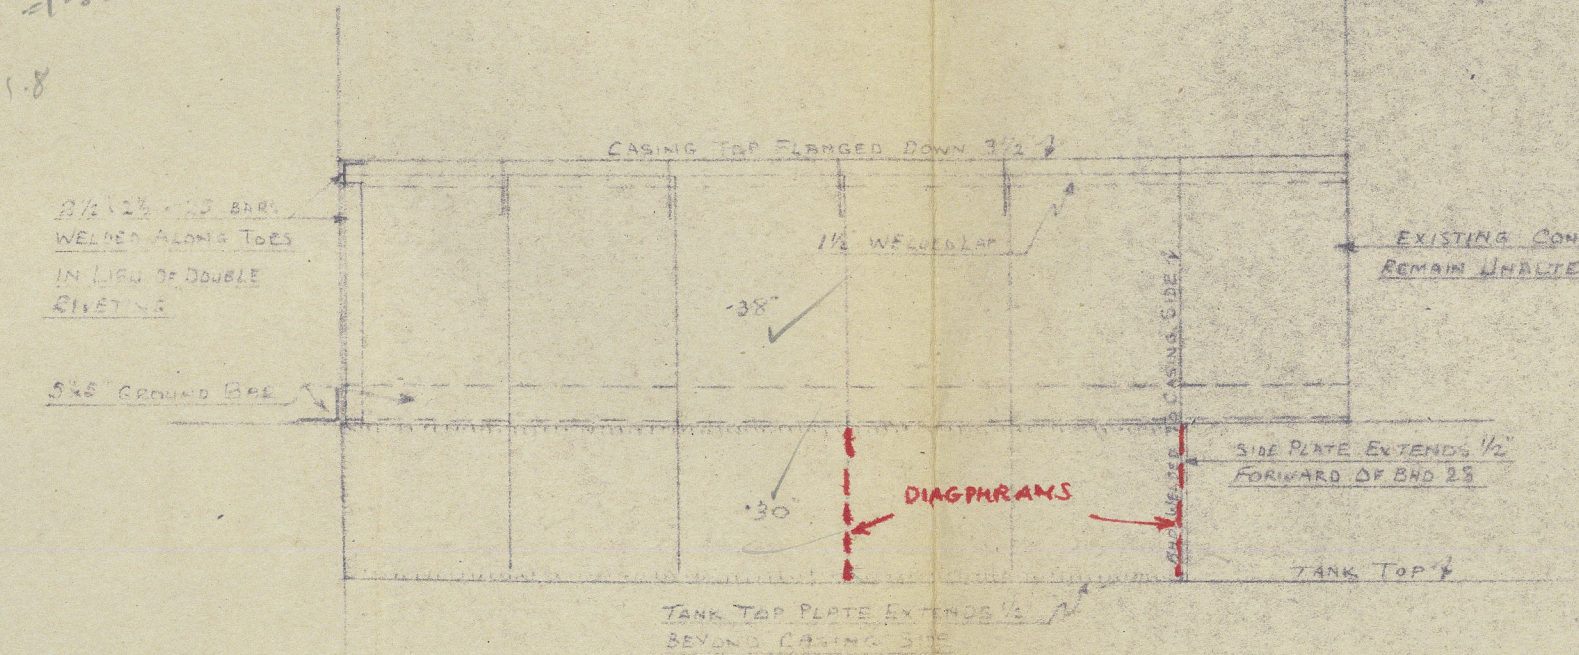

CASING SIDE
PORT SIDE SHOWN LOOKING FROM E
TAKEN FROM SHD. FR 23
STIFFENERS 4\"/>

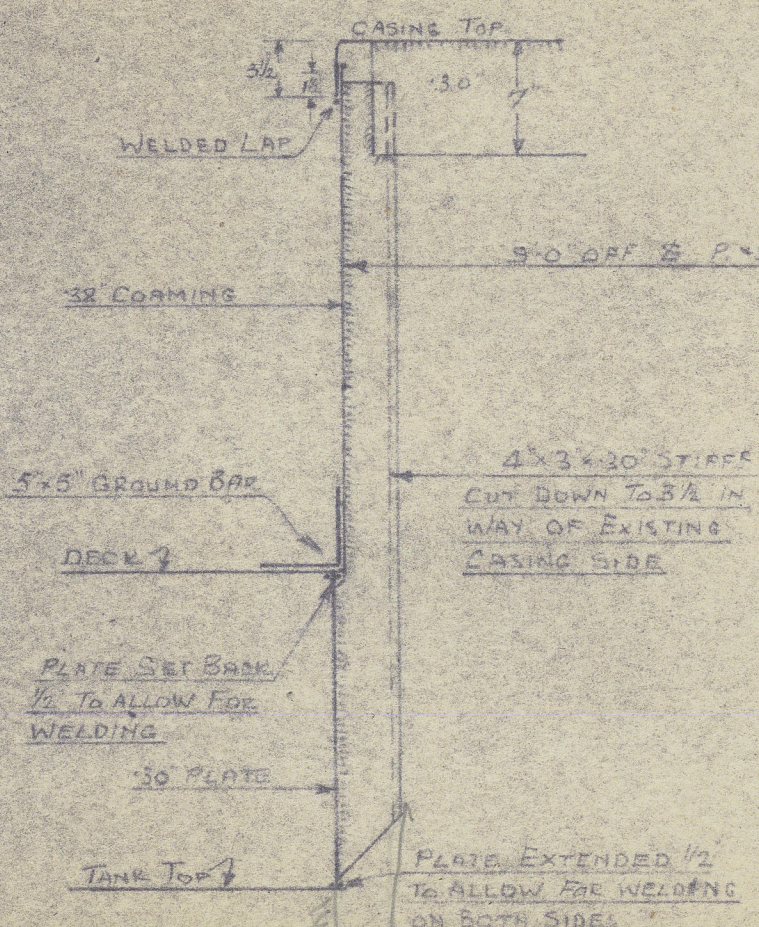

SECTION THROUGH BUNKER CASING
LOOKING FORWARD
SCALE: $\frac{1}{2}'' = 1' 0''$

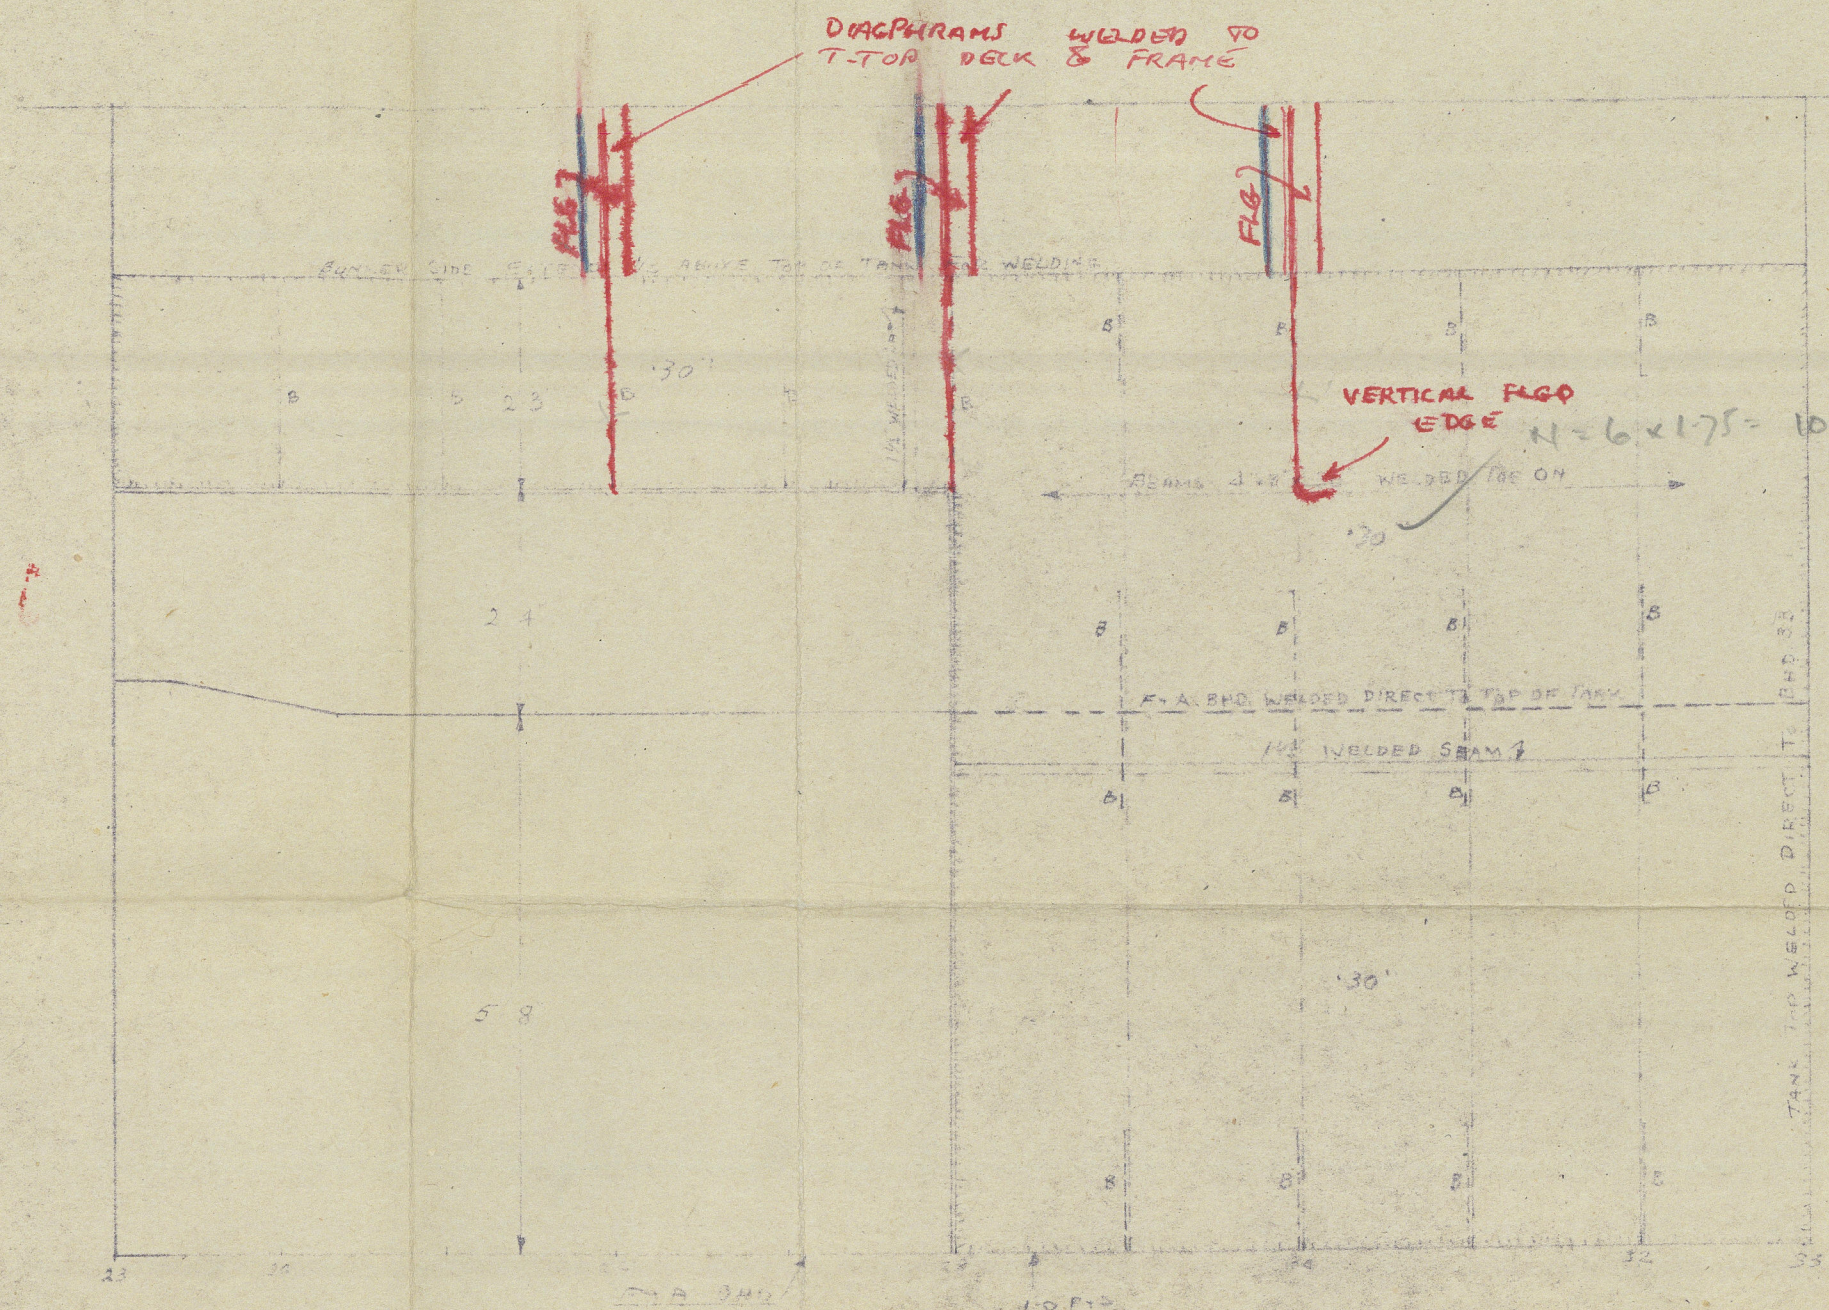


PLAN OF TANK TOP
PORT SIDE SHOWN, STAKE SIDE SIMILAR

$7.5 \times 2 \times 10$
 35

$11 \times 6 \times 175 = 105 \times 4 = 3' 0''$

25\"/>

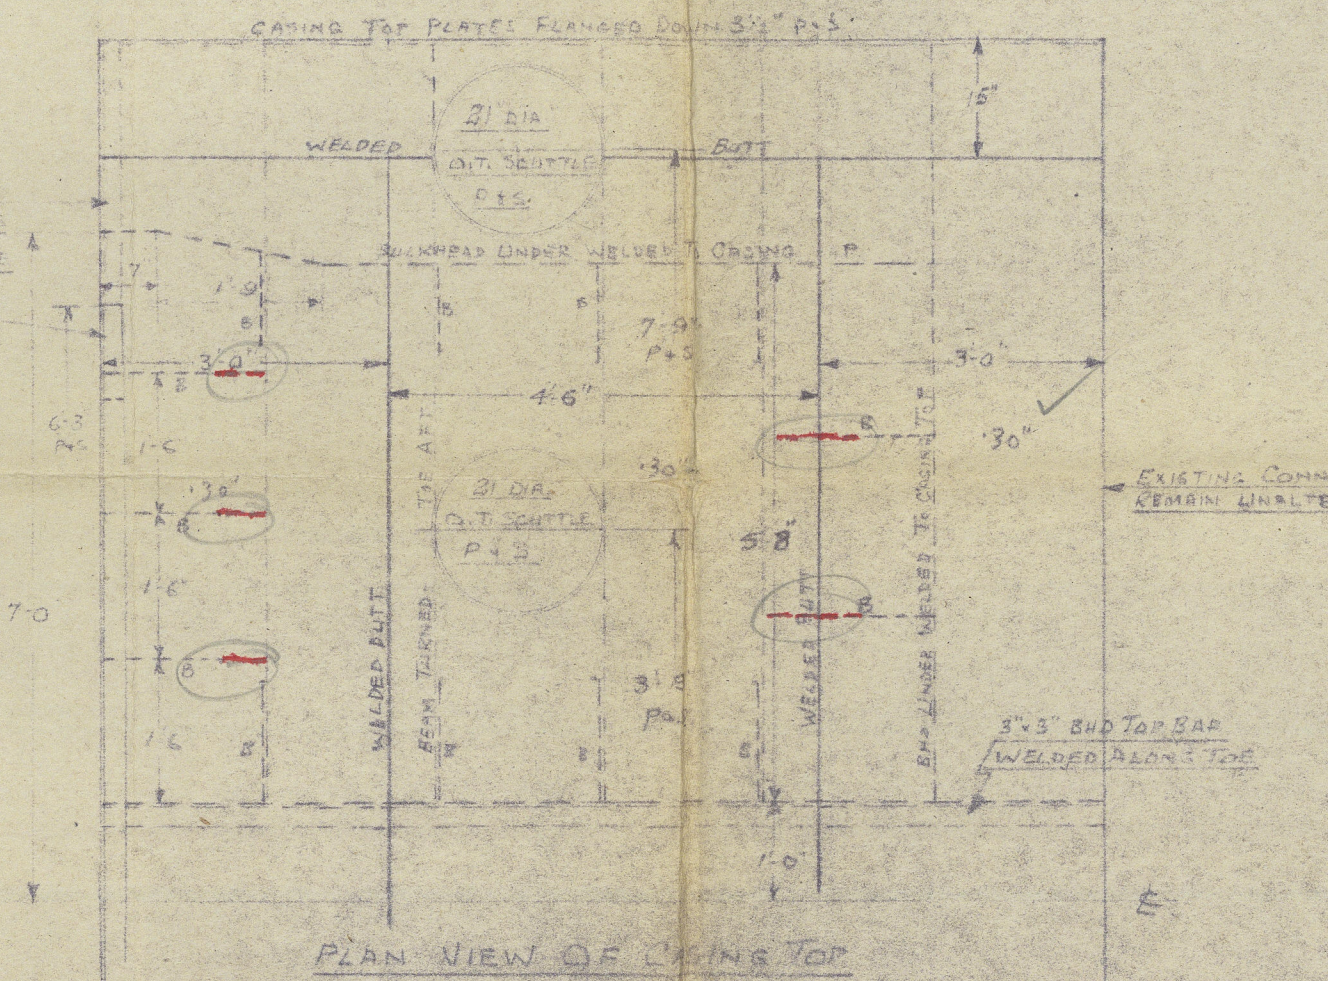

PLAN VIEW OF CASING TOP
PORT SIDE SHOWN, STAKE SIDE SIMILAR

22.

Oil Fuel Bunker Bkds (Sheet 2)

Jas Lament Esq.


8/5 FLYING SPITFIRE

12.10.47

011032-011036-0187

24 SEP 1947

8/5 Flying Spitfire

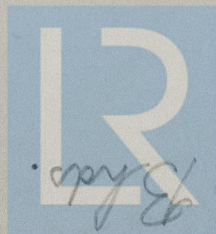

© 2021

Lloyd's Register
Foundation

(Sheet 2)