



S/S FLYING SPITFIRE
OIL FUEL BUNKER BULKHEADS
SCALE: 1/2" = 1'-0"

SHEET NO. 1

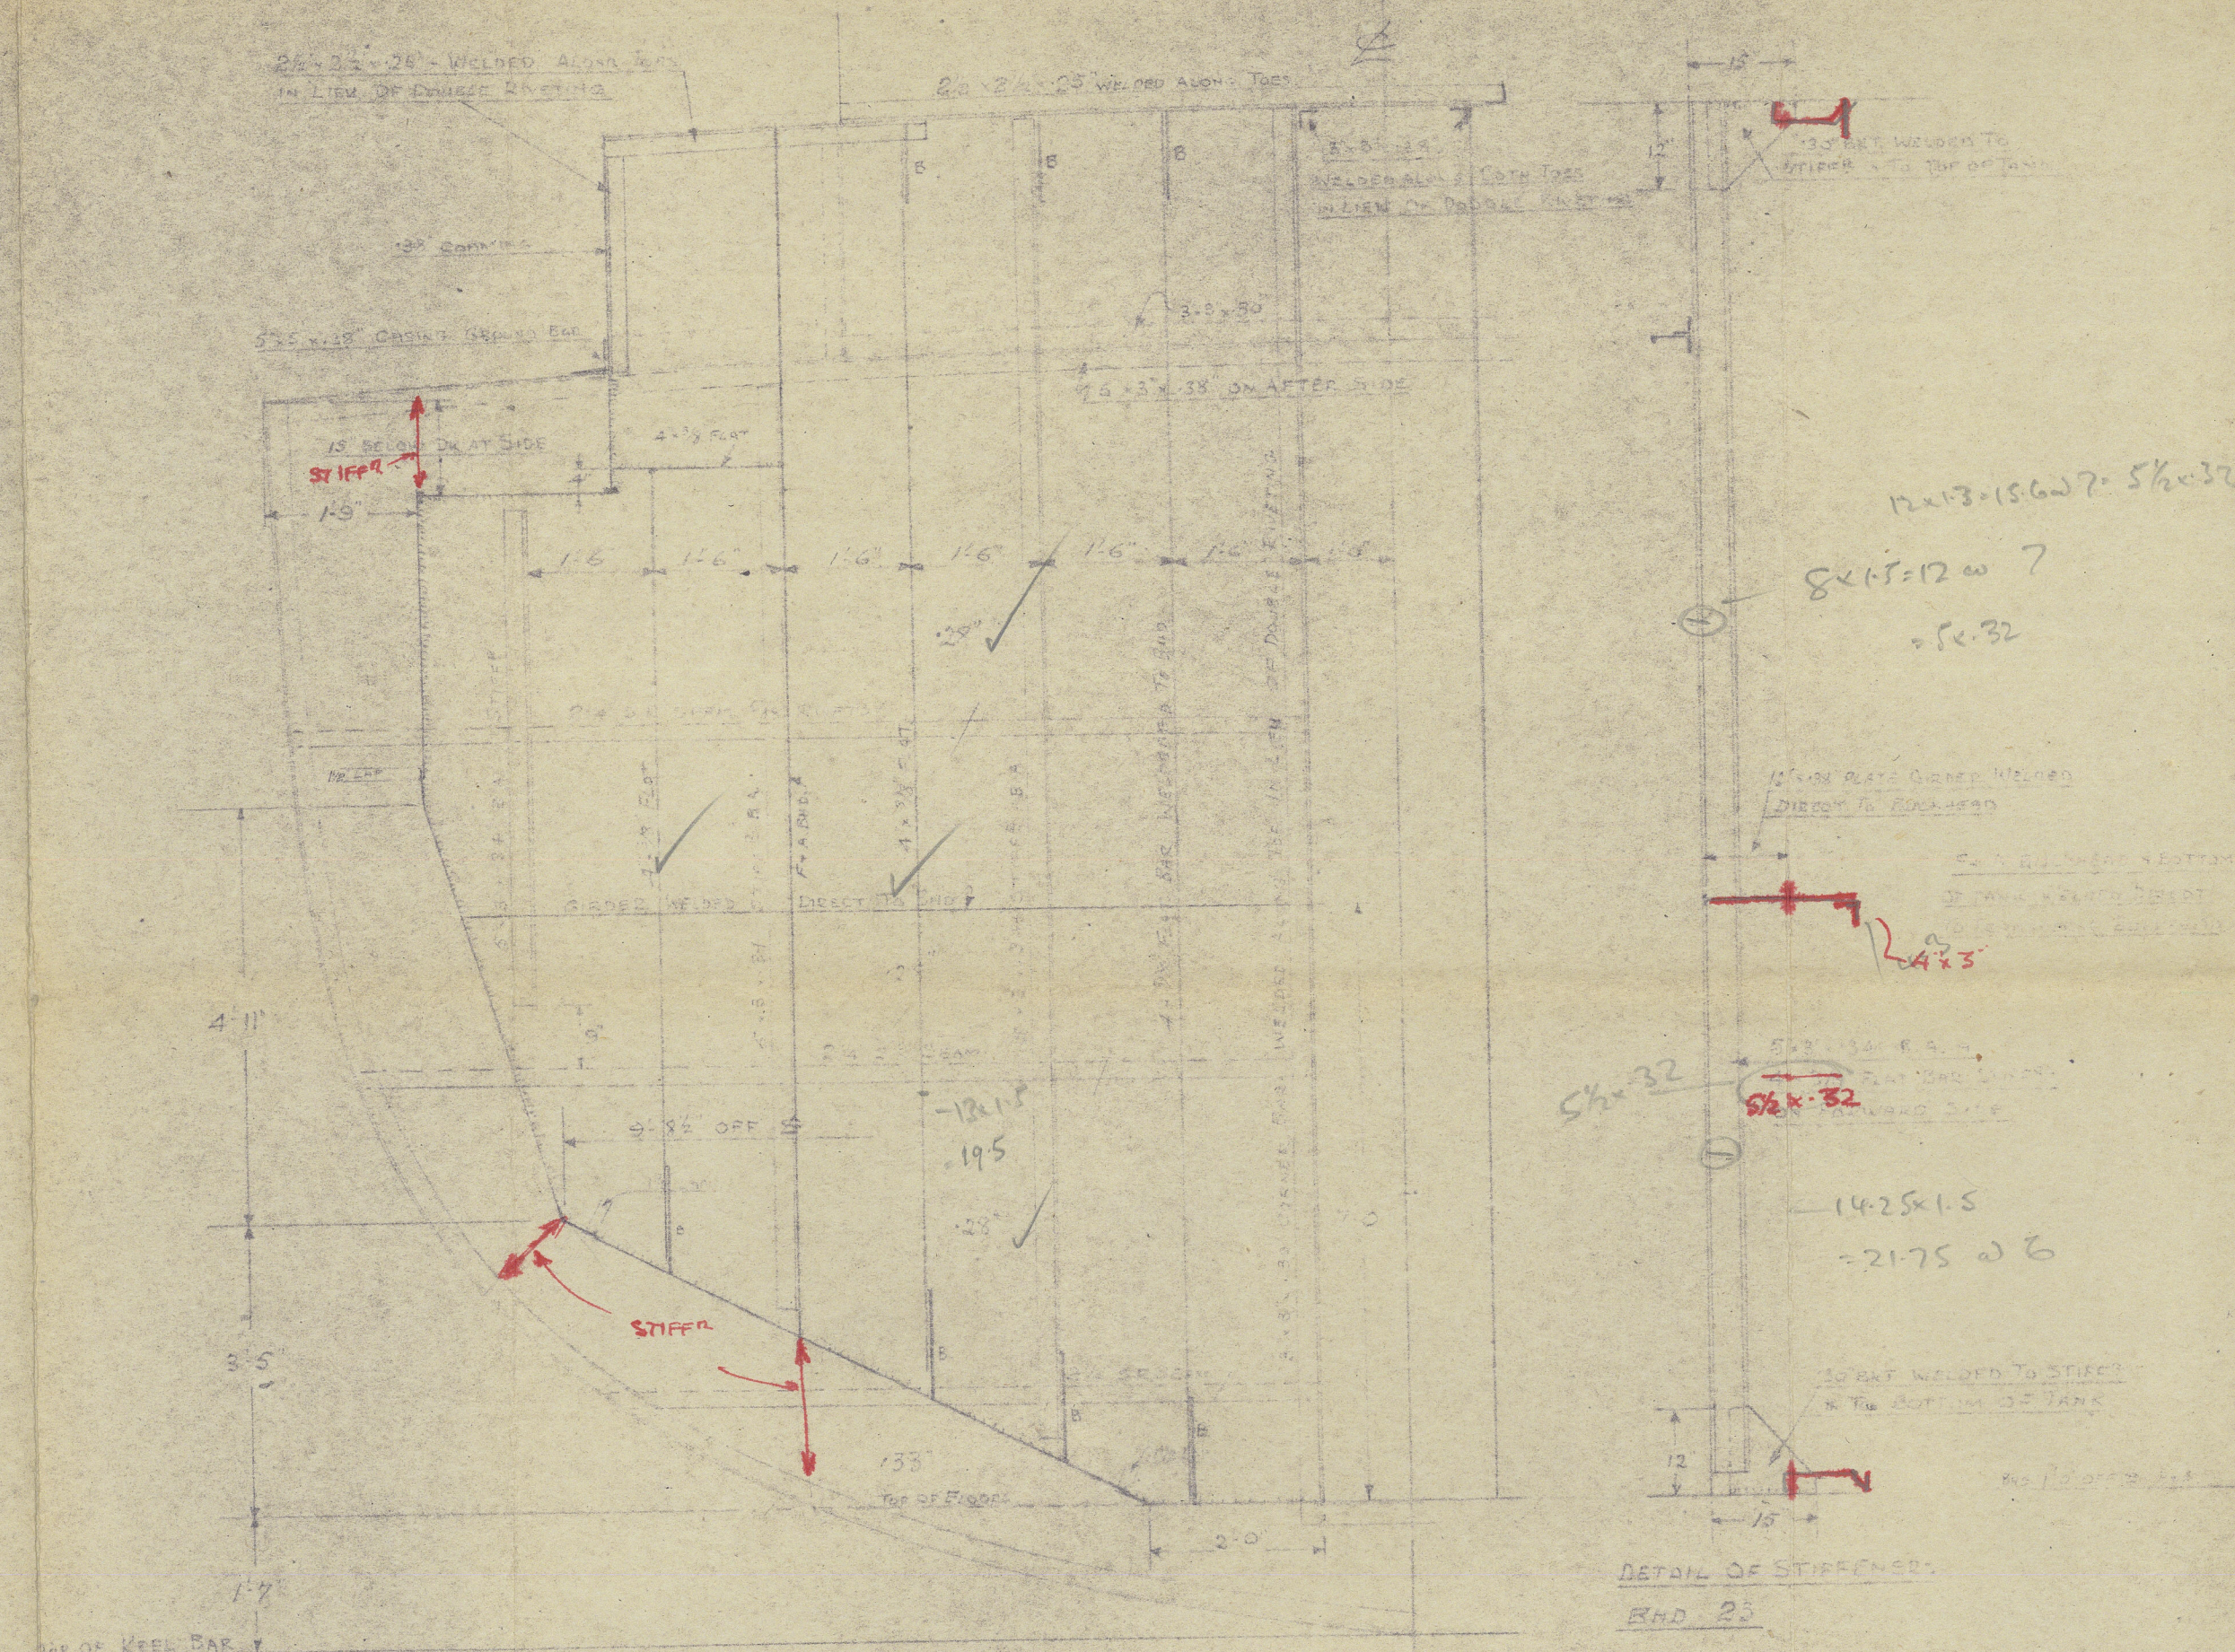



BULKHEAD FRAME B3
LOOKING AFT

NOTE: STIFFERS TO BE WELDED ALONG BOTH EDGES IN LINE OF OIL FUEL BUNKER
EXISTING STIFFENERS TO REMAIN AS SHOWN UNLESS OTHERWISE NOTED

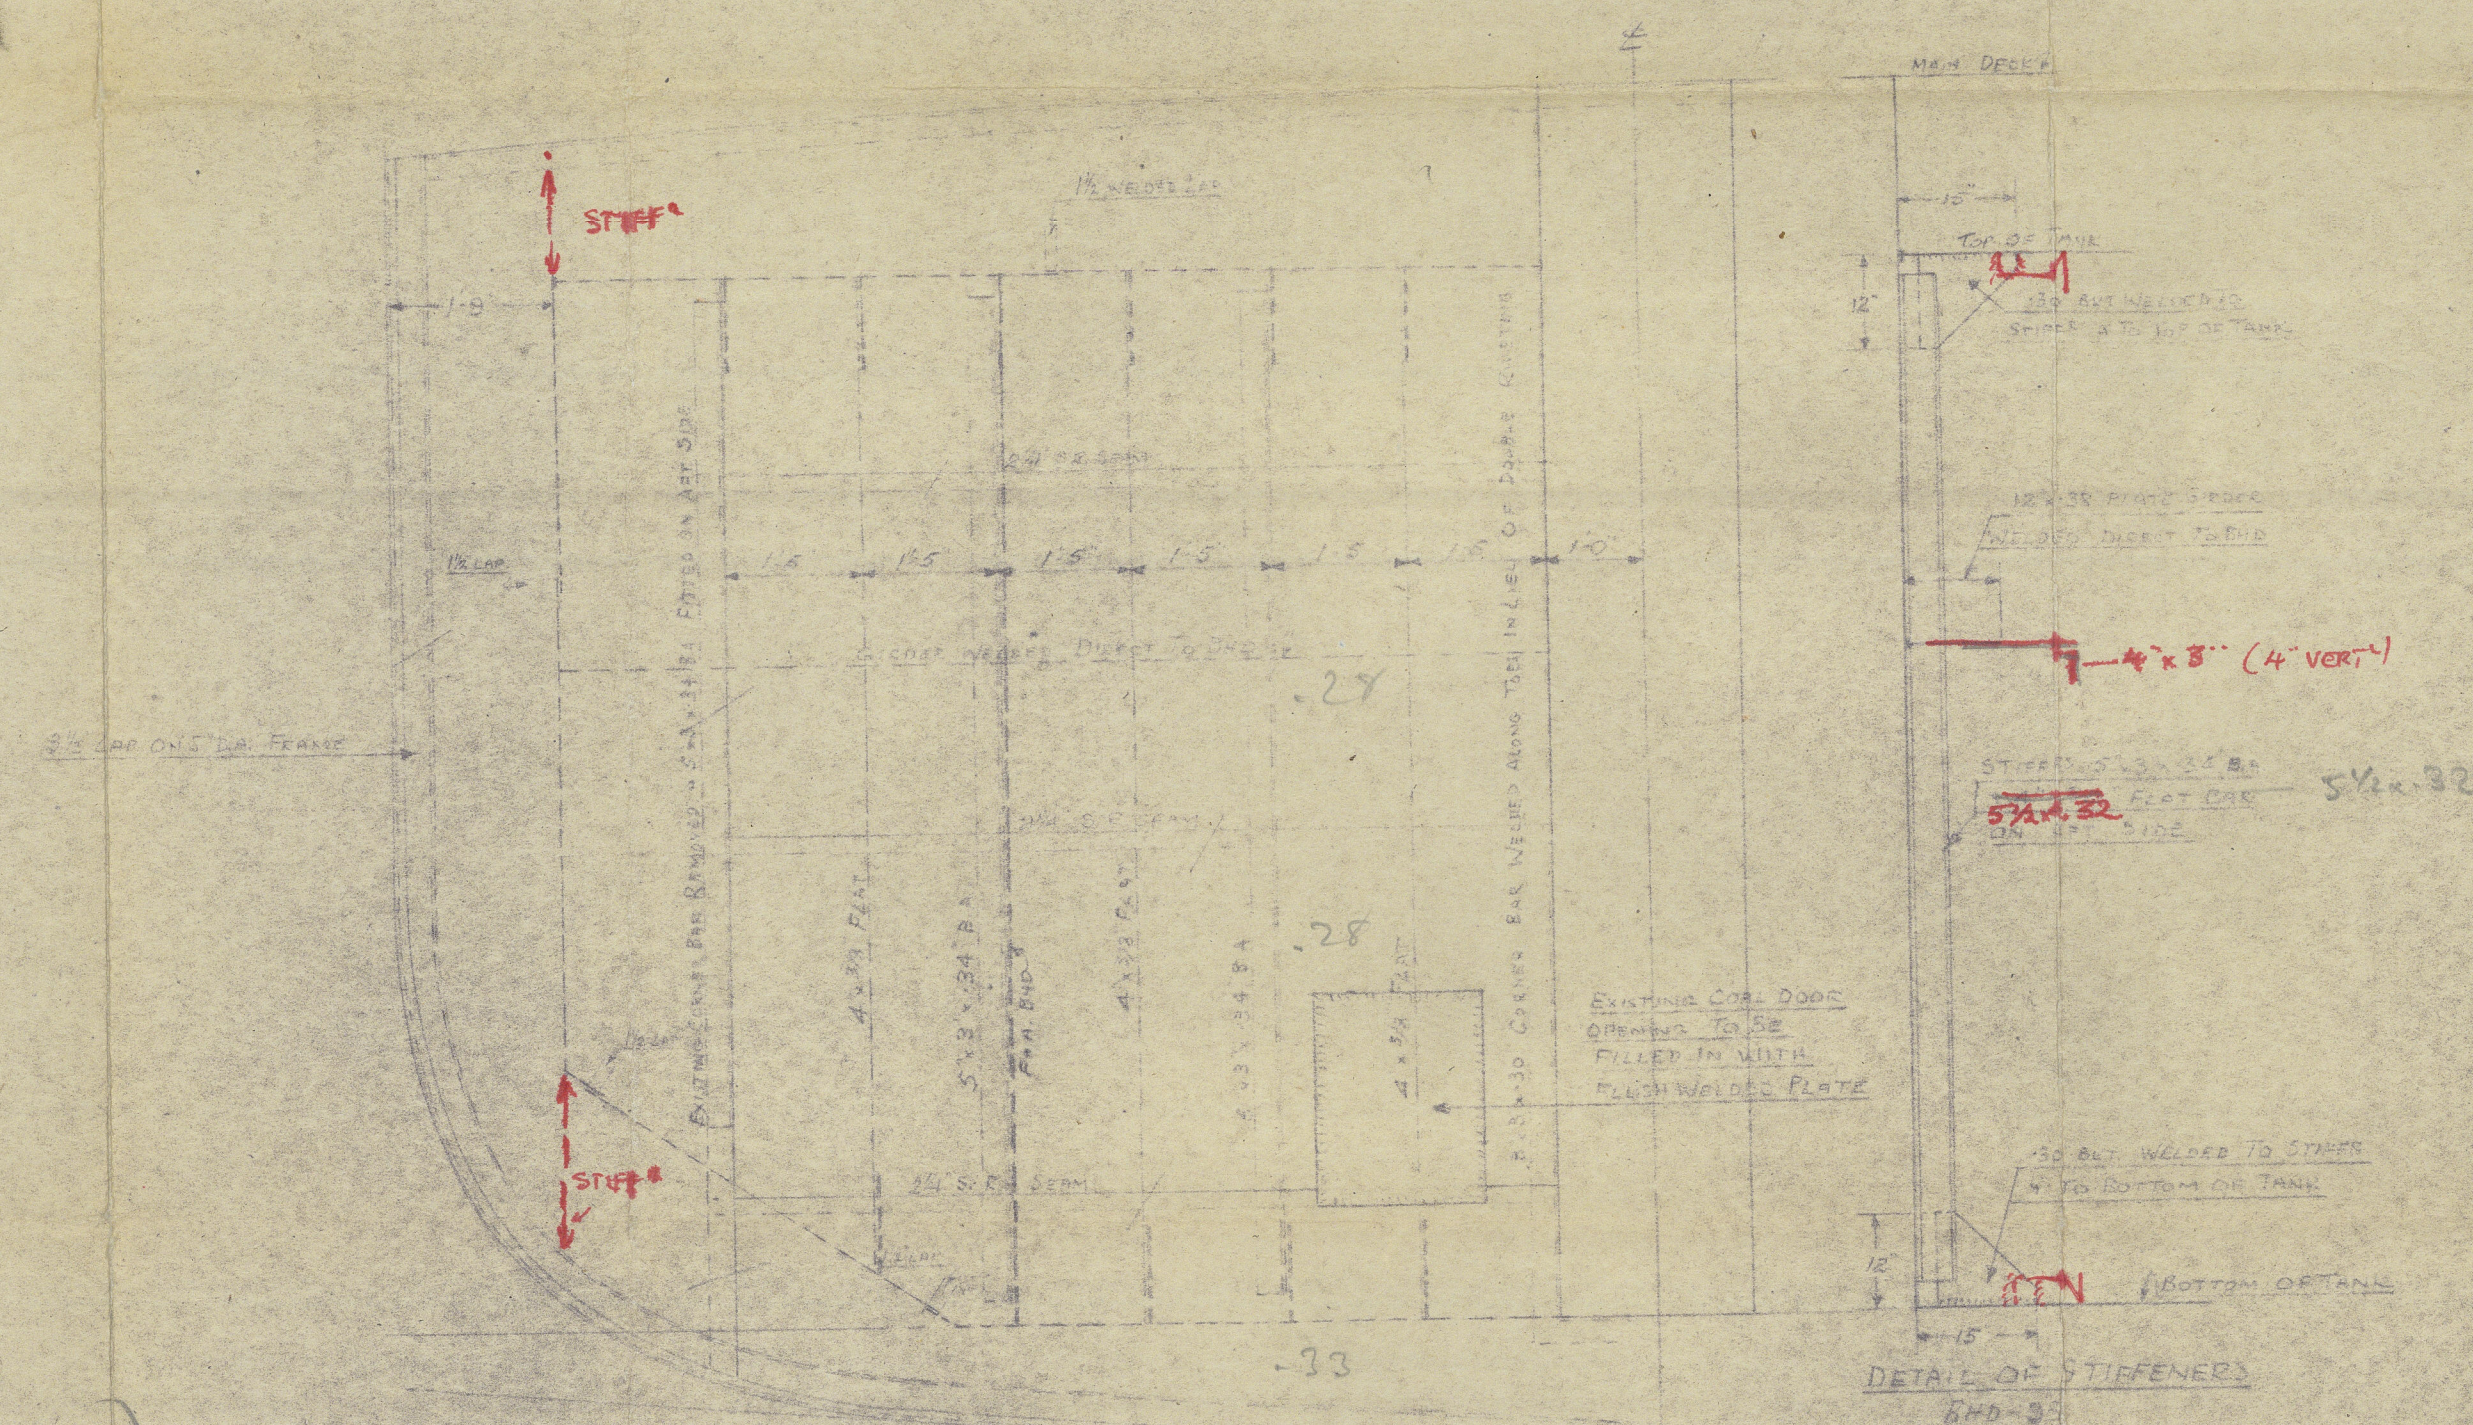

BULKHEAD FRAME B3
LOOKING AFT


NOTE: STIFFERS TO BE WELDED ALONG BOTH EDGES IN LINE OF OIL FUEL BUNKER
EXISTING STIFFENERS TO REMAIN AS SHOWN UNLESS OTHERWISE NOTED

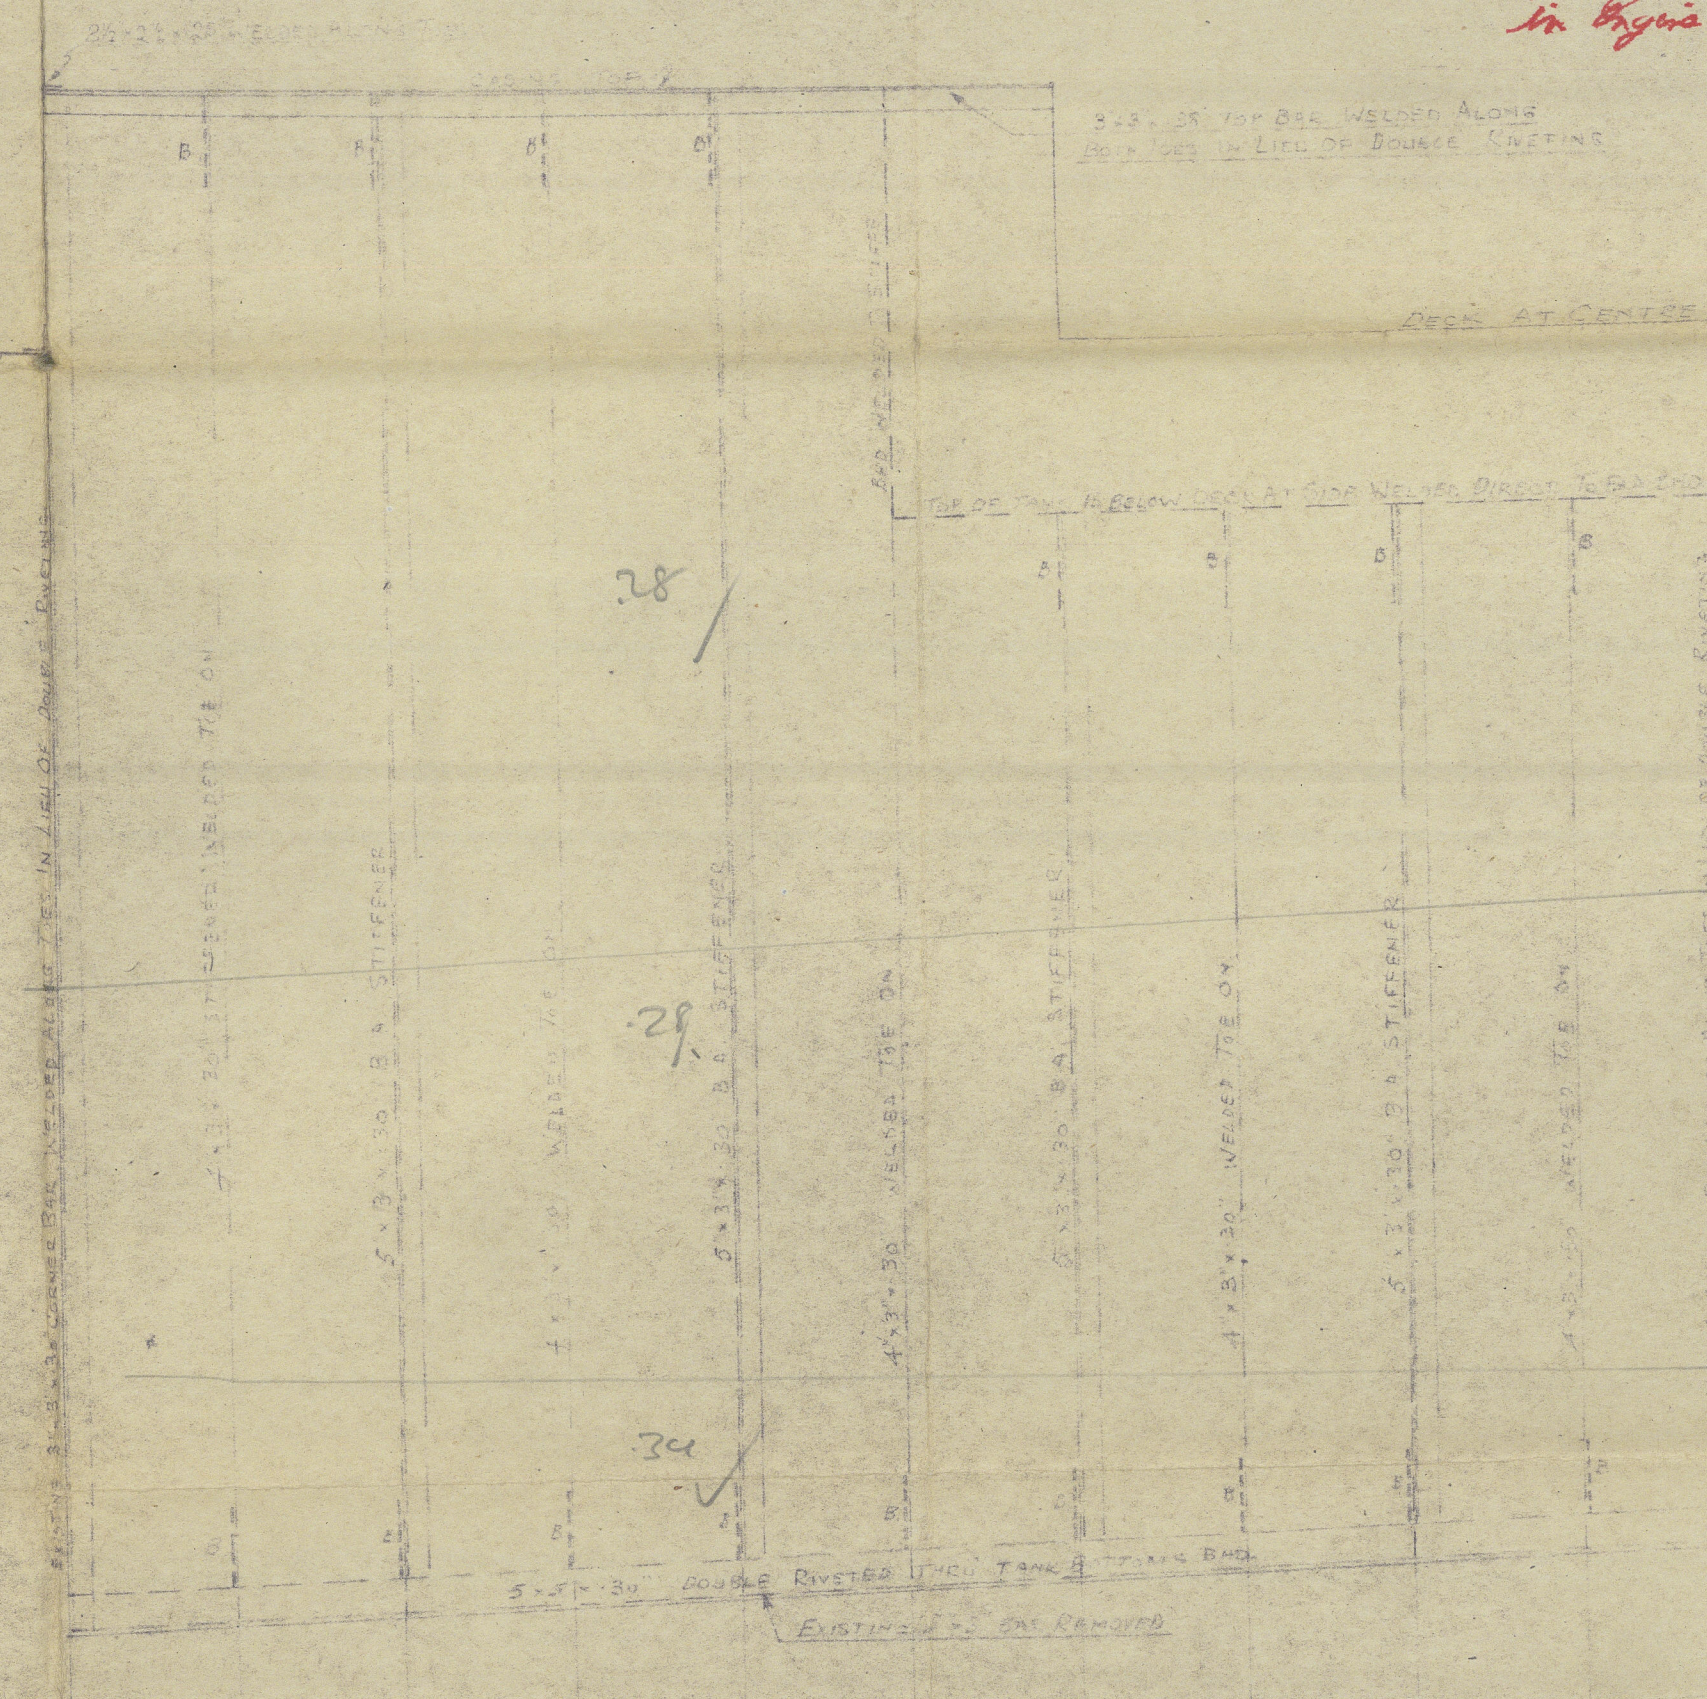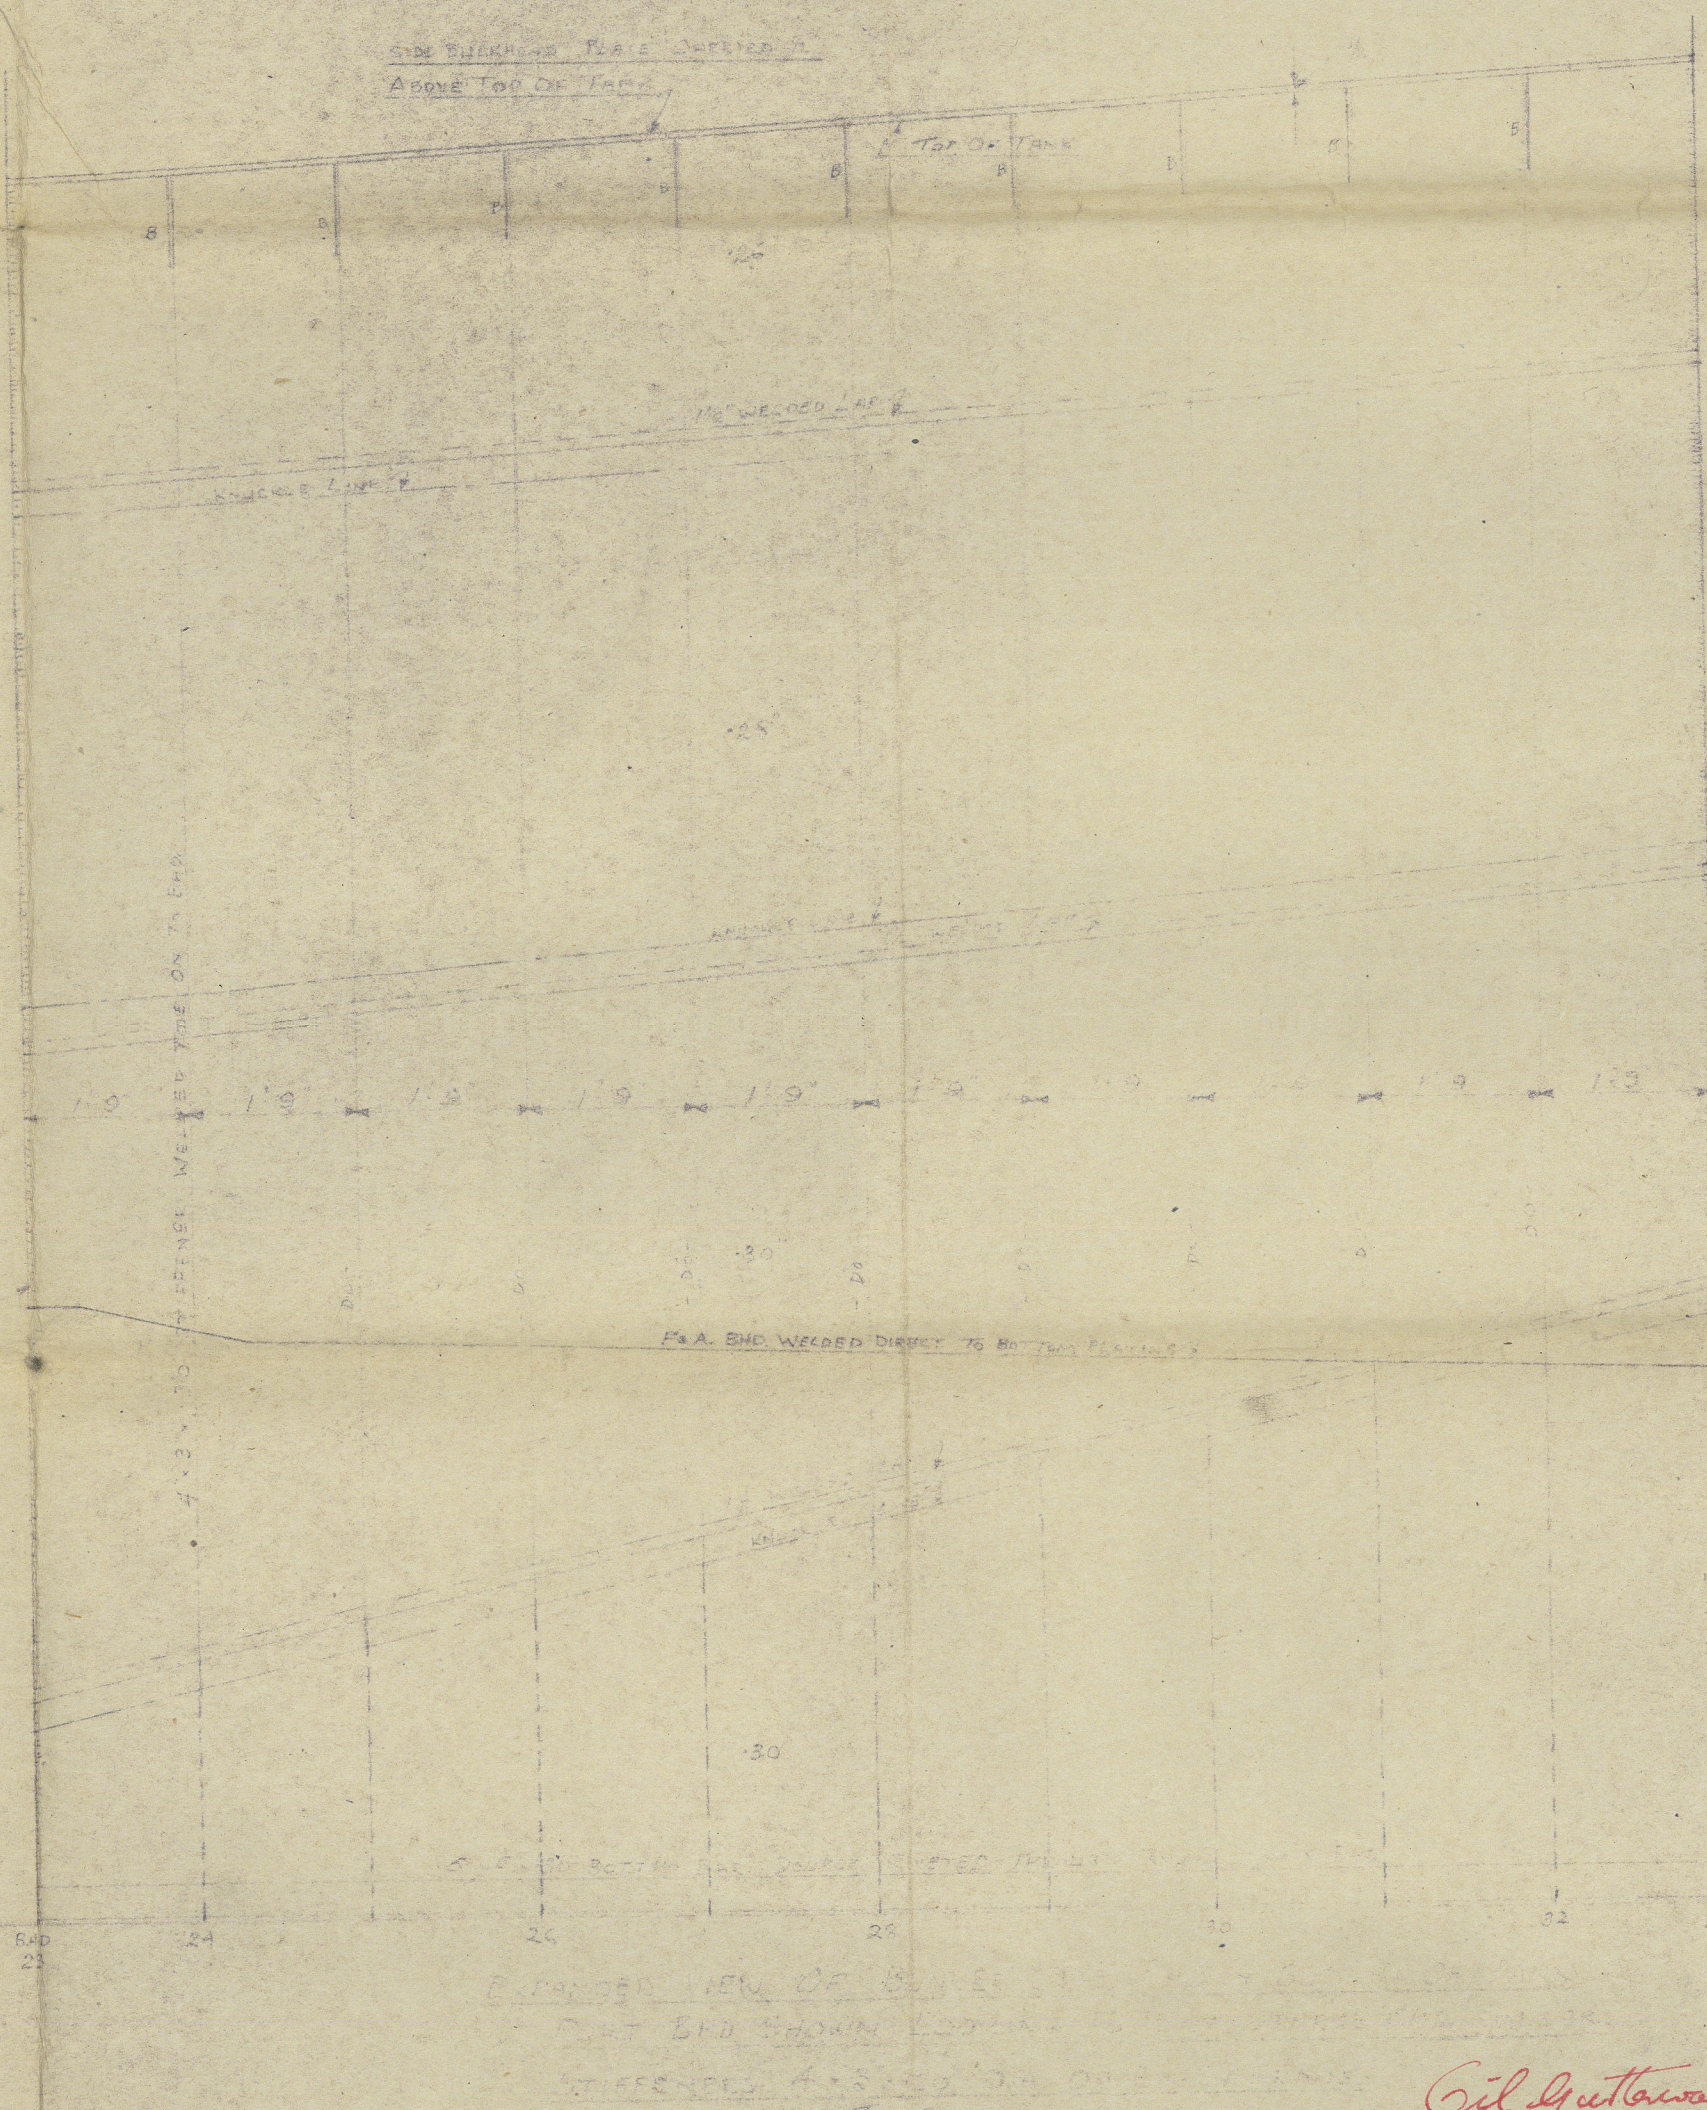

BULKHEAD FRAME B3
LOOKING AFT


NOTE: STIFFERS TO BE WELDED ALONG BOTH EDGES IN LINE OF OIL FUEL BUNKER
EXISTING STIFFENERS TO REMAIN AS SHOWN UNLESS OTHERWISE NOTED

*Oil Guttings, to be provided
in Engine + Boiler Rooms*

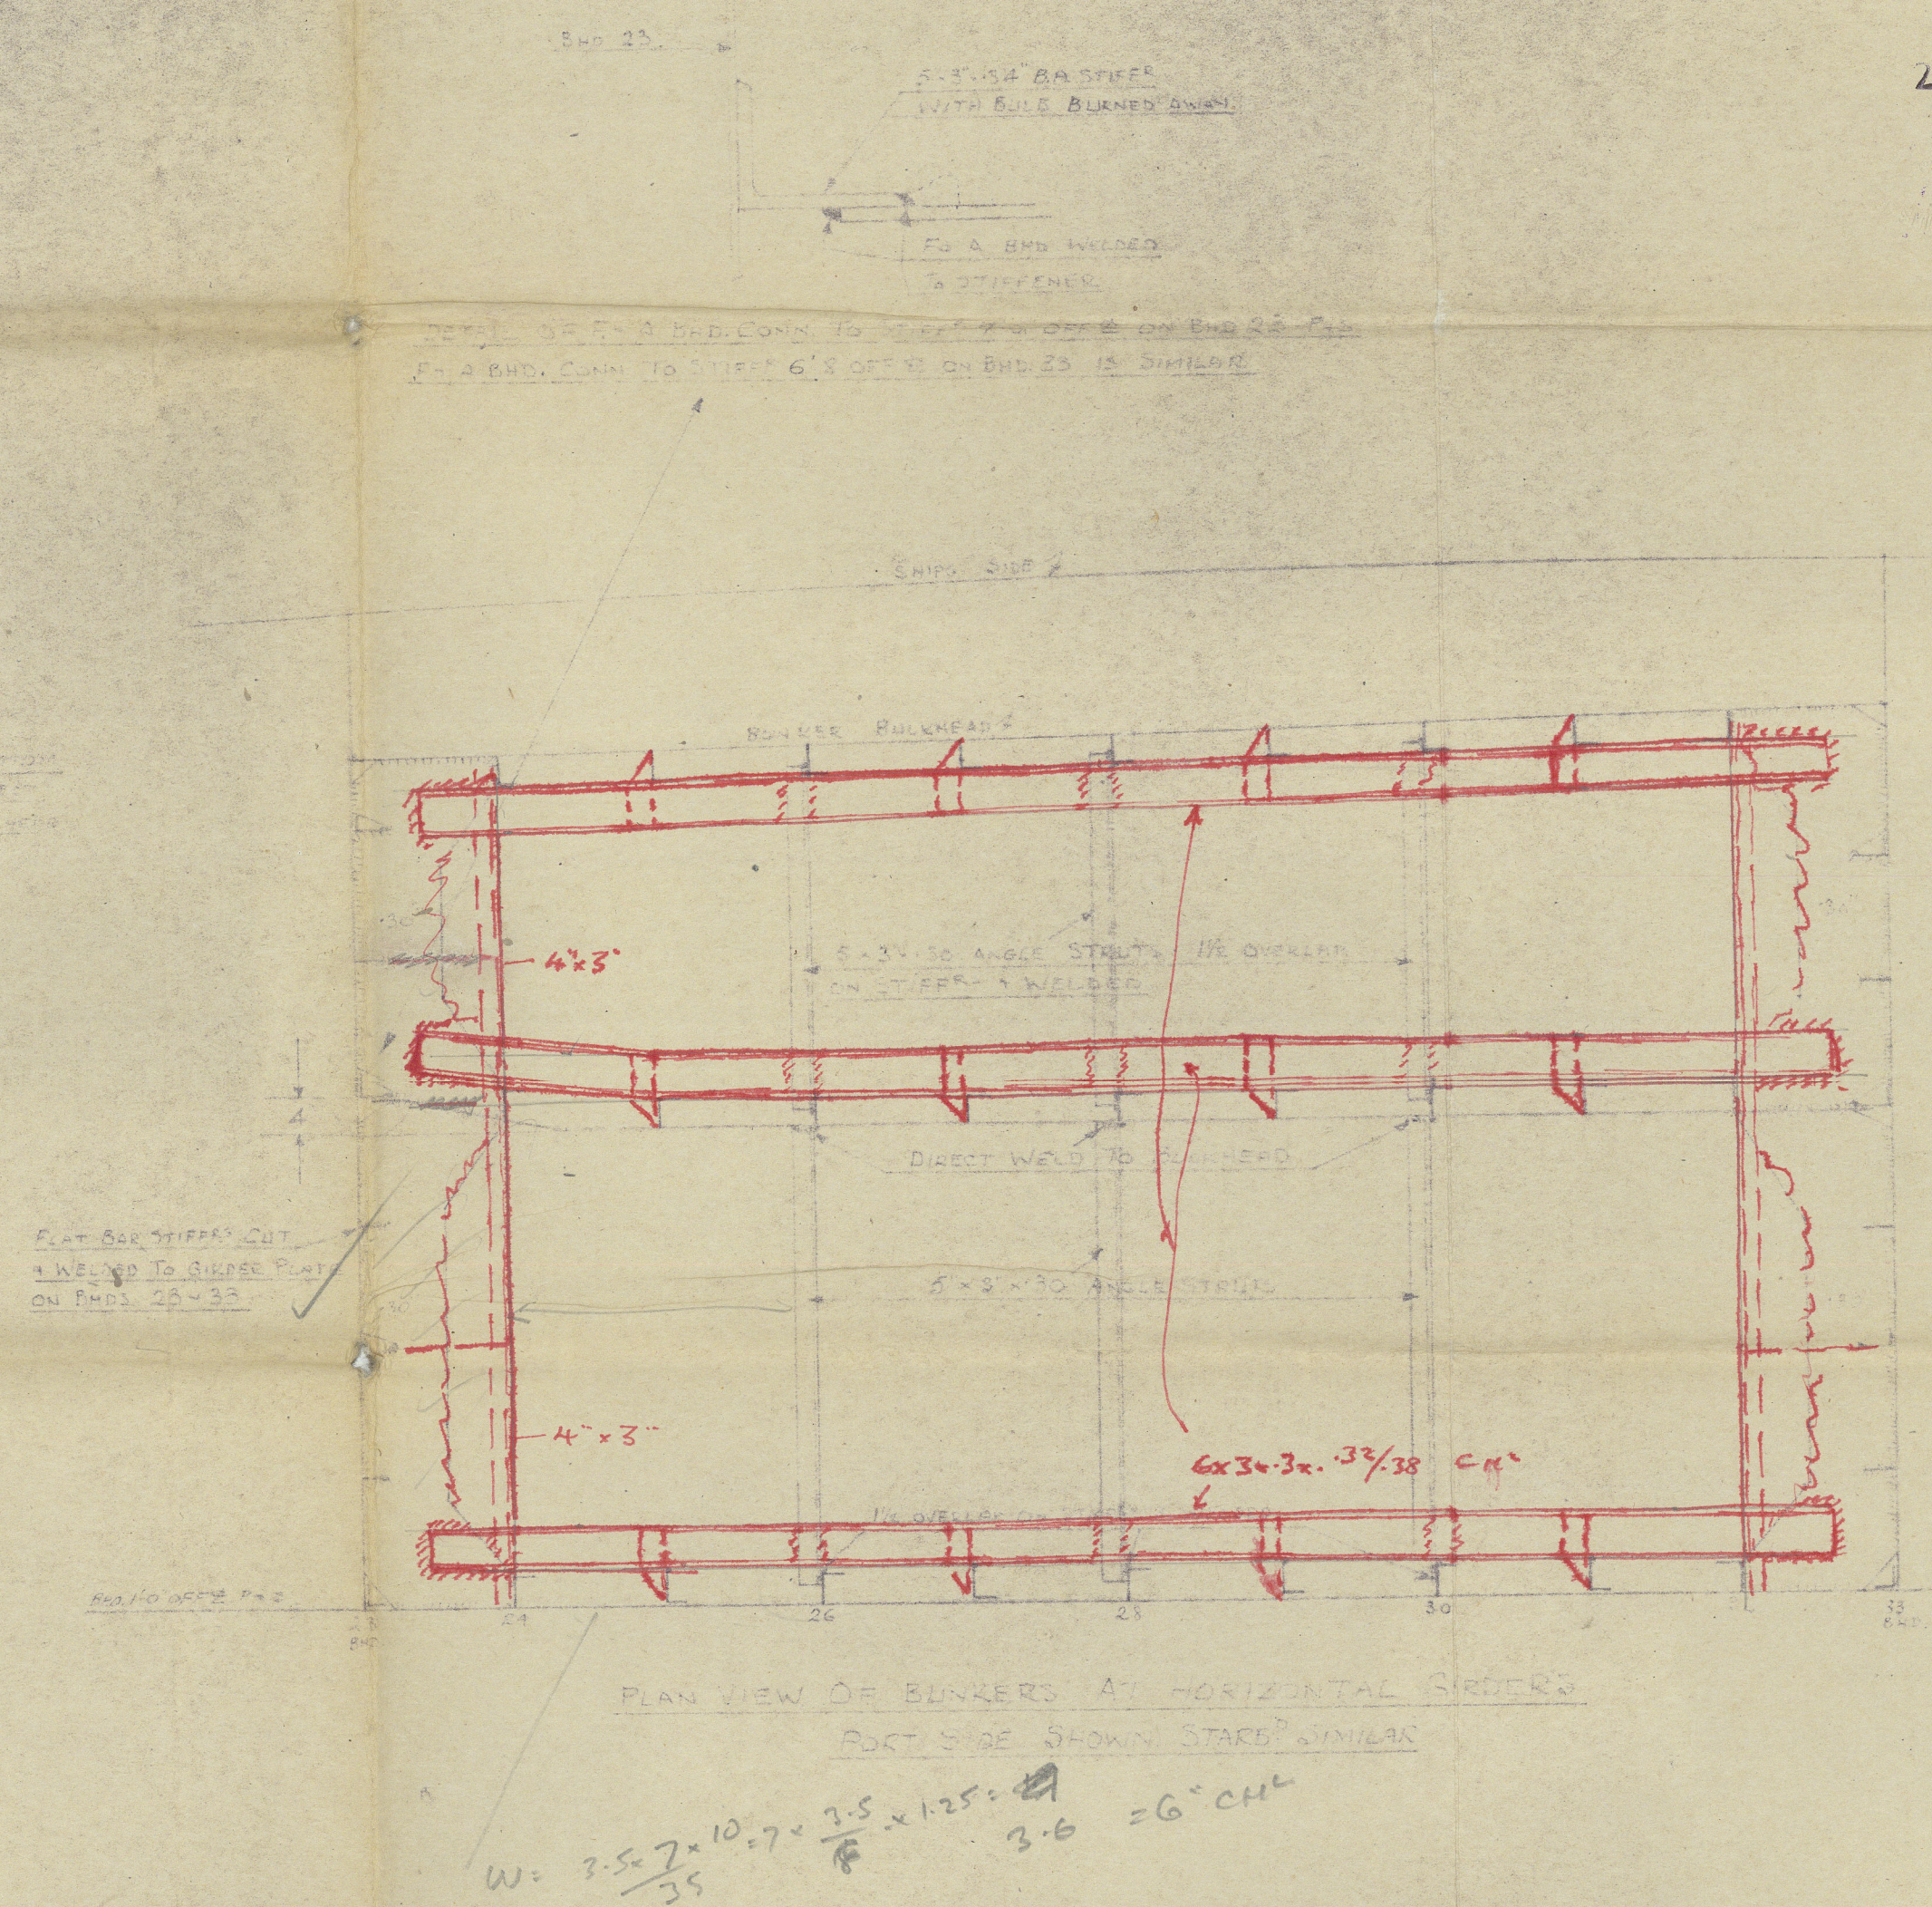

PLAN VIEW OF BUNKER AT HORIZONTAL SECTION
PORT END SHOWN START NUMBER

W. 3-5/8" x 10-7/8" x 3-5/8" x 1-1/2" = 3-6" CH

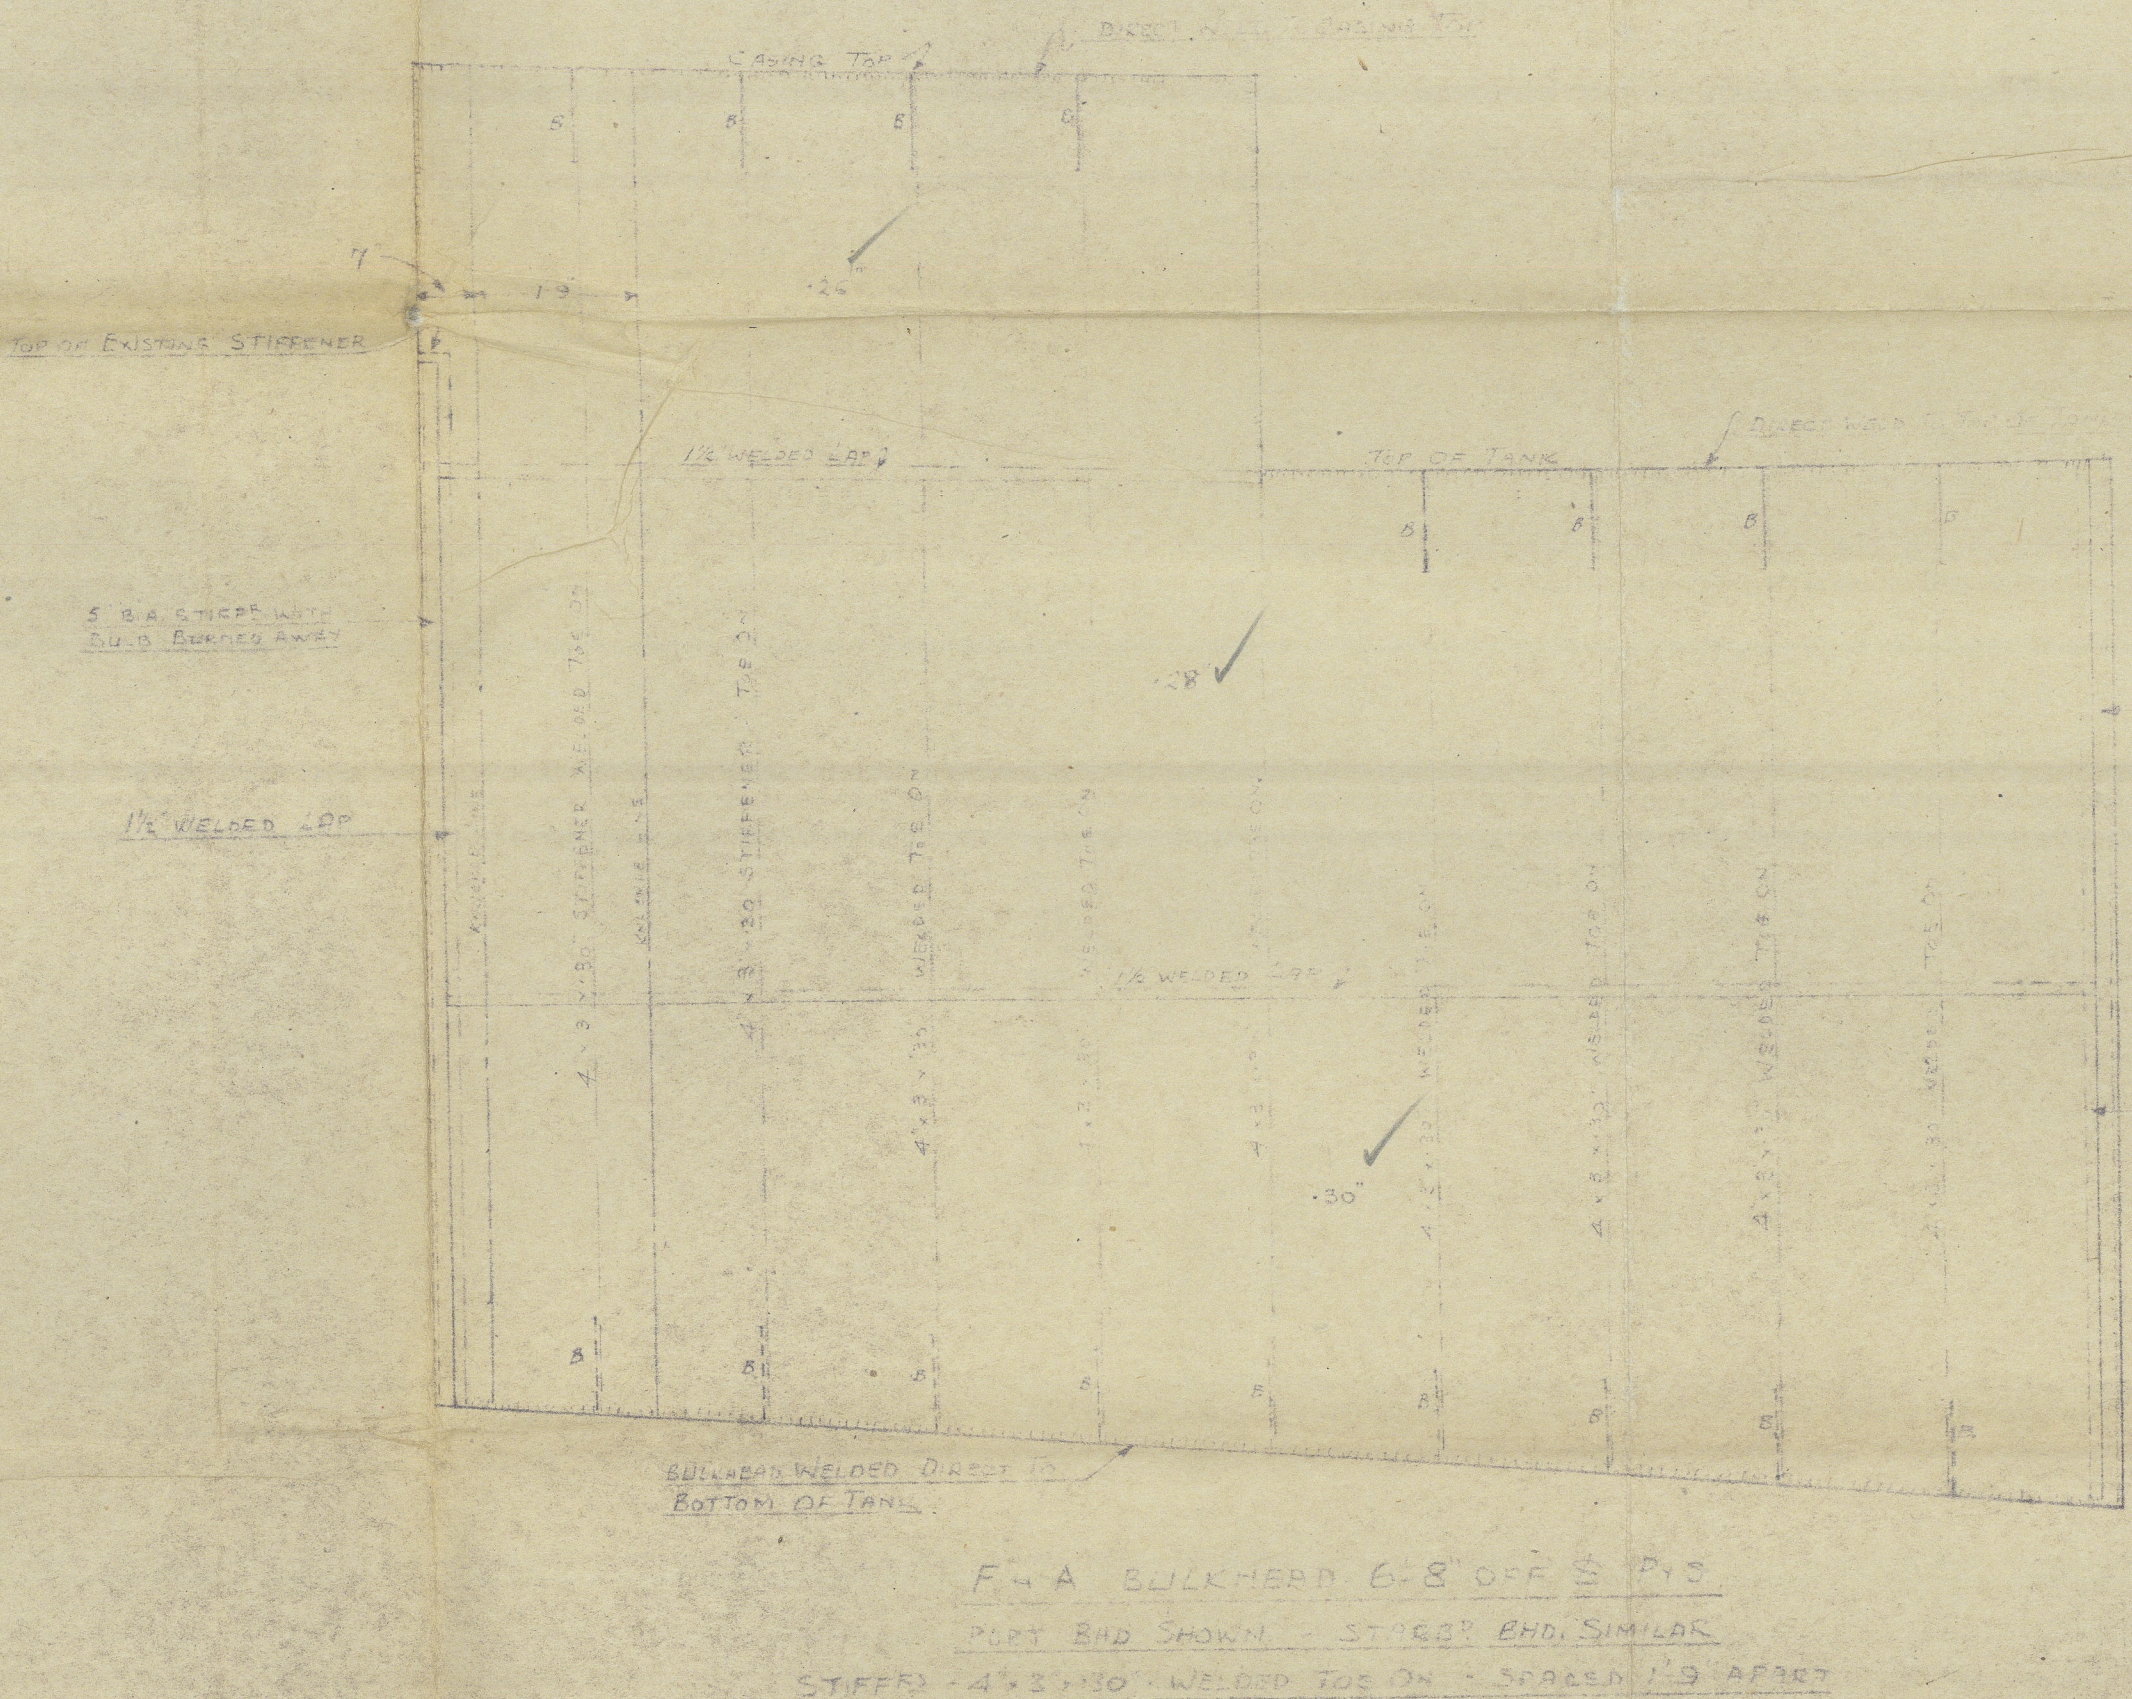

BULKHEAD FRAME B3
LOOKING AFT

NOTE: STIFFERS TO BE WELDED ALONG BOTH EDGES IN LINE OF OIL FUEL BUNKER
EXISTING STIFFENERS TO REMAIN AS SHOWN UNLESS OTHERWISE NOTED

24 SEP 1947

*Offshore
13.05
W. H. J. J.*

21

Oil Fuel Bunker Bhdz (Sheet 1)

Joe Lamont


8/2 FLYING SPITFIRE

12.10.47.

011032 - 011036 - 0188

24 SEP 1947

8/s Flying Spitfire

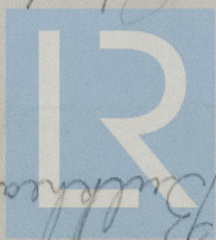

© 2021

Lloyd's Register
Foundation

Oil Fuel Bunker Bhdz (Sheet 1)