

LLOYD'S REGISTER OF SHIPPING

Index No.
(For London Office only.)

NOTE: DRAWN FOR 'OPEN' SH. DECK CONDITION WITH ALL PARTICULARS FOR 'CLOSED' SH. DECK CONDITION.

SURVEYS FOR FREEBOARD

(CONDITIONS OF ASSIGNMENT)


SPLIT RPT. NO 2390 F

Ship's Name **WIENIAWSKI**Port of Survey **SPLIT**

Official Number

Surveyor's Signature *Francis Lambie for J.G. LAMBIE & SELF*Nationality and Port of Registry **POLISH - GDYNIA**Date of Survey **WHILST BUILDING**

Disposition and dimensions of superstructures, trunks, deckhouses, machinery casings and wood sheathing to be inserted in the diagrams and tabular statement:—

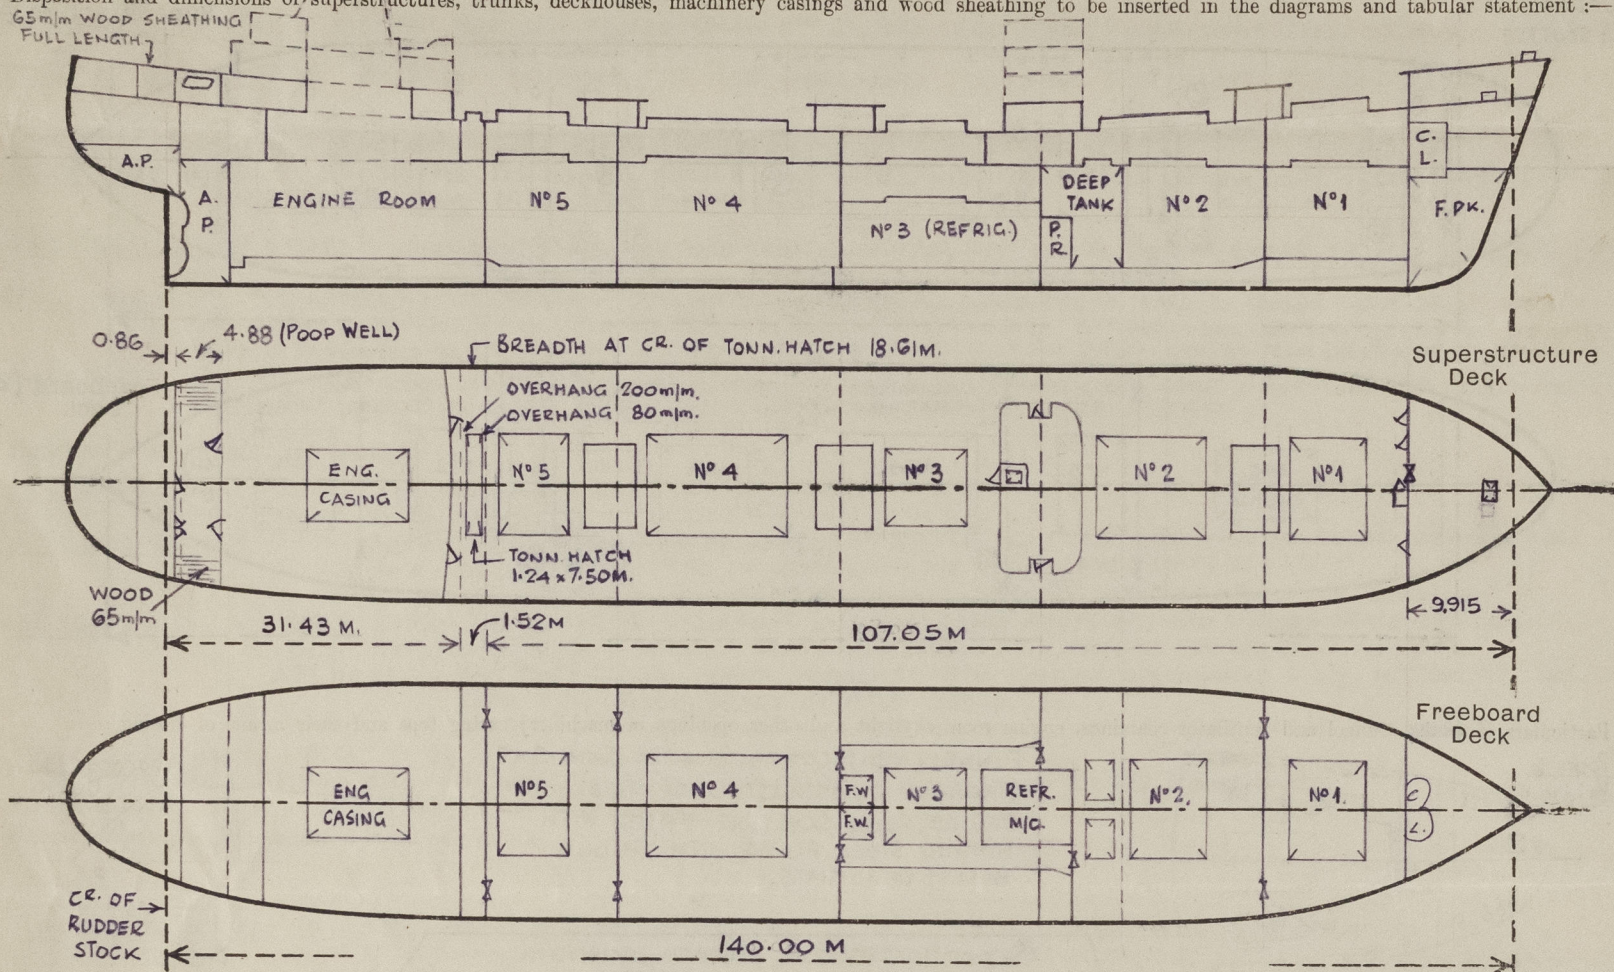

Particulars of Superstructures, Trunks, Casings, Deckhouses.

	Coaming	Plating m/m	Stiffeners	Spacing m/m	End Attachments of Stiffeners	Size of Openings m/m	Height of Sills m/m	Height, Beam to Beam m/m
Poop Bulkhead (IN POOP WELL).		7.5	90 x 90 x 10 I.A. 130 x 130 x 12 I.A.	600-660 900	SNIPED	1390 x 700 1390 x 1200	610 520	2500
Raised Quarter Deck Bulkhead ...								
AFT Bridge, After Bulkhead (SUPERIMPOSED)		7.5	140 x 9 B.P. 140 x 19 B.P.	725-760 900	SNIPED	1380 x 690 1380 x 800	610	2500
AFT Bridge, Forward Bulkhead (..-D-..)		11	220 x 11 B.P.	760 & 1100	TOP - BRACKET BOTTOM - WELD	2- 1380 x 690	610	2500
Forecastle Bulkhead (SUPERIMPOSED)		8	120 x 7.5 B.P. 200 x 10 B.P.	750 & 860	TOP - BRACKET BTM - SNIPED.	3- 1530 x 690 1- 1600 x 1490	460	2290
TONNAGE WELL BHP...		8.5-7	150 x 11 B.P. 130 x 90 x 11 I.A.	750 700	TOP - BRACKET BOTTOM - WELD	NONE	-	3235
TONNAGE WELL BHP...		8.5-7	152 x 8.4 B.P. 152 x 7.1 B.P.	750 700	TOP - BRACKET BOTTOM - WELD	2- 1280 x 980	610	3195
Exposed Machinery Casings on Freeboard or Raised Quarter Decks ...								
Exposed Machinery Casings on Superstructure Decks ...								
Machinery Casings within Superstructures fitted with Class I Closing Appliances ...		7	80 x 8 B.P.	760	TOP CONTINUOUS BOTTOM SNIPED	2- 1760 x 640	230	2500
Deckhouses and Pump Room Entrances (MIDSHIP)	FRONT SIDES	10	220 x 11 B.P.	760	TOP - BRACKET	NONE		
	AFT	9	140 x 8 B.P.	760	BTM - WELD	1520 x 680	460	2500
		8	120 x 7.5 B.P.	500 + 750	SNIPED	1380 x 1520 x 680		

Particulars of Closing Appliances (state if capable of being manipulated from both sides).

Poop Bulkhead (IN POOP WELL)...	HINGED DOUBLE STEEL DOOR, NOT OPERATED BOTH SIDES
TONNAGE WELL FORWARD BHP...	HINGED STEEL W.T. DOOR, OPERATED BOTH SIDES, 3 HINGES, 1 TOGGLE
Raised Quarter Deck Bulkhead ...	PORTABLE STEEL PLATES WITH HOOK BOLTS SPACED 305 mm.
AFT Bridge, After Bulkhead (SUPERIMPOSED)	HINGED (IN HALVES) WEATHERTIGHT STEEL DOOR, OPERATED BOTH SIDES. (D)
AFT Bridge, Forward Bulkhead (..-D-..)	HINGED W.T. STEEL DOOR, OPERATED BOTH SIDES, 3 HINGES, 3 TOGGLES. (C)
Forecastle Bulkhead (SUPERIMPOSED)	HINGED W.T. STEEL DOORS, OPERATED BOTH SIDES, 3 HINGES, 3 TOGGLES. (C)
Exposed Machinery Casings on Freeboard or Raised Quarter Decks ...	HINGED W.T. STEEL DOORS, OPERATED BOTH SIDES, 3 HINGES, 3 TOGGLES.
Exposed Machinery Casings on Superstructure Decks ...	STORM BOARD, 3" THICK, IN WELDED CHANNELS.
Machinery Casings within Superstructures fitted with Class I Closing Appliances ...	
Deckhouses and Pump Room Entrances (MIDSHIP)	HINGED STRONG STEEL DOORS, OPERATED BOTH SIDES, 3 HINGES, 1 TOGGLE.
	HINGED W.T. STEEL DOORS, OPERATED BOTH SIDES, 3 HINGES, 2 OR 3 TOGGLES.

PARTICULARS OF PROTECTION TO OPENINGS, ETC.

HATCHWAYS ON FREEBOARD AND SUPERSTRUCTURE DECKS.										
2ND DECK * SHELTER DECK										
Description of Hatchway	Nº1	Nº2	Nº3	Nº4	Nº5	Nº1	Nº2	Nº3	Nº4	Nº5
Dimensions of Hatchway ..(metres) ...	CARGO	CARGO	REFRIG. CARGO.	CARGO	CARGO	CARGO	CARGO	REFRIG. CARGO.	CARGO	CARGO
	8.208 x 7.50	8.348 x 7.50	8.348 x 5.80	15.188 x 7.50	8.348 x 7.50	8.208 x 7.50	12.148 x 7.50	8.348 x 6.00	15.188 x 7.50	8.348 x 7.50
COAMINGS	Height above Deck m/m..	230	230	230	230	230	1100	1050	1050	1050
	Thickness { Sides m/m..	12	12	12	12	12	12	12	12	12
	{ Ends m/m..	12	12	12	12	12	12	12	12	12
	Stiffeners ... { Sides ...	-	-	-	-	-	STIFFERS: SIDES	300x14 H.P., ENDS	230 x 12 H.P.	230 x 12 H.P.
	Brackets, Stays { Ends ...	-	-	-	-	-	BKTS : 12mm THICK, FLANGED 90mm	THICK, FLANGED 90mm	230 x 12 H.P.	230 x 12 H.P.
HATCH BEAMS	Number	3	3	3	6	3	3	3	3	3
	Spacing ... m/m ...	2095	2130	2130	2194	2130	2130	2130	2130	2130
	Scantling and Sketch									
	Bearing Surface ... m/m.	135	135	150	135	135	135	135	135	135
FORE AND AFTERS	Number									
	Spacing									
	Unsupported Lengths ...									
	Scantling* and Sketch ...									
	Bearing Surface									
HATCH COVERS	Material	WOOD	WOOD	WOOD	WOOD	WOOD	ALL MACGREGOR HATCH COVERS AS PER	ALL MACGREGOR HATCH COVERS AS PER	ALL MACGREGOR HATCH COVERS AS PER	ALL MACGREGOR HATCH COVERS AS PER
	Thickness ... m/m ...	125	110	110	110	110	APPROVED PLANS. SPACING OF CROSS JOINT	APPROVED PLANS. SPACING OF CROSS JOINT	APPROVED PLANS. SPACING OF CROSS JOINT	APPROVED PLANS. SPACING OF CROSS JOINT
	How fitted	F&A	F&A	F&A	F&A	F&A	WEDGES 1200mm MAX., SPACING OF CLEATS	WEDGES 1200mm MAX., SPACING OF CLEATS	WEDGES 1200mm MAX., SPACING OF CLEATS	WEDGES 1200mm MAX., SPACING OF CLEATS
	Bearing Surface ... m/m ...	90	90	90	90	90	MAX., FITTED WITH RUBBER PACKING.	MAX., FITTED WITH RUBBER PACKING.	MAX., FITTED WITH RUBBER PACKING.	MAX., FITTED WITH RUBBER PACKING.
Spacing of Cleats m/m ...	570	595	555	575	575					
Number of Tarpaulins... ..	1	1	1	1	1					
<p>*Are wood fore and afters steel shod at all bearing surfaces ?</p> <p>Are battens and wedges efficient and in good condition ?</p> <p>Are tarpaulins in good condition and in accordance with rule requirements ?</p> <p>Are lashings provided in accordance with rule requirements ?</p> <p>Are wood covers fitted with galvanised end bands ?</p>										
			NONE.	YES.	YES.	YES.	YES.	YES.	YES.	YES.

Particulars of any special features :— (Timber Deck-cargo Fittings, Skylights, Sewage Systems, Ash Ejectors, Rubbish Shoots, etc.)

HATCHES (CONTINUED)

- ACCESS HATCH ON FORECASTLE DECK :- 1000 x 1000 mm, COAMING 610 x 11 mm, 7mm STEEL HINGED W.T. COVER, 2 HINGES, 8 TOGGLES, RUBBER PACKING.
- ACCESS HATCH ON SHELTER DECK IN FORECASTLE :- 1000 x 1000 mm, COAMING 460 x 11 mm, 7mm STEEL HINGED W.T. COVER, 2 HINGES, 8 TOGGLES, RUBBER PACKING.
- TONNAGE HATCH ON SHELTER DECK :- 1240 x 7500 mm, COAMING 280 x 12.9 mm, WOOD COVERS 75mm THICK FITTED F&A, BEARING SURFACE 80mm, SECURED BY HEMP LASHINGS UNDERNEATH.
- HATCH ON SHELTER DECK IN POOP WELL :- 1200 x 1800 mm, COAMING 610 x 10 mm, WITH 180x10 B.P. STIFFENER AND 10mm BRACKETS (1 EACH SIDE, 2 EACH END). WOOD COVERS 75mm THICK FITTED F&A, BEARING SURFACE 75mm, CLEATS SPACED 530 & 450mm, 3 TARPULINS.
- HATCH ON POOP DECK TO POOP WELL :- 1200 x 1800 mm, COAMING 460 x 10 mm, WITH 180 x 10 B.P. STIFFENER. WOOD COVERS 65mm THICK, FITTED F&A, BEARING SURFACE 80mm, CLEATS 500mm APART, 1 TARPULIN.
- HATCH ON POOP DECK TO STORE :- 600 x 600 mm, COAMING 460 x 11 mm, 7mm STEEL HINGED W.T. COVER, 2 HINGES, 2 TOGGLES, RUBBER PACKING.
- DEEP TANK HATCHES ON 2ND DECK :- 2 OFF, 3010 x 3200 mm, COAMING 230 x 12 mm, 13 mm STEEL W.T. COVERS STIFFENED BY 3-180 x 10mm TRANSVERSE BULB PLATES & 3-150 x 10 F&A. INTERCOSTAL BULB PLATES. 36 OFF, 32mm DIA. TOGGLES, RUBBER PACKING. MANHOLE IN EACH COVER 380 x 500mm, WATERTIGHT.
- TRIMMING HATCHES ON 2ND DECK :- 4 OFF, 730 x 940 mm, FLUSH, 10mm STEEL W.T. COVER, 2 HINGES, 14-20mm DIA. BOLTS, RUBBER PACKING.
- HATCH ON 3RD DECK TO REFRIG. HOLD :- 8348 x 5800 mm, FLUSH. 3 HATCH BEAMS ACCORDING TO SKETCH ABOVE: (D) 500 x 30 mm, (A) 250 x 25 mm, BEARING SURFACE 145mm. INSULATED WOOD COVERS 250mm THICK FITTED F&A, BEARING SURFACE 75mm.
- (H) HATCH ON 2ND DECK TO REFRIG HOLD :- ENCLOSED IN TRUNK IN TWEEN DECK WITH HINGED STEEL W.T. DOOR 1530 x 600 mm, 7mm THK, SILL 360mm, 3 HINGES, 3 TOGGLES, RUBBER PACKING. ACCESS HATCH 15 700 x 700 mm FLUSH, WITH INSULATED WOOD COVERS 250mm THK, 2 HINGES, 1 TOGGLE.
- GALLEY SKYLIGHT ON POOP DECK. 630 x 5300 mm, COAMING 8mm, ADJACENT TO BRIDGE AFT DECKHOUSE. 7-450 x 600 mm. HINGED STEEL W.T. COVERS EACH WITH 400 x 200 mm FIXED LIGHT PROTECTED BY STEEL BARS & 4mm HINGED STEEL COVER. 2 HINGES, 2 TOGGLES, RUBBER PACKING. SILL (TO HINGED COVER) 500mm.

FOR CLOSED SHELTER DECK CONDITION

- TONNAGE OPENING ON SHELTER DECK CLOSED W.T. BY 11mm STEEL COVER IN 2 HALVES, STIFFENED BY 130 x 90 x 9 I.A. & 5-100 x 10 mm INTERCOSTALS ON EACH COVER. COVERS FASTENED WITH 17-20mm DIA. SPECIAL HOOK BOLTS SPACED 550mm APART, WITH RUBBER PACKING. ACCESS MANHOLE 600 x 400 mm FLUSH WITH COVER, RUBBER PACKING.
- TONNAGE OPENINGS IN TWEEN DECK BULKHEADS CLOSED W.T. WITH PORTABLE STEEL PLATES 7mm THICK, WITH 22mm DIA HOOK BOLTS 152mm APART AND RUBBER PACKING.