
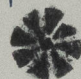
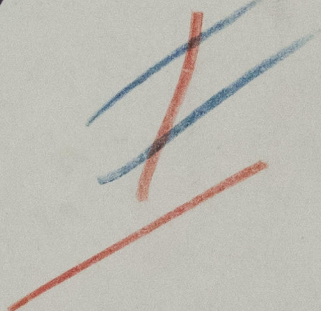
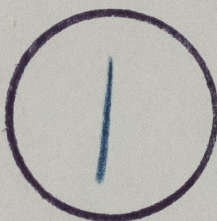


HARLAND & WOLFF LTD.
BELFAST

No. 1308/9
TITLE Midship Section
"as built"
DATE APPROVED.....

Belfast Rpt No 14187 - Lyra - No 1308

"LYRIA"  



011047-011056-0001



© 2021

Lloyd's Register
Foundation