

Lloyd's Register of Shipping.

5-1 FEB 1947


Ship's Name **S.S. "HRVATSKA"**

Official No.

Memorandum of alterations reported since ship was surveyed for assignment of Load Lines in **Split on 3rd October, 1946 (Spt. Rpt. No. 1026)**

A 3rd Class accommodation has now been made at forward end of Hold. Three new side scuttles each side were now fitted with hinged dead lights. Lower edge of lowest side scuttle is 16 1/2 inches above Summer Water Line and 53.04 feet forward of amidships.

Gmajer

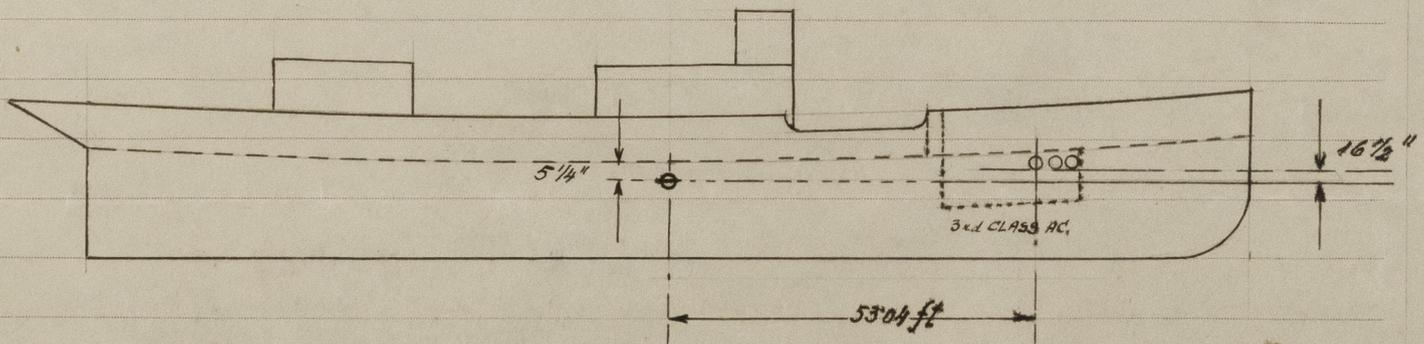

Noted
3- FEB 1947
Ey



© 2021

Lloyd's Register Foundation