

ROBERT THOMPSON & SONS,  
IRON AND STEEL SHIPBUILDERS  
AND REPAIRERS,  
SOUTHWICK YARD & BRIDGE DOCKYARD,  
DUNDEE, ABERDEEN.



321.99

Amended 29/12/98  
BEAM ARRANGEMENT

S.S. 208

SCALE 1/4" = ONE FOOT

ROBERT THOMPSON & SONS,  
IRON AND STEEL SHIPBUILDERS  
AND REPAIRERS,  
SOUTHWICK YARD & BRIDGE DOCKYARD,  
DUNDEE, ABERDEEN.

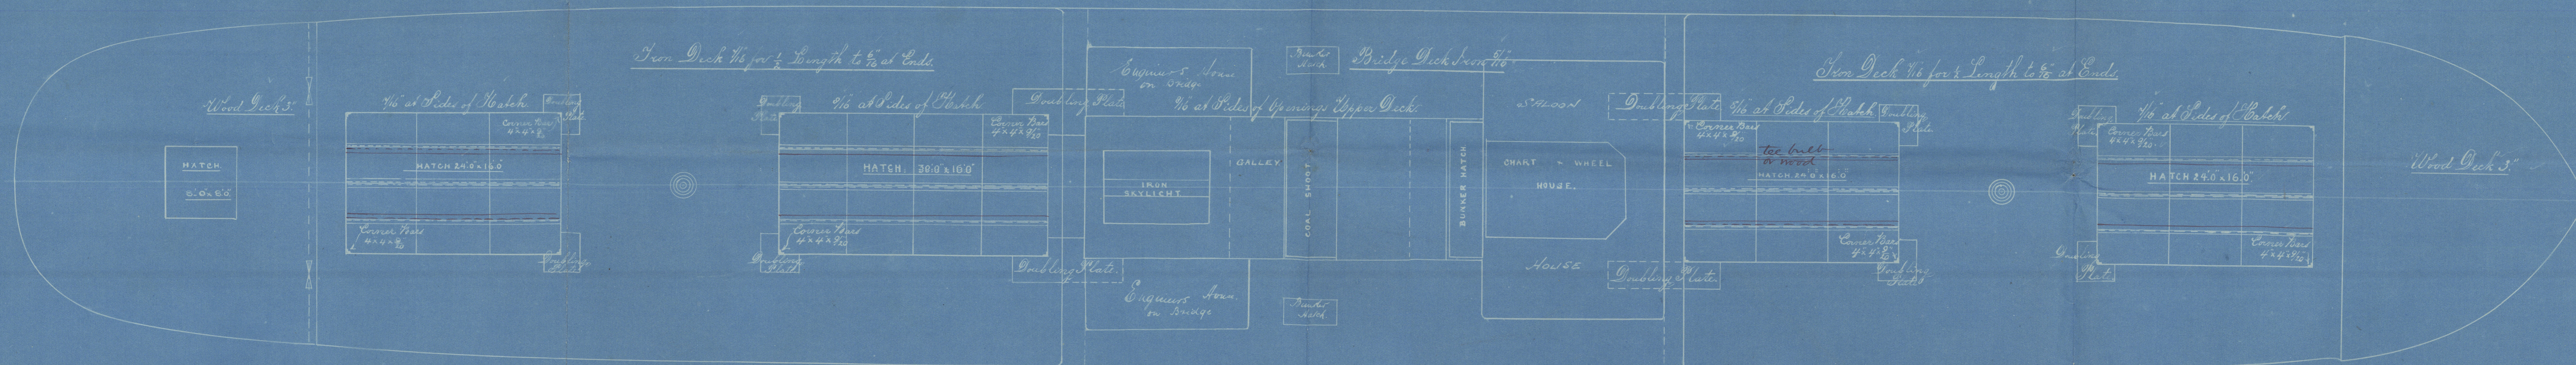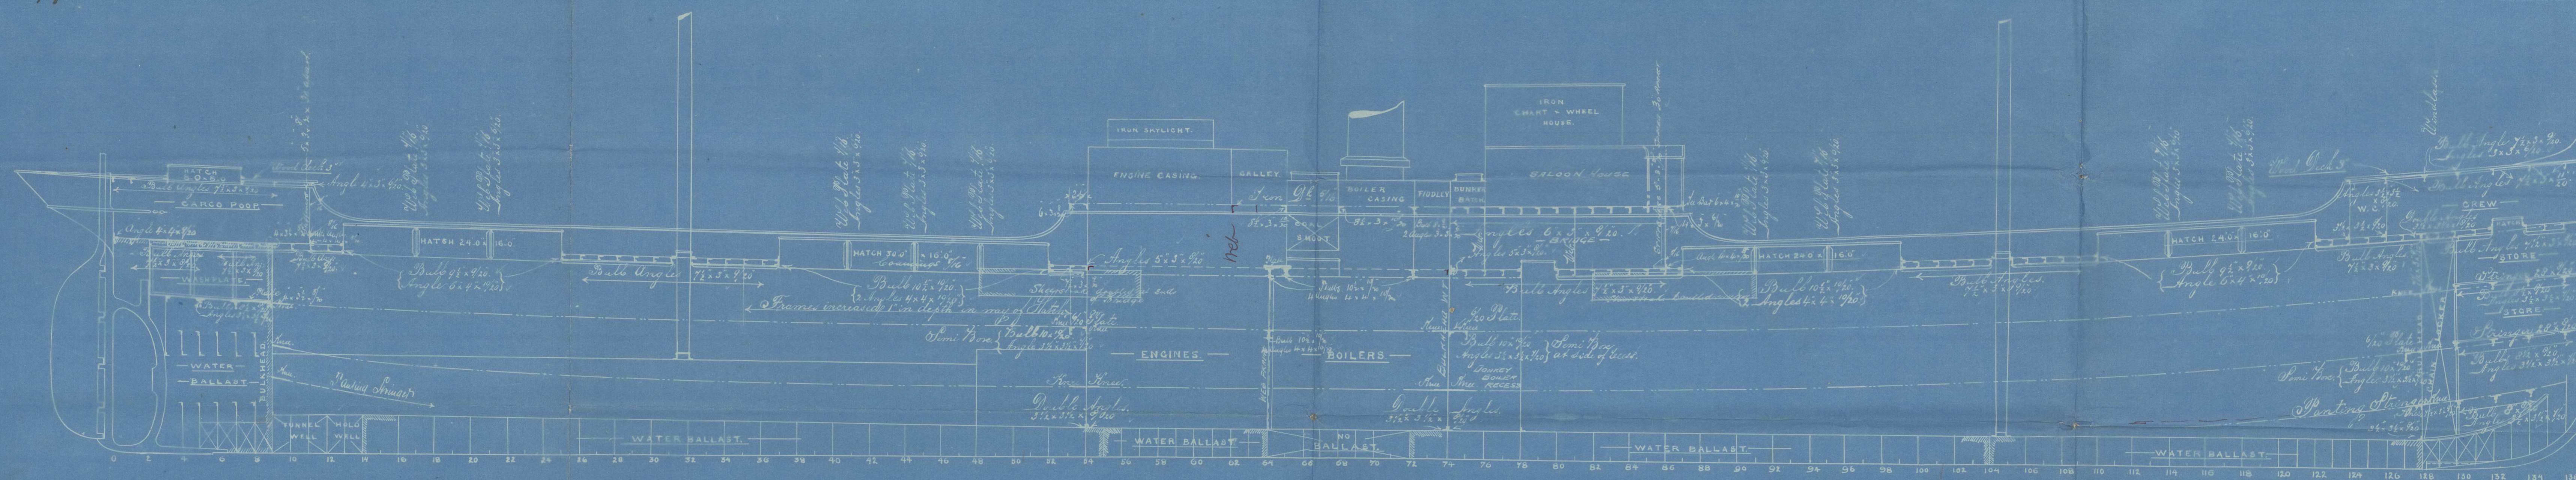

17/12/98



R. Thompson House  
S.L. No 208

ZURRIOLA  
— S. S. "Matienzo" — EX

Sunderland. No 19691 G.B.

G.B.




© 2021

Lloyd's Register  
Foundation

011047-011056-0214


R. Thompson & Co  
S. 190208

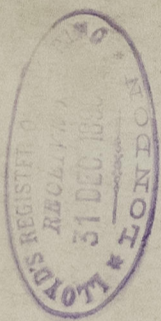

ZURRIOLA  
"S. S. Matienzo" Ex


Sunderland No 19691 G.B.

G.B.

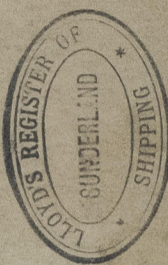

011047-011056-0214

0214

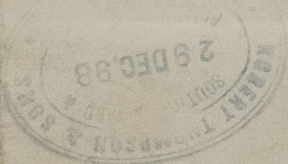

© 2021

Lloyd's Register  
Foundation