

M:V: "CERION"
MIDSHIP SECTION
SCALE 1/2" = 1'-0"
DD CLASS 100A1 (FULL SCANTLING)

LLLOYD'S NUMBERS.

D =	25.00
L X D = 305.75 x 25.00 =	7643.75
L (B + D) = 305.75 (41.75 + 25.00) =	20408.81
$\frac{L}{D}$ = 305.75 : 25.00 =	12.23

**SECTION THRO' CARGO SPACE
SHEWING BRACKET FLOOR.**

P.S.


SMITHS DOCK COMPANY LTD
RIVER TEES DOCKYARD
SOUTHBANK-MIDDLES BROUGH
YARD No 1054

DETAIL A'

P.S.


SECTION THRO' CARGO SPACE SHEWING
SOLID FLOOR.

SECTION THRO' CARGO SPACE SHEWING
BRACKET FLOOR.

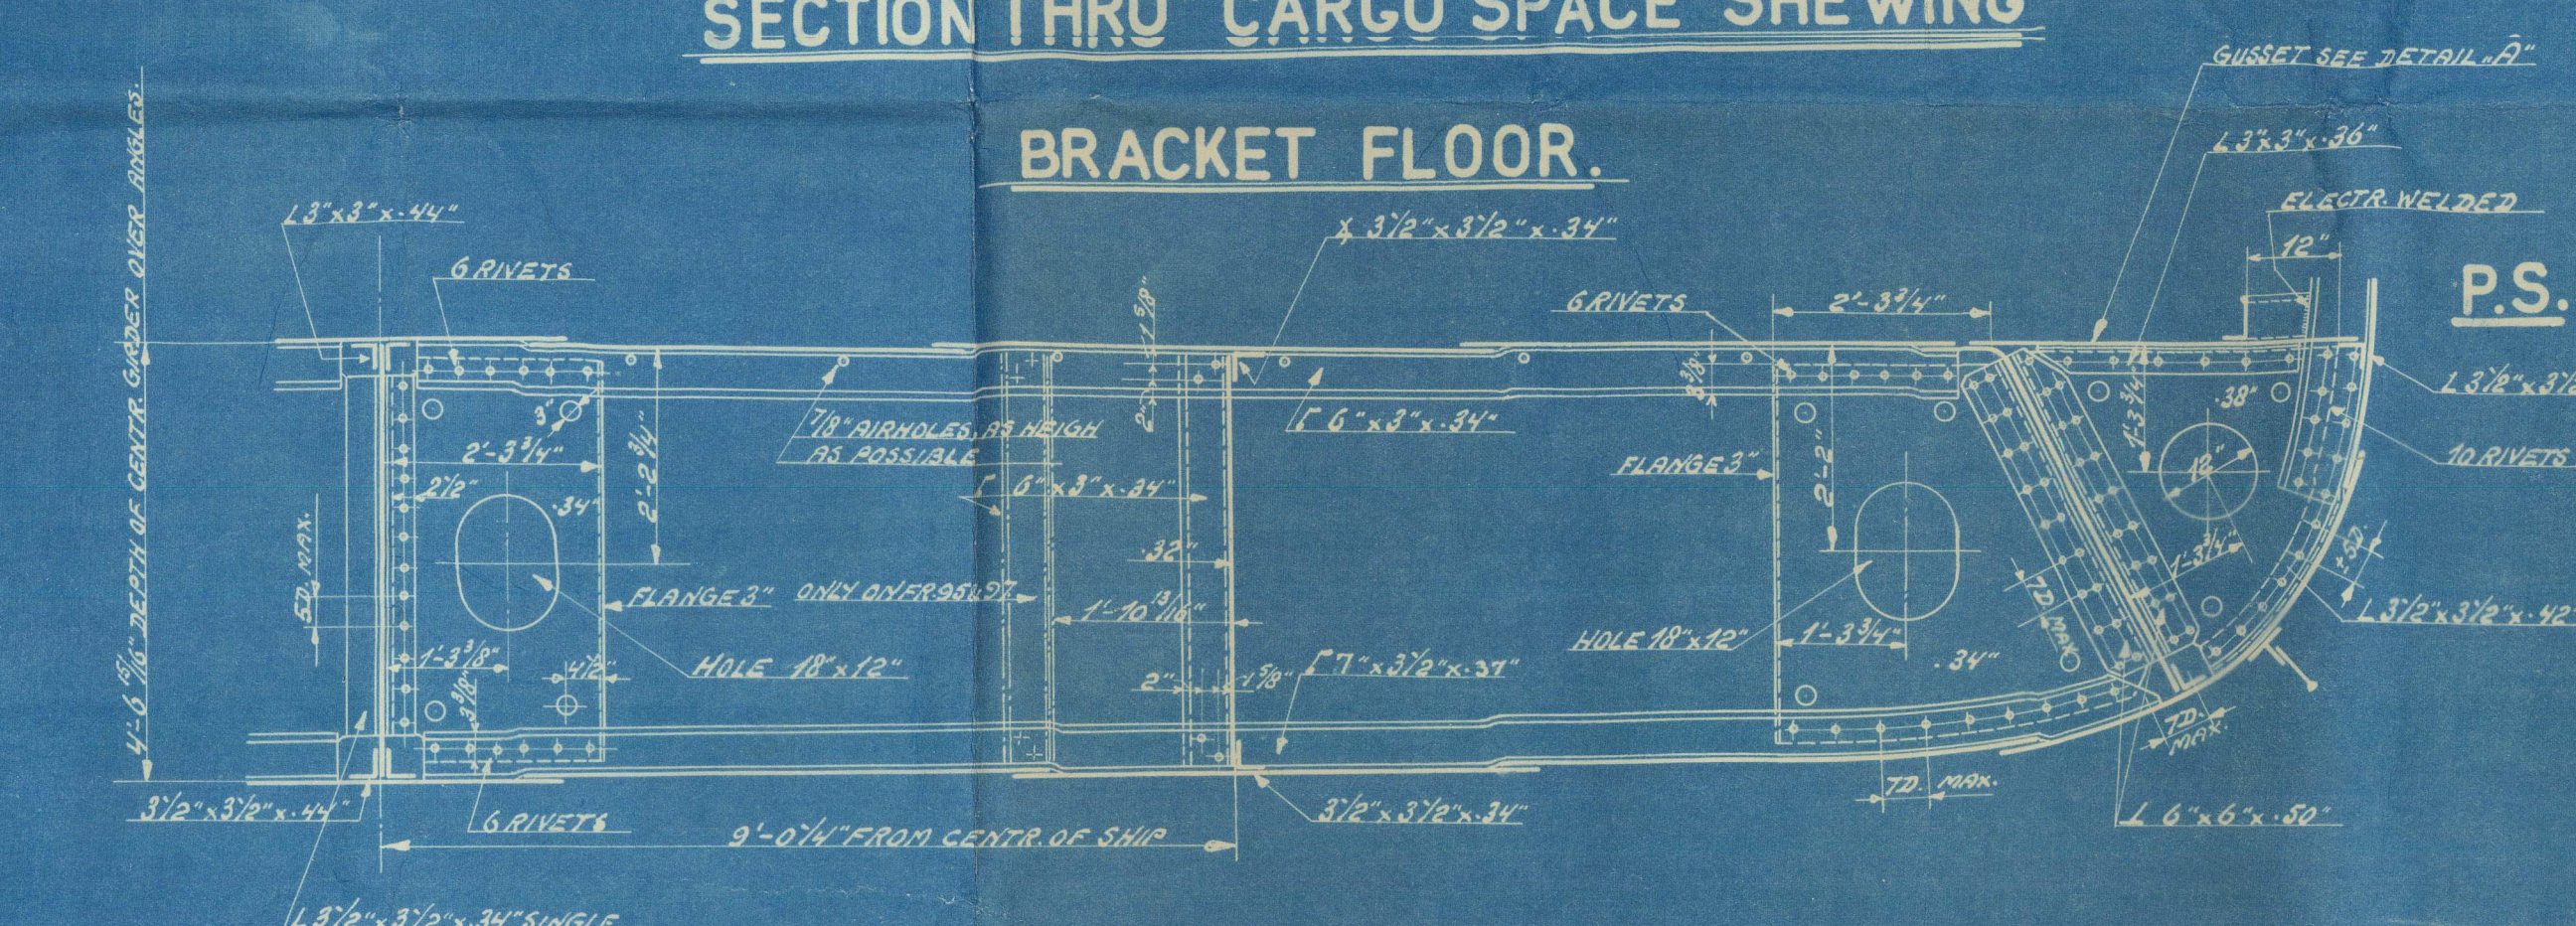

SECTION THRO' CARGO SPACE SHEWING
BRACKET FLOOR.

**SECTION THRO' CARGO SPACE SHEWING
SOLID FLOOR.**

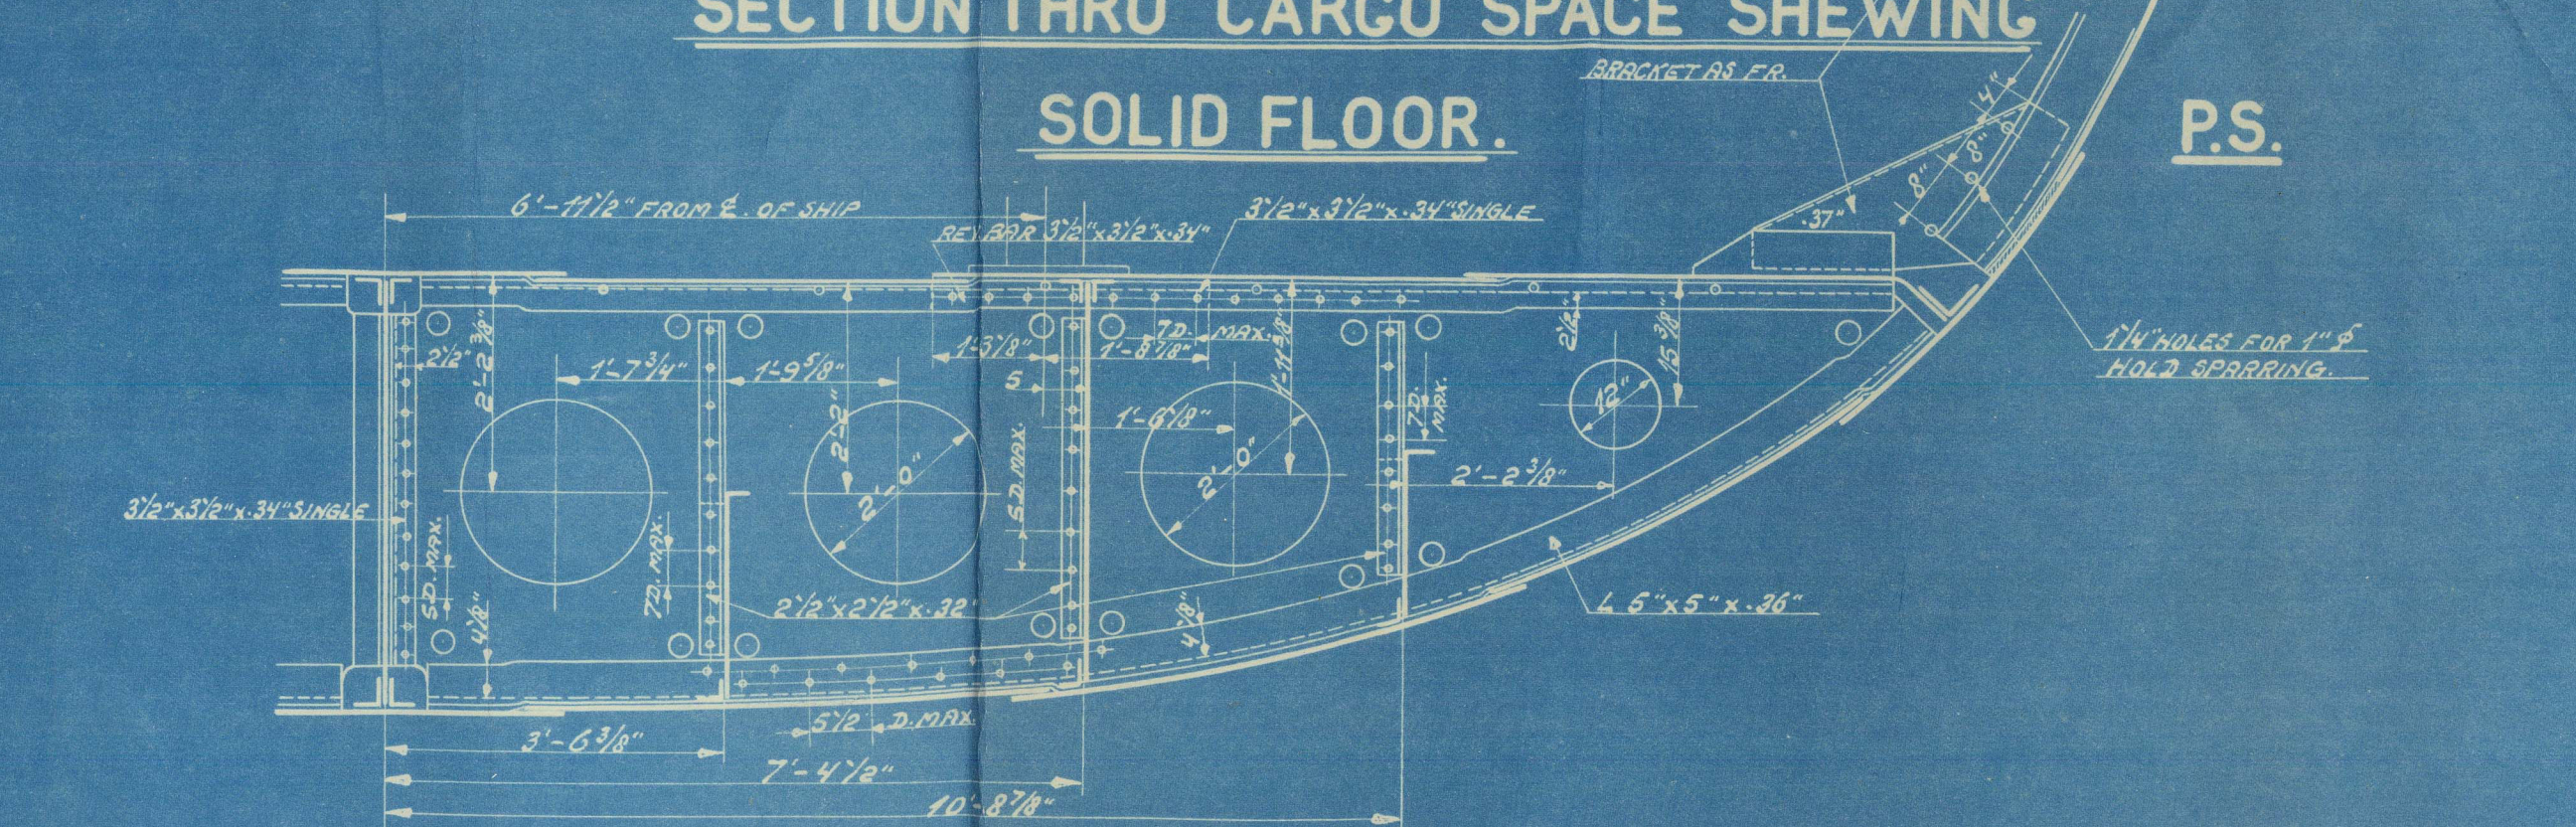

MY CERION.

MIDSHIP SECTION

AS. BUILT.

Mold. Pmt. No. 16490.



© 2021

Lloyd's Register
Foundation

011057-011061-0039