

SHIP Nos. 486 / 7.



GENERAL ARRANGEMENT.

DIMENSIONS: 105'-0" B.P. x 23'-6" MLD. x 11'-6" MLD.

SCALE: 1/4" = 1 FOOT.

FIRE FIGHTING APPLIANCES

HOSE LENGTH


1 - 30'-0" LENGTH.
COMPLETE WITH COUPLINGS, CONDUCTOR
& SPRAY NOZZLE.

EXTINGUISHERS

3 - 2 GALL. FOAM.

FIRE BUCKETS ETC.

4 - FIRE BUCKETS (2 WITH LANYARDS)
1 - SAND BOX (6 CU. FT.)

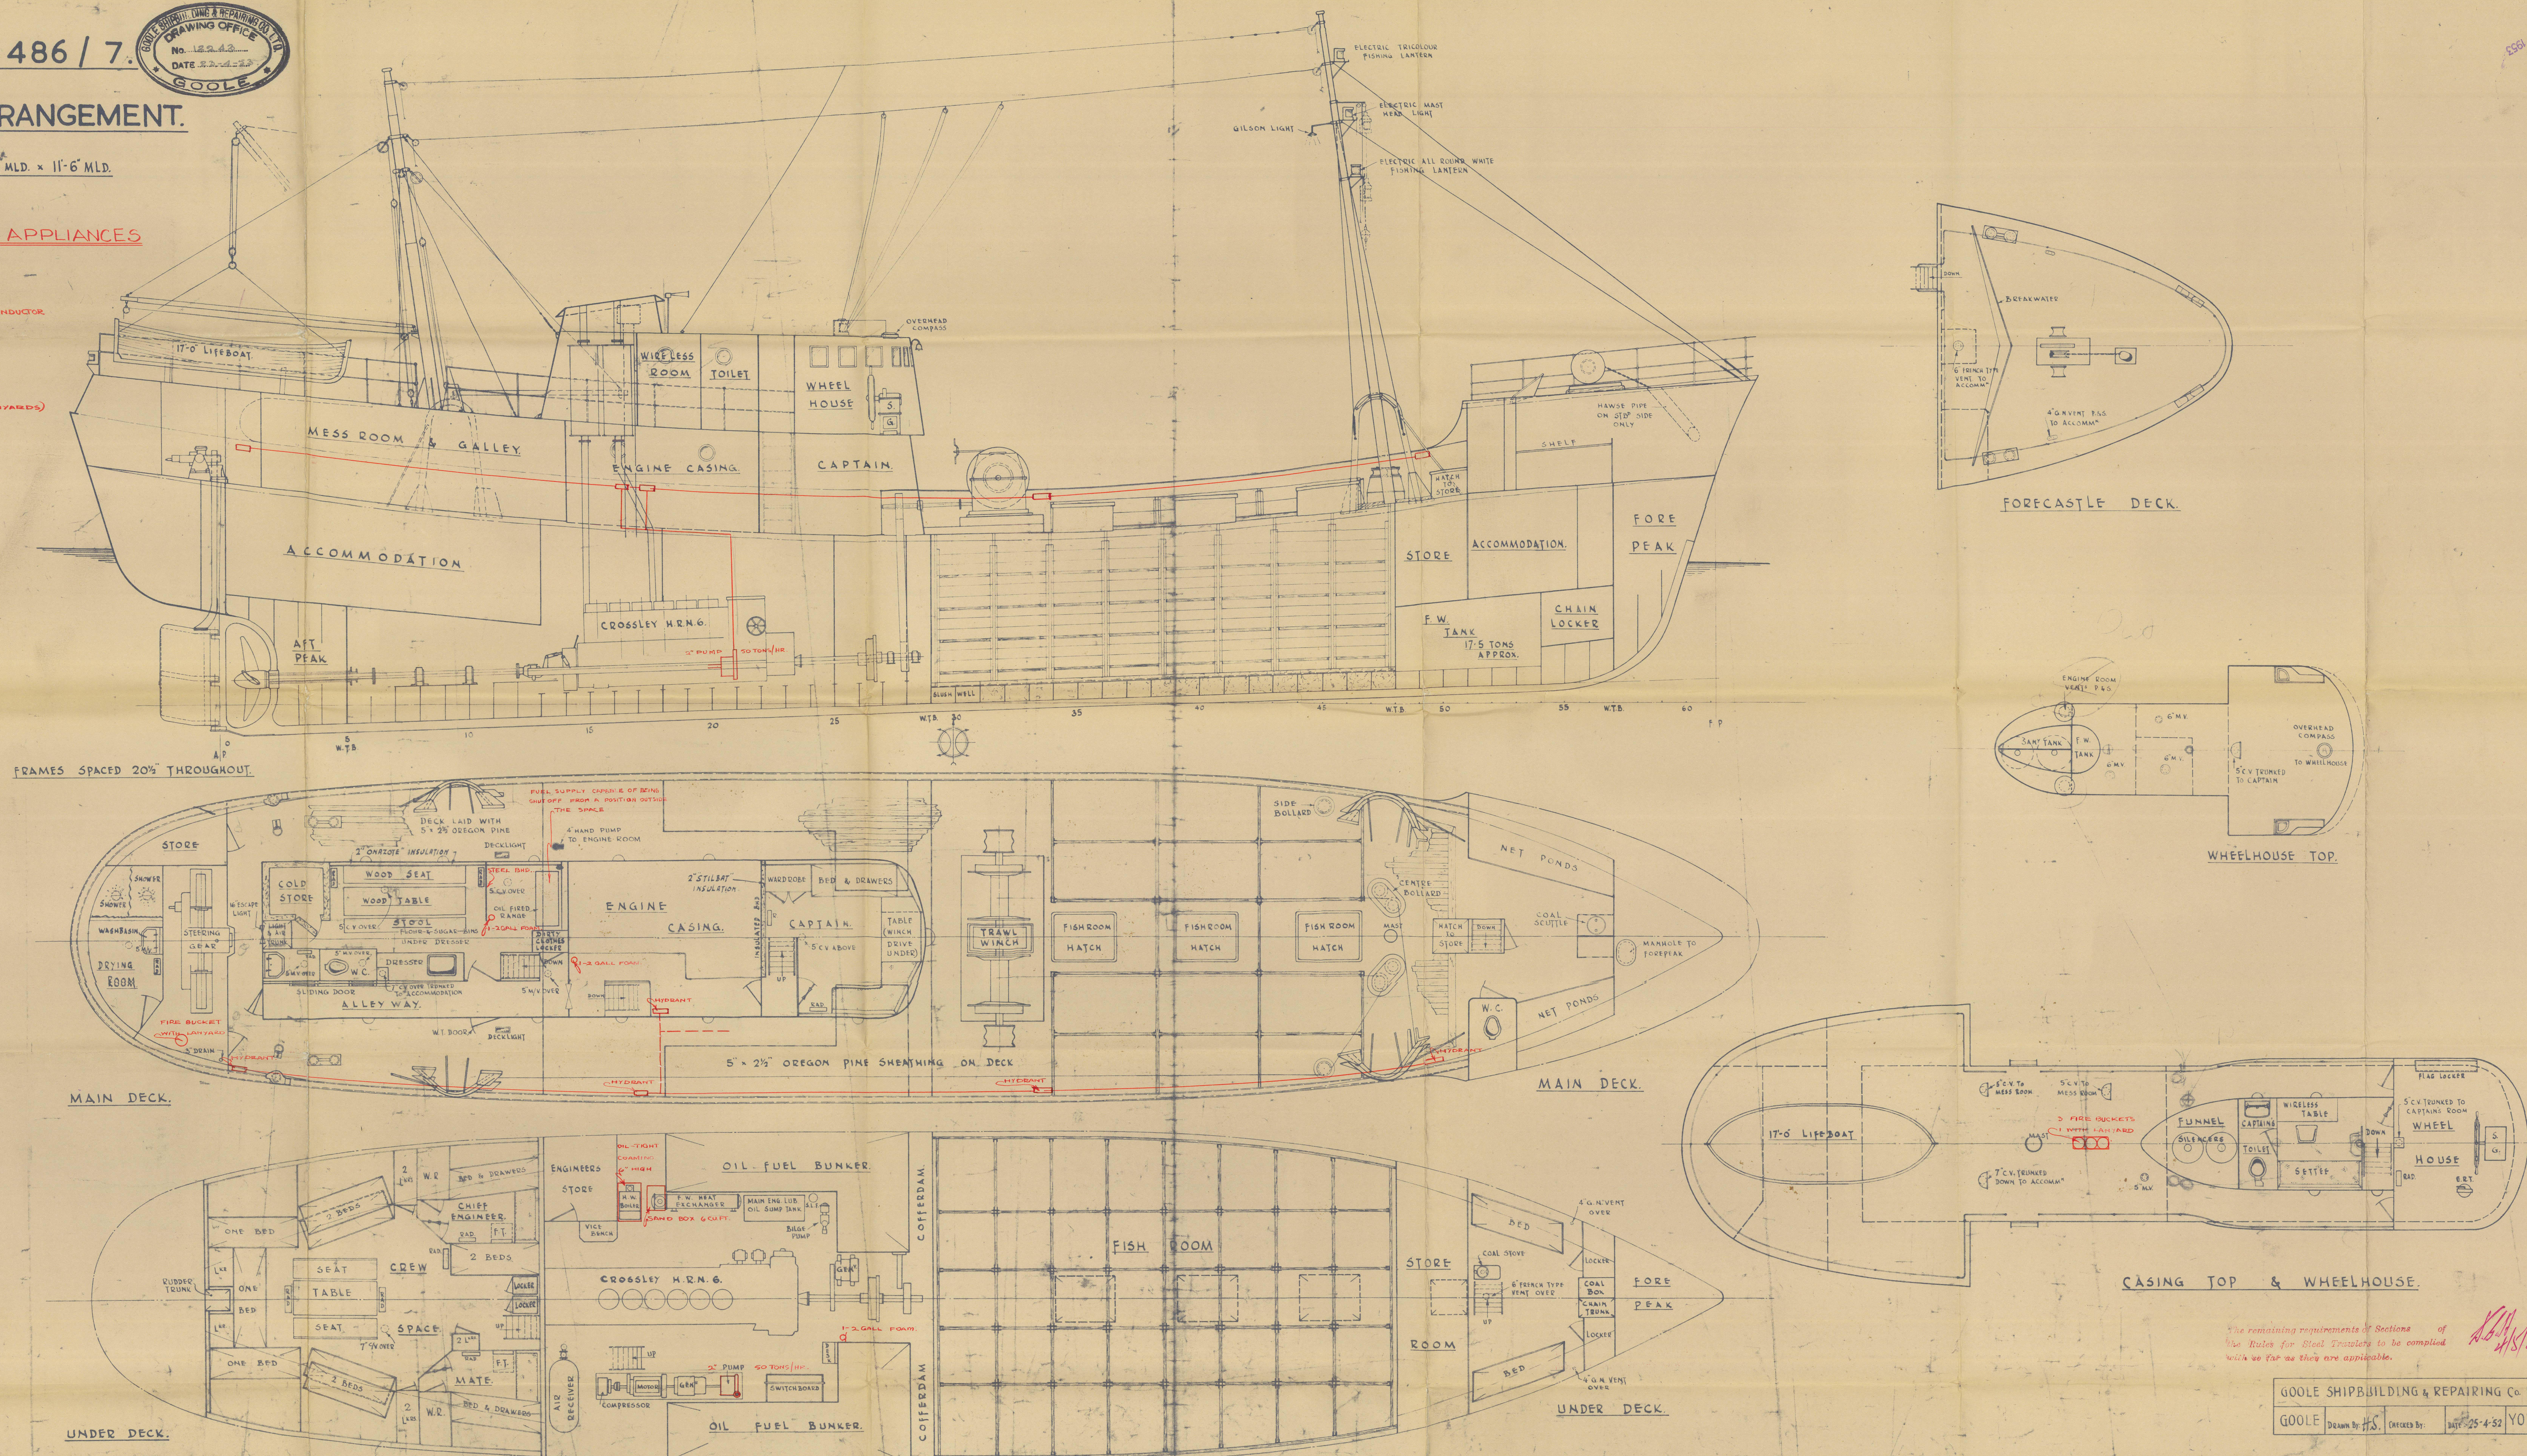


GOOLE SHIPBUILDING & REPAIRING CO. LTD.

NORDELITE



GOOLE S.B. v REP Co

YARD No 486.

HULL J.E. REPORT No 59339.

RECORDS DEPT
LONDON



GENERAL ARRANGEMENT.



© 2021

Lloyd's Register
Foundation

011057-011061-0280



011057-011061-0280



© 2021
Lloyd's Register
Foundation