


CLASS 100A 1. AT LLOYDS TO CARRY PETROLEUM IN BULK.

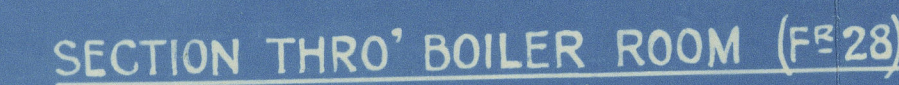

Dunlop Bremner & Co. Ltd

No 314.

Midship Section (as built)
Captain Mikes

R.F.A. Petrucella^{ex}

Grk Rep No 17285



© 2021

Lloyd's Register

011062-610070-0318