

# RUDDER & STERNPOST.

S.S. No 503.

SCALE  $\frac{1}{2}$ " = 1 FOOT.

RUDDER FORGED STERNPOST CAST STEEL.  
ALL TO LLOYDS REQUIREMENTS.  
SPEED 10½ KNOTS



AREA = 57.12 + 3.2.3 = 43.8 - A  
LLOYDS NUMERICAL A x D = 43.8 x 2.08 = 91  
DRAUGHT = 13'-0" M.D.

1.68 + .48 = 2.08 = C.G.D.

ALEX. STEPHEN & SONS LTD.  
SHIPBUILDERS & ENGINEERS  
GLASGOW.

PLAN No 4

DATE 11-10-23

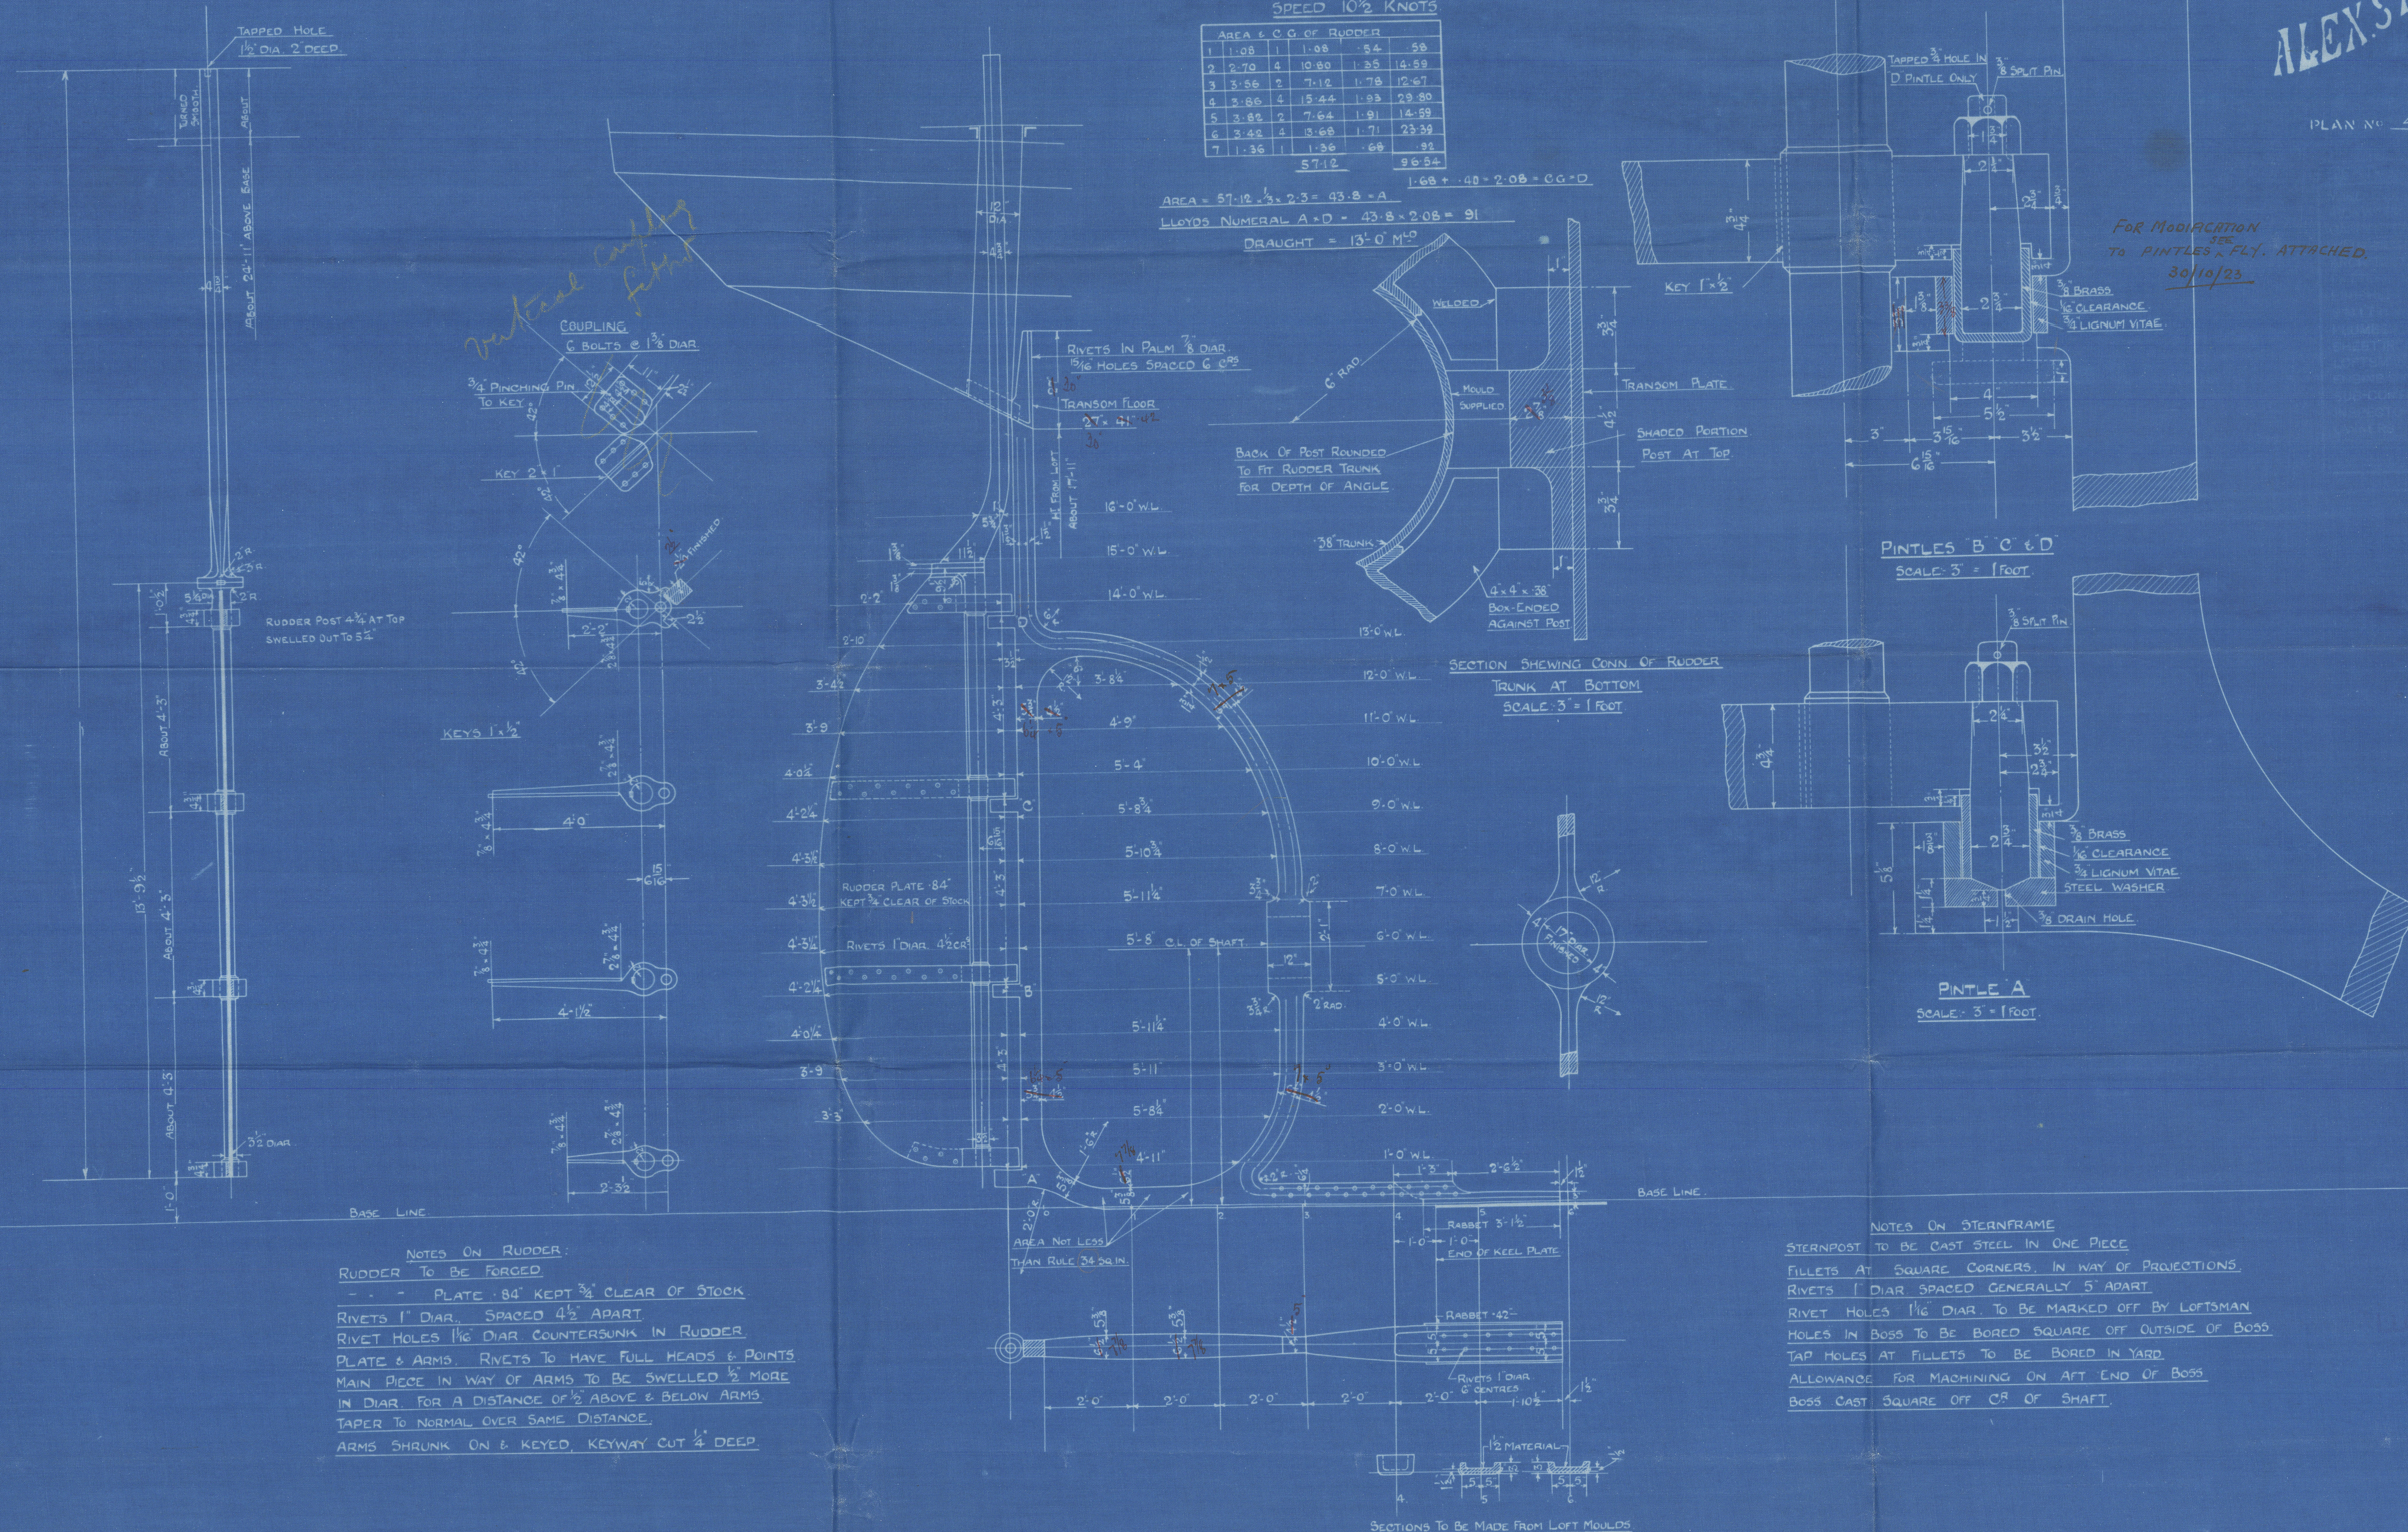



Stephens 503

Steam Kaine & Rudder

GLASGOW REPORT No. 43744

"Bulan"



© 2021

Lloyd's Register  
Foundation

011071-011078-0268