

Nº 815 E

PROPOSED CENTRE KEELSON.


SCALE :- 1/2" INCH = 1 FOOT.

23rd May 1927.
F. S.



APPROVED
LLOYD'S REGISTER OF SHIPPING

Montgomery
Per Spott
DATE 30.5.27

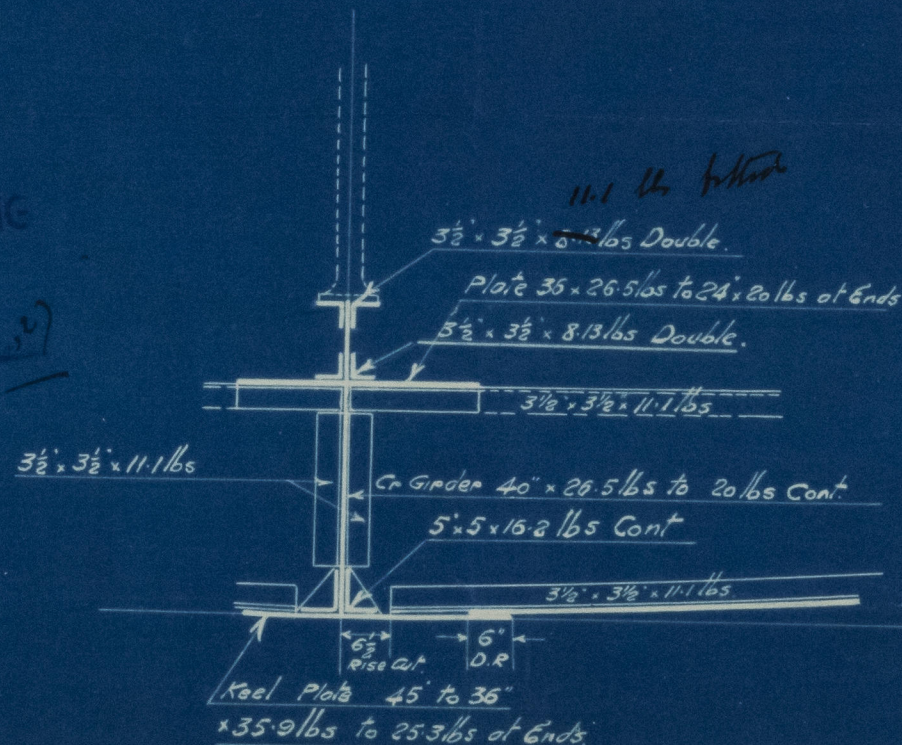

© 2021
Lloyd's Register
Foundation
011029-011097-0049

A. & J. Ingham
Centre Kitchen.
815 P

Mr. Deelina
Mitne.

Glasgow Report
N° 4 Fofa.

GLASGOW REPORT NO.



© 2021

Lloyd's Register
Foundation

011029-011098-0049