

Rpt. C.11.

## LLOYD'S REGISTER OF SHIPPING

Index No. 6093

(For London Office only.)

UNITED WITH THE BRITISH CORPORATION REGISTER

## SURVEYS FOR FREEBOARD.

(CONDITIONS OF ASSIGNMENT.)

Ship's Name "MOBIL COMET"

Port of Survey PALERMO

Official Number


Surveyor's Signature

P. H. W. Evans

Nationality and Port of Registry PANAMANIAN PANAMA

Date of Survey 14th, 17th, 28th &amp; 29th August 1956

Disposition and dimensions of superstructures, trunks, deckhouses, machinery casings and wood sheathing to be inserted in the diagrams and tabular statement:—

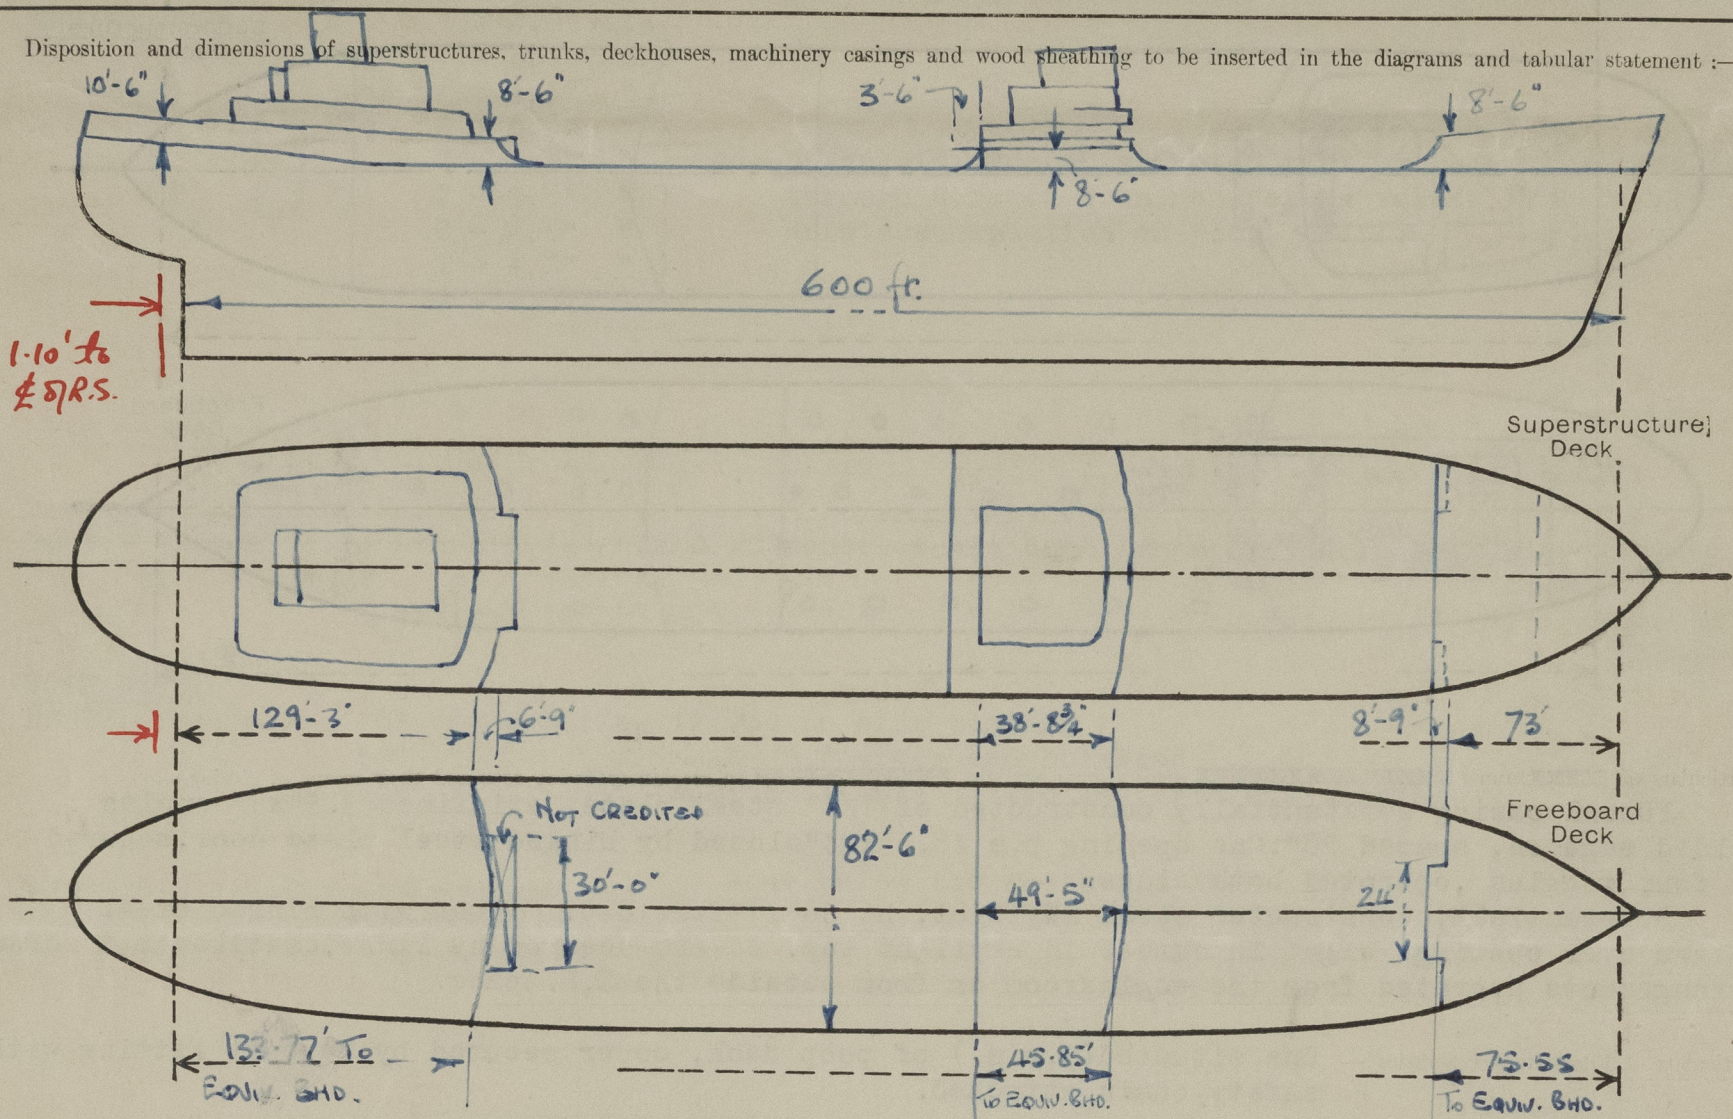

Particulars of Superstructures, Trunks, Casings, Deckhouses.

	Coaming	Plating	Stiffeners	Spacing	End Attachments of Stiffeners	Size of Openings	Height of Sills	Height, Beam to Beam
Poop Bulkhead ...	-	7/16" ✓	11"x 4.5"x 0.5" ✓	30" ✓	Welded & Bkt at top. W.btm	Nil ✓	-	8'-6" ✓
Raised Quarter Deck Bulkhead ...	-	-	-	-	-	-	-	-
Bridge, After Bulkhead ...	-	5/16" ✓	4"x 3"x 1/4" ✓	30" ✓	Top welded & Bkt shaped ✓	P&S 60"x28" ✓	18.5" ✓	8'-6" ✓
Bridge, Forward Bulkhead ...	-	3/8" ✓	11"x4.5"x3/8" ✓	30" ✓	Welded to top & btm. ✓	P&S 28"x60" ✓	18.5" ✓	8'-6" ✓
Forecastle Bulkhead ...	-	5/16" ✓	3.5"x2.5"x1/4" ✓	30" ✓	Snaped top & btm. ✓	P&S 48"x38" ✓	24" ✓	8'-6" ✓
For'd secondary bulkhead	-	5/16" ✓	3.5"x2.5"x1/4" ✓	30" ✓	Welded to top & btm. ✓	P&S 60"x28" ✓	18" ✓	8'-6" ✓
Trunk, Forward ...	-	3/8" ✓	6" x 4" x 3/8" ✓	30" ✓	Welded to top & btm. ✓	P. 63"x28" ✓	15.5" ✓	12.5' ✓
Exposed Machinery Casings on Freeboard or Raised Quarter Decks ...	-	-	-	-	-	-	-	-
Exposed Machinery Casings on Superstructure Decks (Boat deck)	-	5/16" ✓	4"x3"x3/8" ✓	36" ✓	Alternate stiff's bracketted at top	60"x28" ✓	16.5" ✓	11'-5" ✓
Machinery Casings within Superstructures not fitted with Class I Closing Appliances ...	-	5/16" ✓	" ✓	28" ✓	"	66"x28" ✓	13.5" ✓	- ✓
Pump Room Entrances	-	3/8" ✓	11"x4.5"x0.5" ✓	30" ✓	Welded to deck at btm. ✓	28"x60" ✓	24" ✓	8'-6" ✓

Particulars of Closing Appliances (state if capable of being manipulated from both sides).

Poop Bulkhead	NO OPENINGS
Poop deckhouse	Substantially constructed st'l deckhouse enclosing E.R. casing with openings 60"x26" sills 16" in for'd b'nd & 15" elsewhere, closed by st'l w.t. doors secured 6 toggles operated both sides.
Bridge, After Bulkhead	P&S openings closed by hinged st'l w.t. doors, secured 6 toggles, operated both sides.
Bridge, Forward Bulkhead	S opening closed rect' st'l plate, diag' stiffened, secured 14 hook bolts.
Forecastle Bulkhead	P&S openings closed by hinged st'l w.t. doors, secured 6 toggles, operated both sides.
Exposed Machinery Casings on Superstructure Decks (Boat deck)	P&S openings closed hinged st'l w.t. doors, secured 6 toggles, operated both sides.
Machinery Casings within Superstructures not fitted with Class I Closing Appliances	enclosed in fossle:- P.S. opening, closed hinged st'l w.t. door, secured by lock operated both sides.
Pump Room Entrances	S.S. opening, closed rect' st'l plate, diag' stiffened, secured hook bolts.
	Port opening 60"x28", fitted hinged st'l w.t. door, secured 6 toggles, operated both sides.
	P&S openings, closed ordinary plate st'l doors, operated both sides, situated poopdeck
	2P & 2S openings-----do-----situated main d'k level.
	P&S openings, closed hinged st'l doors, operated both sides, secured 6 toggles.



# PARTICULARS OF PROTECTION TO OPENINGS, ETC.

HATCHWAYS ON FREEBOARD AND SUPERSTRUCTURE DECKS.										
FOCSLE										
FOCSLE										
Description of Hatchway ... ..										
Dimensions of Hatchway ... ..										
COAMINGS	Height above Deck	32"	23"	32"	9.5"	10"	25"	25"	25"	32.5"
	Thickness	1 1/2"	1 1/2"	1 1/2"	3/8"	1 1/2"	1 1/2"	3/8"	3/8"	1 1/2"
	Stiffeners	=	=	=	=	=	7"x4"x0.5"	=	=	=
	Brackets, Stays	=	=	=	=	=	3/8" flanged	=	=	=
<del>HATCH</del> <del>COVERS</del>	Number									
	Spacing									
	Scantling and Sketch									
	Bearing Surface									
<del>POOP</del> <del>DECK</del> <del>BUNKER</del>	Number									
	Spacing									
	Unsupported Lengths									
	Scantling* and Sketch									
HATCH COVERS	Bearing Surface						Hatch cover fitted with oval access hatch 23"x15"			
	Material	Steel	Steel	Steel	Steel	Steel	Steel	Steel	Steel	Steel
	Thickness	0.5"	0.5"	0.5"	5/16"	0.5"	0.5"	3/8"	3/8"	0.5"
	How fitted									
Bearing Surface										
Hinged										
water tight										
Spacing of Cleats										
Number of Tarpaulins										
24"										
One.										
*Are <del>xxx</del> fore and afters steel shod at all bearing surfaces?										
Yes										
Are battens and wedges efficient and in good condition?										
Yes										
Are tarpaulins in good condition and in accordance with rule requirements?										
Yes										
Are lashings provided in accordance with rule requirements?										
-										
Are wood covers fitted with galvanised end bands?										
-										

Particulars of any special features:— (Timber Deck-cargo Fittings, Skylights, Sewage Systems, Ash Ejectors, Rubbish Shoots, etc.)

**CARGO HOLD:—**For'd cargo hatchway(dry cargo hold),on freeboard deck,enclosed in focsle space,fitted with patent hollow steel hatch covers 10 feet long, of 3/16" thick material,unsupported by beam.

**AFT'PUMPROOM:—**After pumproom skylights P & S,comaing 60"x99" x 18" high,fitted with substantially constructed steel covers (flanged), hinged & diag' braced.

**POOP DECK BUNKER HATCHES:—**One port and one starb'd, situated on for'd poop deck, dia 32"x32"high x 0.5" thick, constructed of steel, closed by hinged steel w.t cover, secured by strongback and locking screw.Cover also fitted with ullage cap.

**BUTTERWORTH OPENINGS:—** In main deck 12.5" dia, fitted with brass covers secured by studs & nuts.Four openings in each centre tank & two in each wing tank.

**CARGO TANK AIR PIPES:—** Fitted into each hatch coaming,6.5" dia, led to manifold on catwalk and thence to discharge pipes on sampson posts.

**CARGO TANK HATCH COVERS:—** Fitted with 10" dia ullage caps.



© 2020

Lloyd's Register  
Foundation