

RECORDS DEPT:
LONDON.

9

WYSPIANSKI ★

Sternpost




© 2021

Lloyd's Register
Foundation

01110 - 01119 - 0181

FR. O

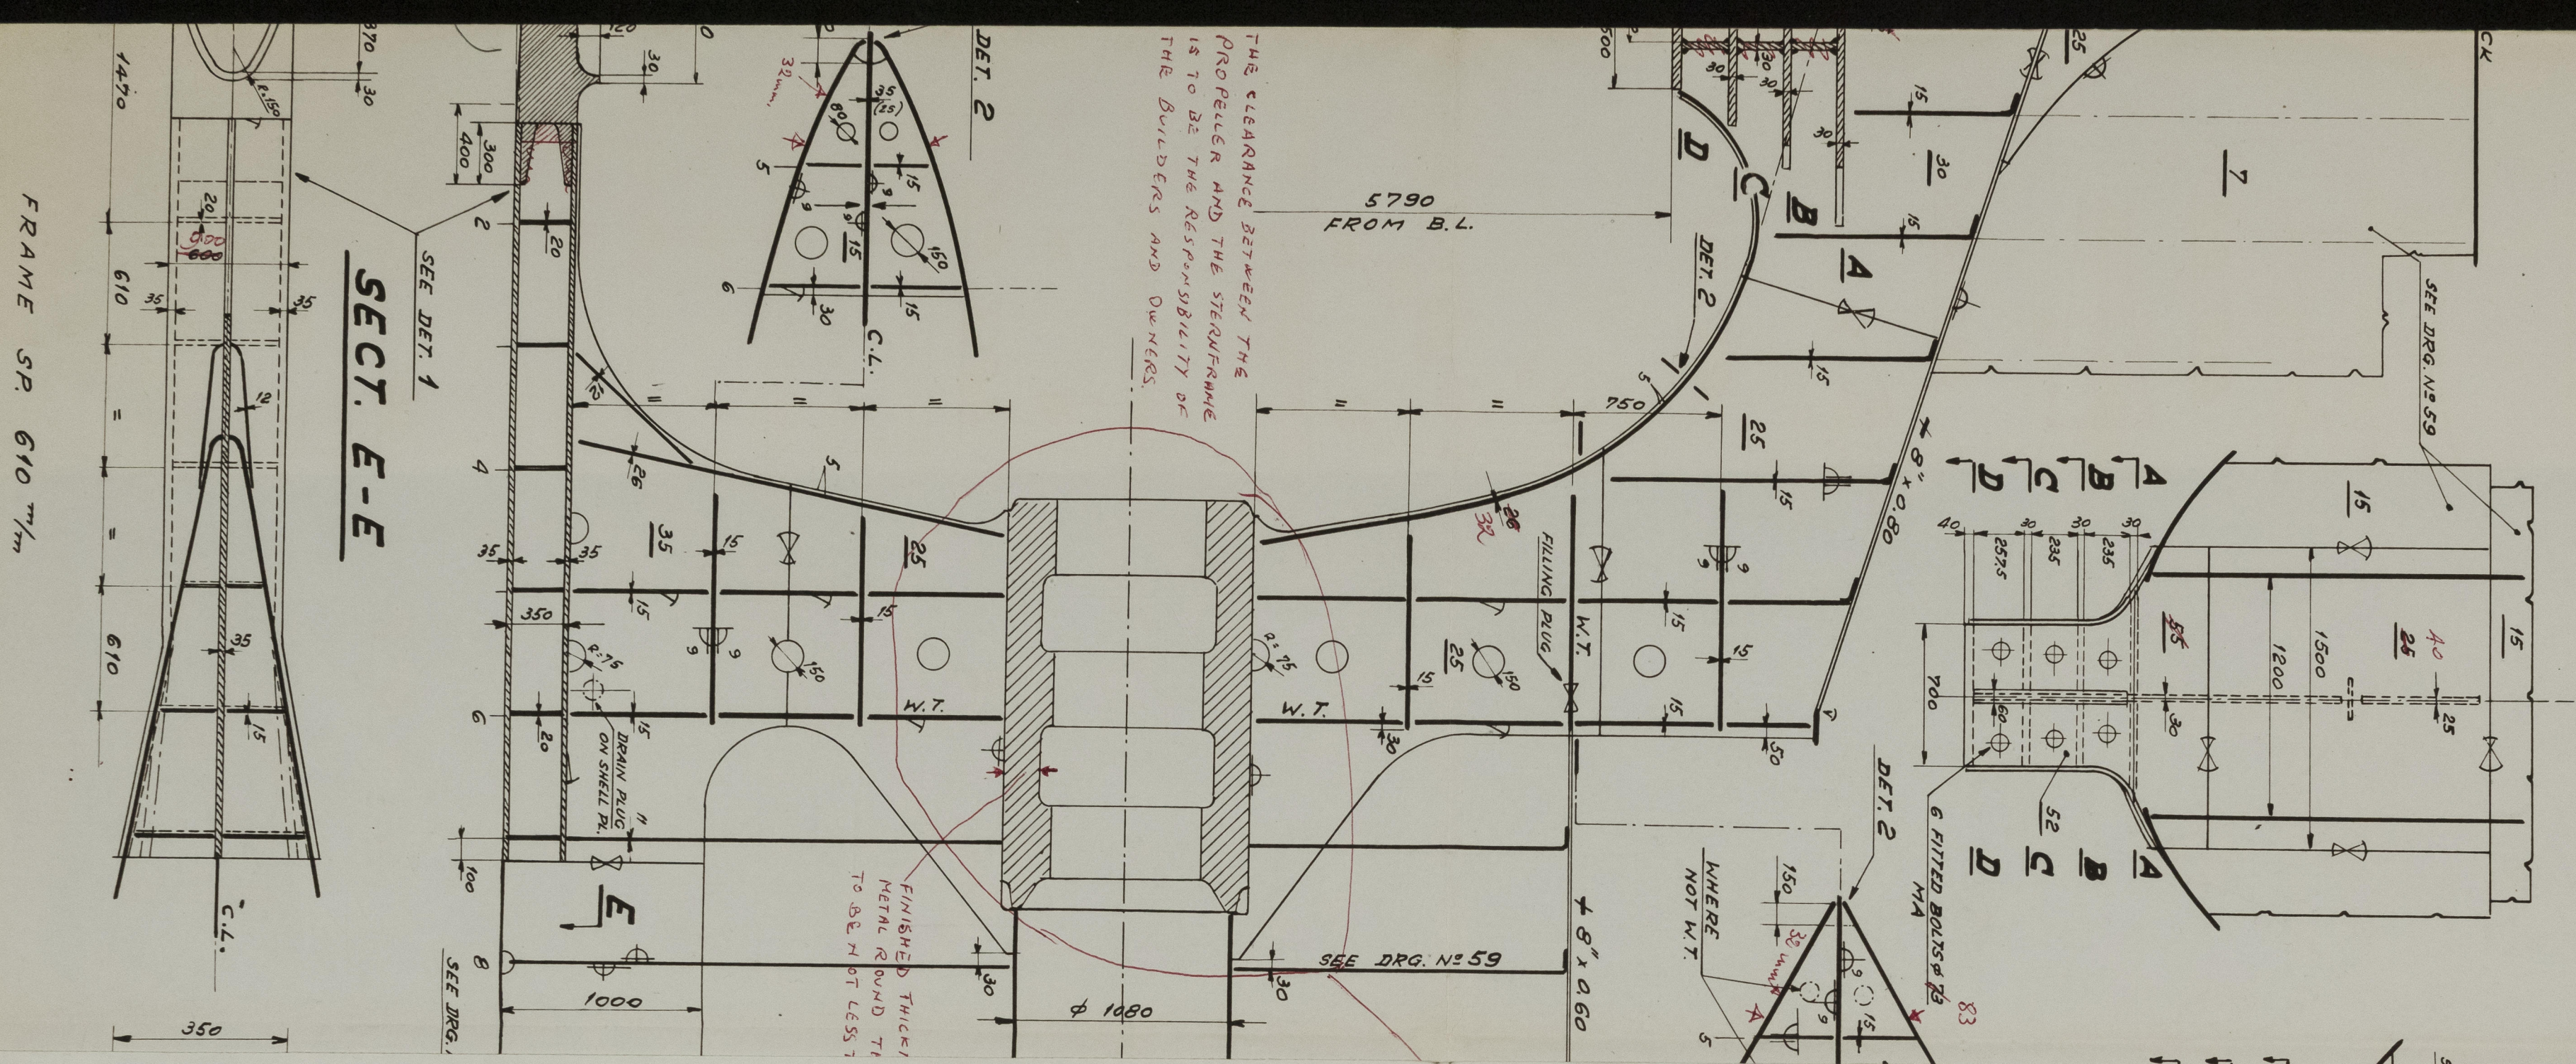

Josef Conrad

01110-01119-0181