

K&N OVERSEA DOCKYARD CO.
 Drawing Office
 Reg. No. 28794
 1/12/35
 NORTH WALL, DUBLIN

Office lobby

No 121.


PROFILE & DECK PLAN.

T.S. TUG AND SALVAGE VESSEL.

110'-0" B.P. x 24'-0" M.D. x 12'-0" M.L. to MAIN D.K.


SCALE 1/4" INCH = ONE FOOT.

CLASS 100 A.I. FOR TOWING PURPOSES.

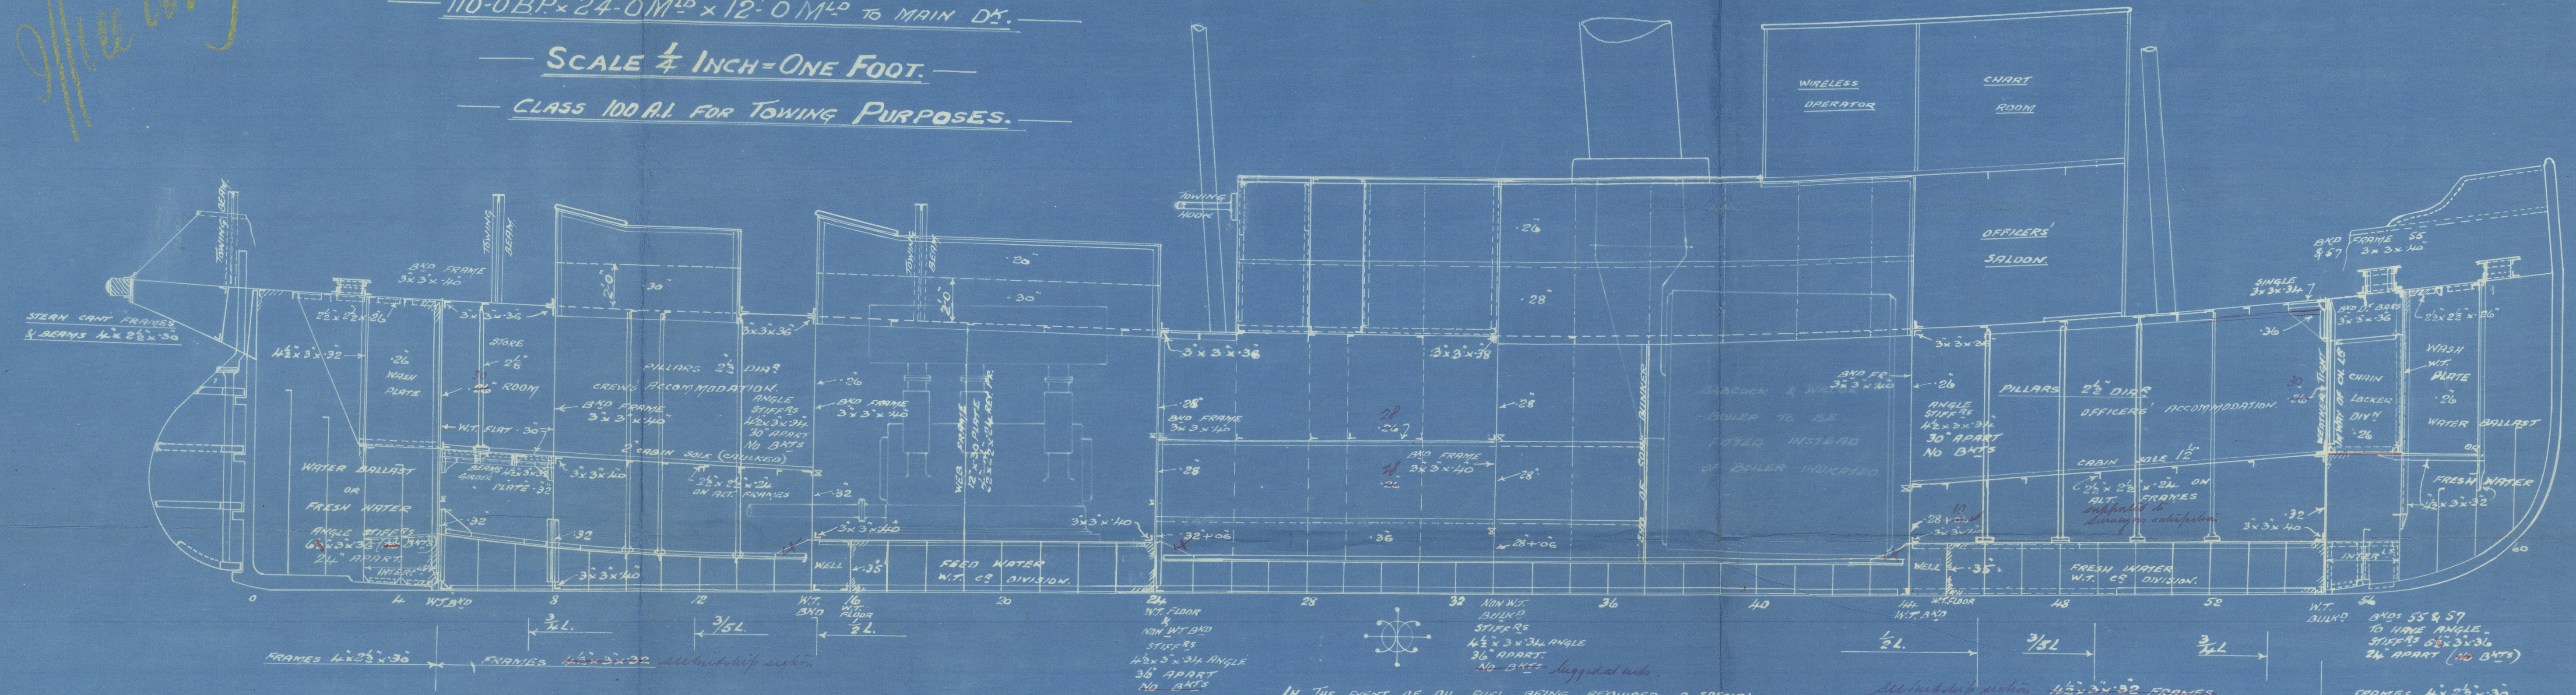

IN THE EVENT OF OIL FUEL BEING REQUIRED A SPECIAL
 SUBMISSION OF OIL FUEL BUNKER WILL BE MADE.

Continuity of strength maintained to survivors relief action

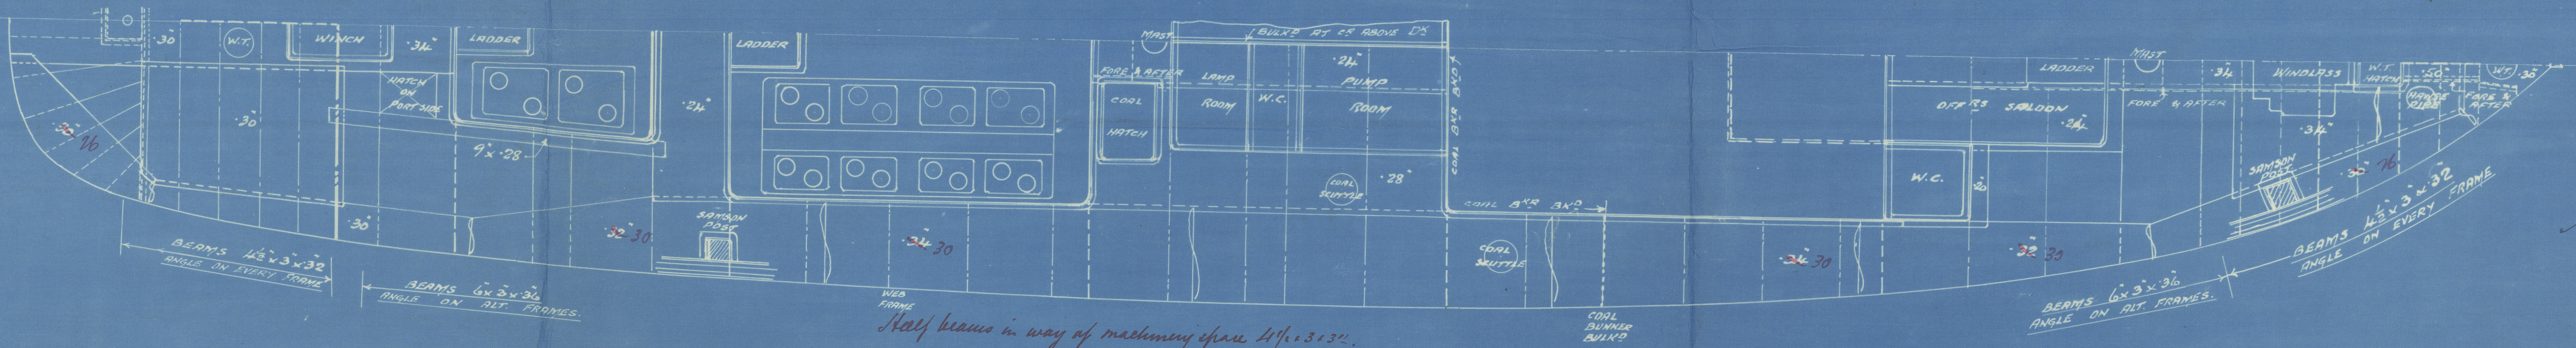

Half beams in way of machinery space 4 1/2 x 3 1/2.

*col.
7.12.35*


Dublin Sept 121.

Proben & deck

Kahanni

GEN. BOX NO

768

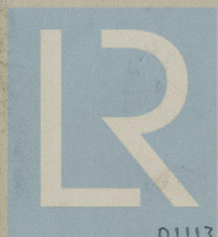

© 2021

Lloyd's Register
Foundation

011130-011139-01115