

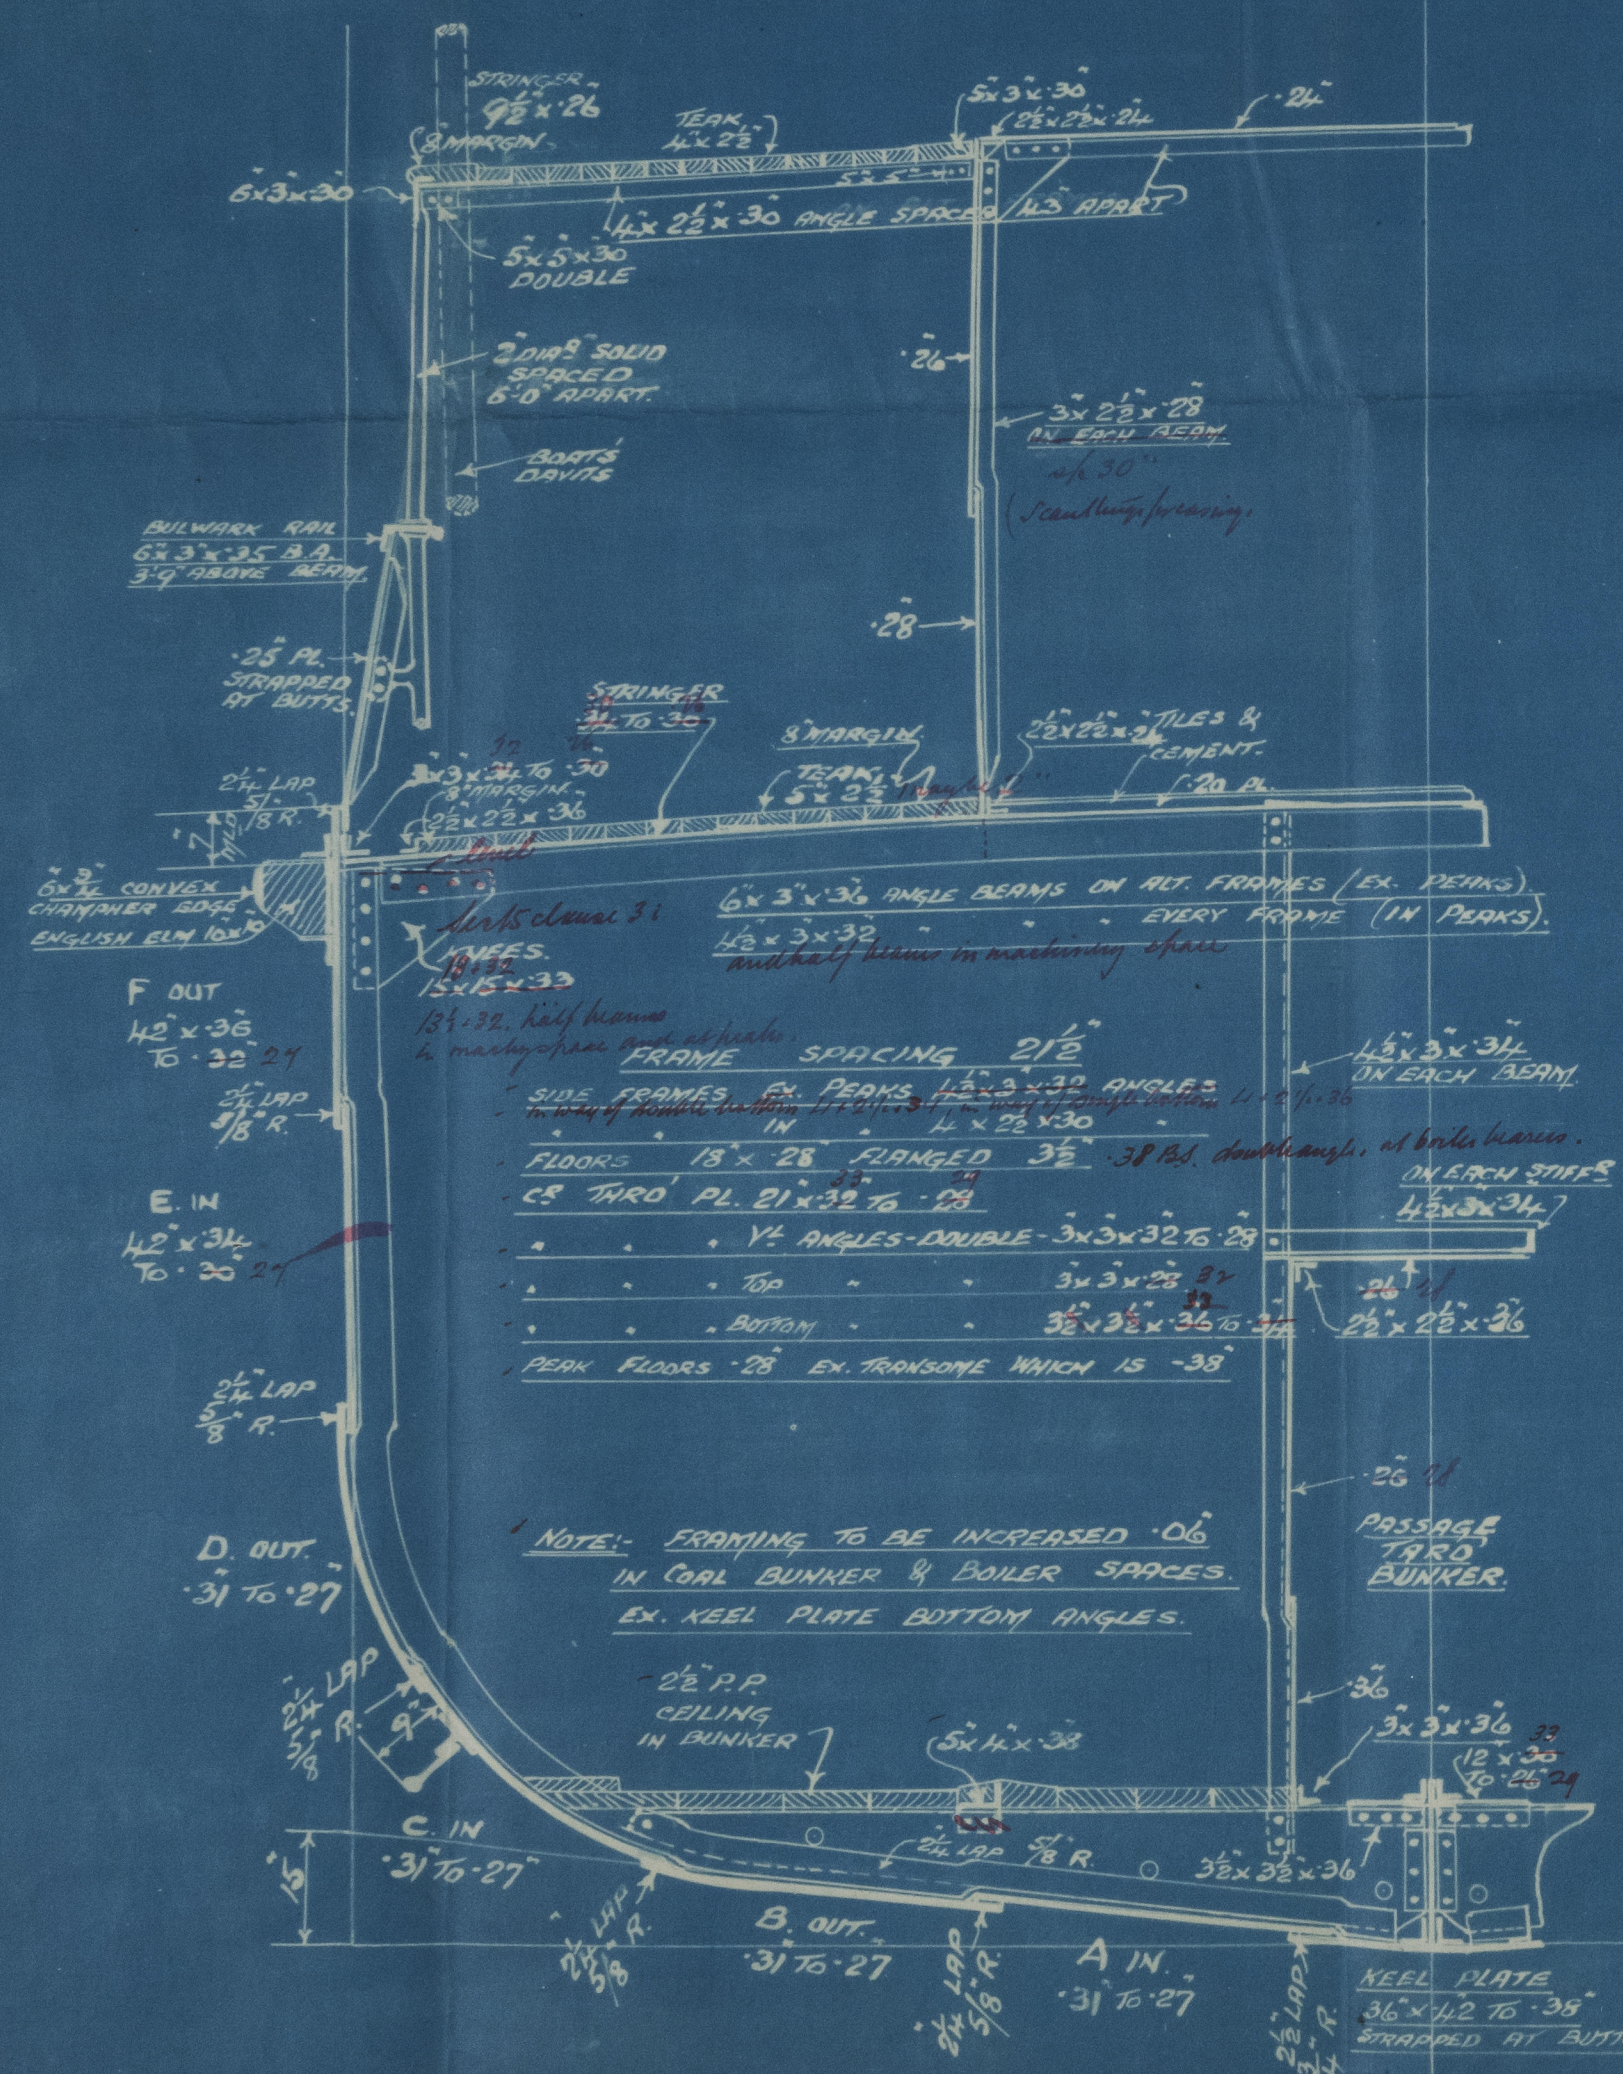
### MIDSHIP SECTION.

## T.S. TUG AND SALVAGE VESSEL

110'-0" B.P. x 24'-0" M<sup>L.D</sup> x 12'-0" M<sup>L.D</sup> TO MAIN DK.

SCALE  $\frac{1}{2}$  INCH = ONE FOOT

- CLASS 100 A.I. FOR TOWING <sup>Services</sup> PURPOSES.

$$L \times D = 1320$$
$$L \times (B + D) = 3960$$
$$\frac{L}{D} = 9.16$$


- IN WAY OF ORDINARY BOTTOM.

## IN WAY OF DOUBLE BOTTOM

## RIVETING

NIVETING			DIP & SPRING
SNELL BUTTS	AT Q.E.	D.R. LAPS THRU OUT	3 1/2
KEEL	"	T.R. BUTTSTRAPS FOR 1/2 L.	3 1/2
BULKHEAD	"	D.R. " AT ENDS.	3 1/2
BULKHEAD	"	S.R. " THRU OUT	4
SNELL SEAMS	S.R. THRU OUT	IN ACCORDANCE WITH TABLE 4	4
D.R. PLATE BUTTS	D.R. LAPS	FOR 1/2 L.	4
"	"	" S.R. " AT ENDS.	4
CENTRE GIRDER BUTTS	D.R.	" THRU OUT	4
TANK TOP SEAMS	S.R.	"	4
D.R. PLATE	"	"	4 1/2
BKD	"	SEAMS & BUTTS S.R.	4 1/2
D.R. STRINGER ANGLE			4 1/2
MARGIN SNELL			4 1/2
BKD FRAMES	TO BULK		4 1/2
"	"	" SNELL	5
FLOORS	TO C/S GIRDER		5
FRAMES	TO SNELL EX. PEAKS		7
"	"	" IN	5 1/2
"	"	FLOORS - AT PEAK	5
BEAMS	- DECK ON ALT. FRAMES		6
"	"	" EVERY FRAME	7
C/S GIRDER & C/S KEELSON ANGLES			7
BKD STIFFS	IN PEAKS		6
"	"	EX.	7
FLOOR & SIDE C/S ANGLES-Y/L			7
FLAT PLATE KEEL ANGLES EACH FLANGE			5
SIDE GIRDER TOP & BOTTOM ANGLES			7
SHEER STRAKE BUTTS	D.R. BUTTSTRAPS THRU OUT		3 1/2

## EQUIPMENT

AS PER RULE		AS SPECIFIED	
1 BOWER	6 $\frac{1}{2}$ CENTS (STOCKLESS)	2 BOWERS	66 CENTS EACH (STOCKLESS)
1 "	5 $\frac{1}{2}$ " "	1 STEAM	3 " (EX. STOCK)
90 FATHOMS	1 "SUD-LINK CHAIN	1 KEDGE	1 $\frac{1}{2}$ " " "
60 "	5 $\frac{1}{2}$ HANSEN	165 FATHOMS	1 "SUD-LINK CHAIN
60 "	4 "WARP	45 "	7 $\frac{1}{2}$ "SHORT-LINK "
		2 @ 90 "	1 $\frac{1}{2}$ "MANILLA TOW-ROPE
		2 @ 30 "	1 $\frac{1}{2}$ " " "
		80 "	1 $\frac{1}{2}$ " " "
		1 COIL OF	6 " " "
		1 "	5 " " "
		2 @ 40 FATHOMS	1 $\frac{1}{2}$ "S. WIRE "
		1 SPARE ANCHOR	



Dublin & Ryd Co. 121.

---

Section

---

Kahanni

---

~~GEN. BOX NO~~ 768

---



© 2021

Lloyd's Register  
Foundation

011130-011139-0119