


SCALE $\frac{1}{2}$ " = ONE FOOT

DIMENSIONS :- LENGTH 200'-0" BP. x BREADTH 34'-0" x 11'-6" TO MAIN DK
TO CLASS B5. * (WITH FREEBOARD)

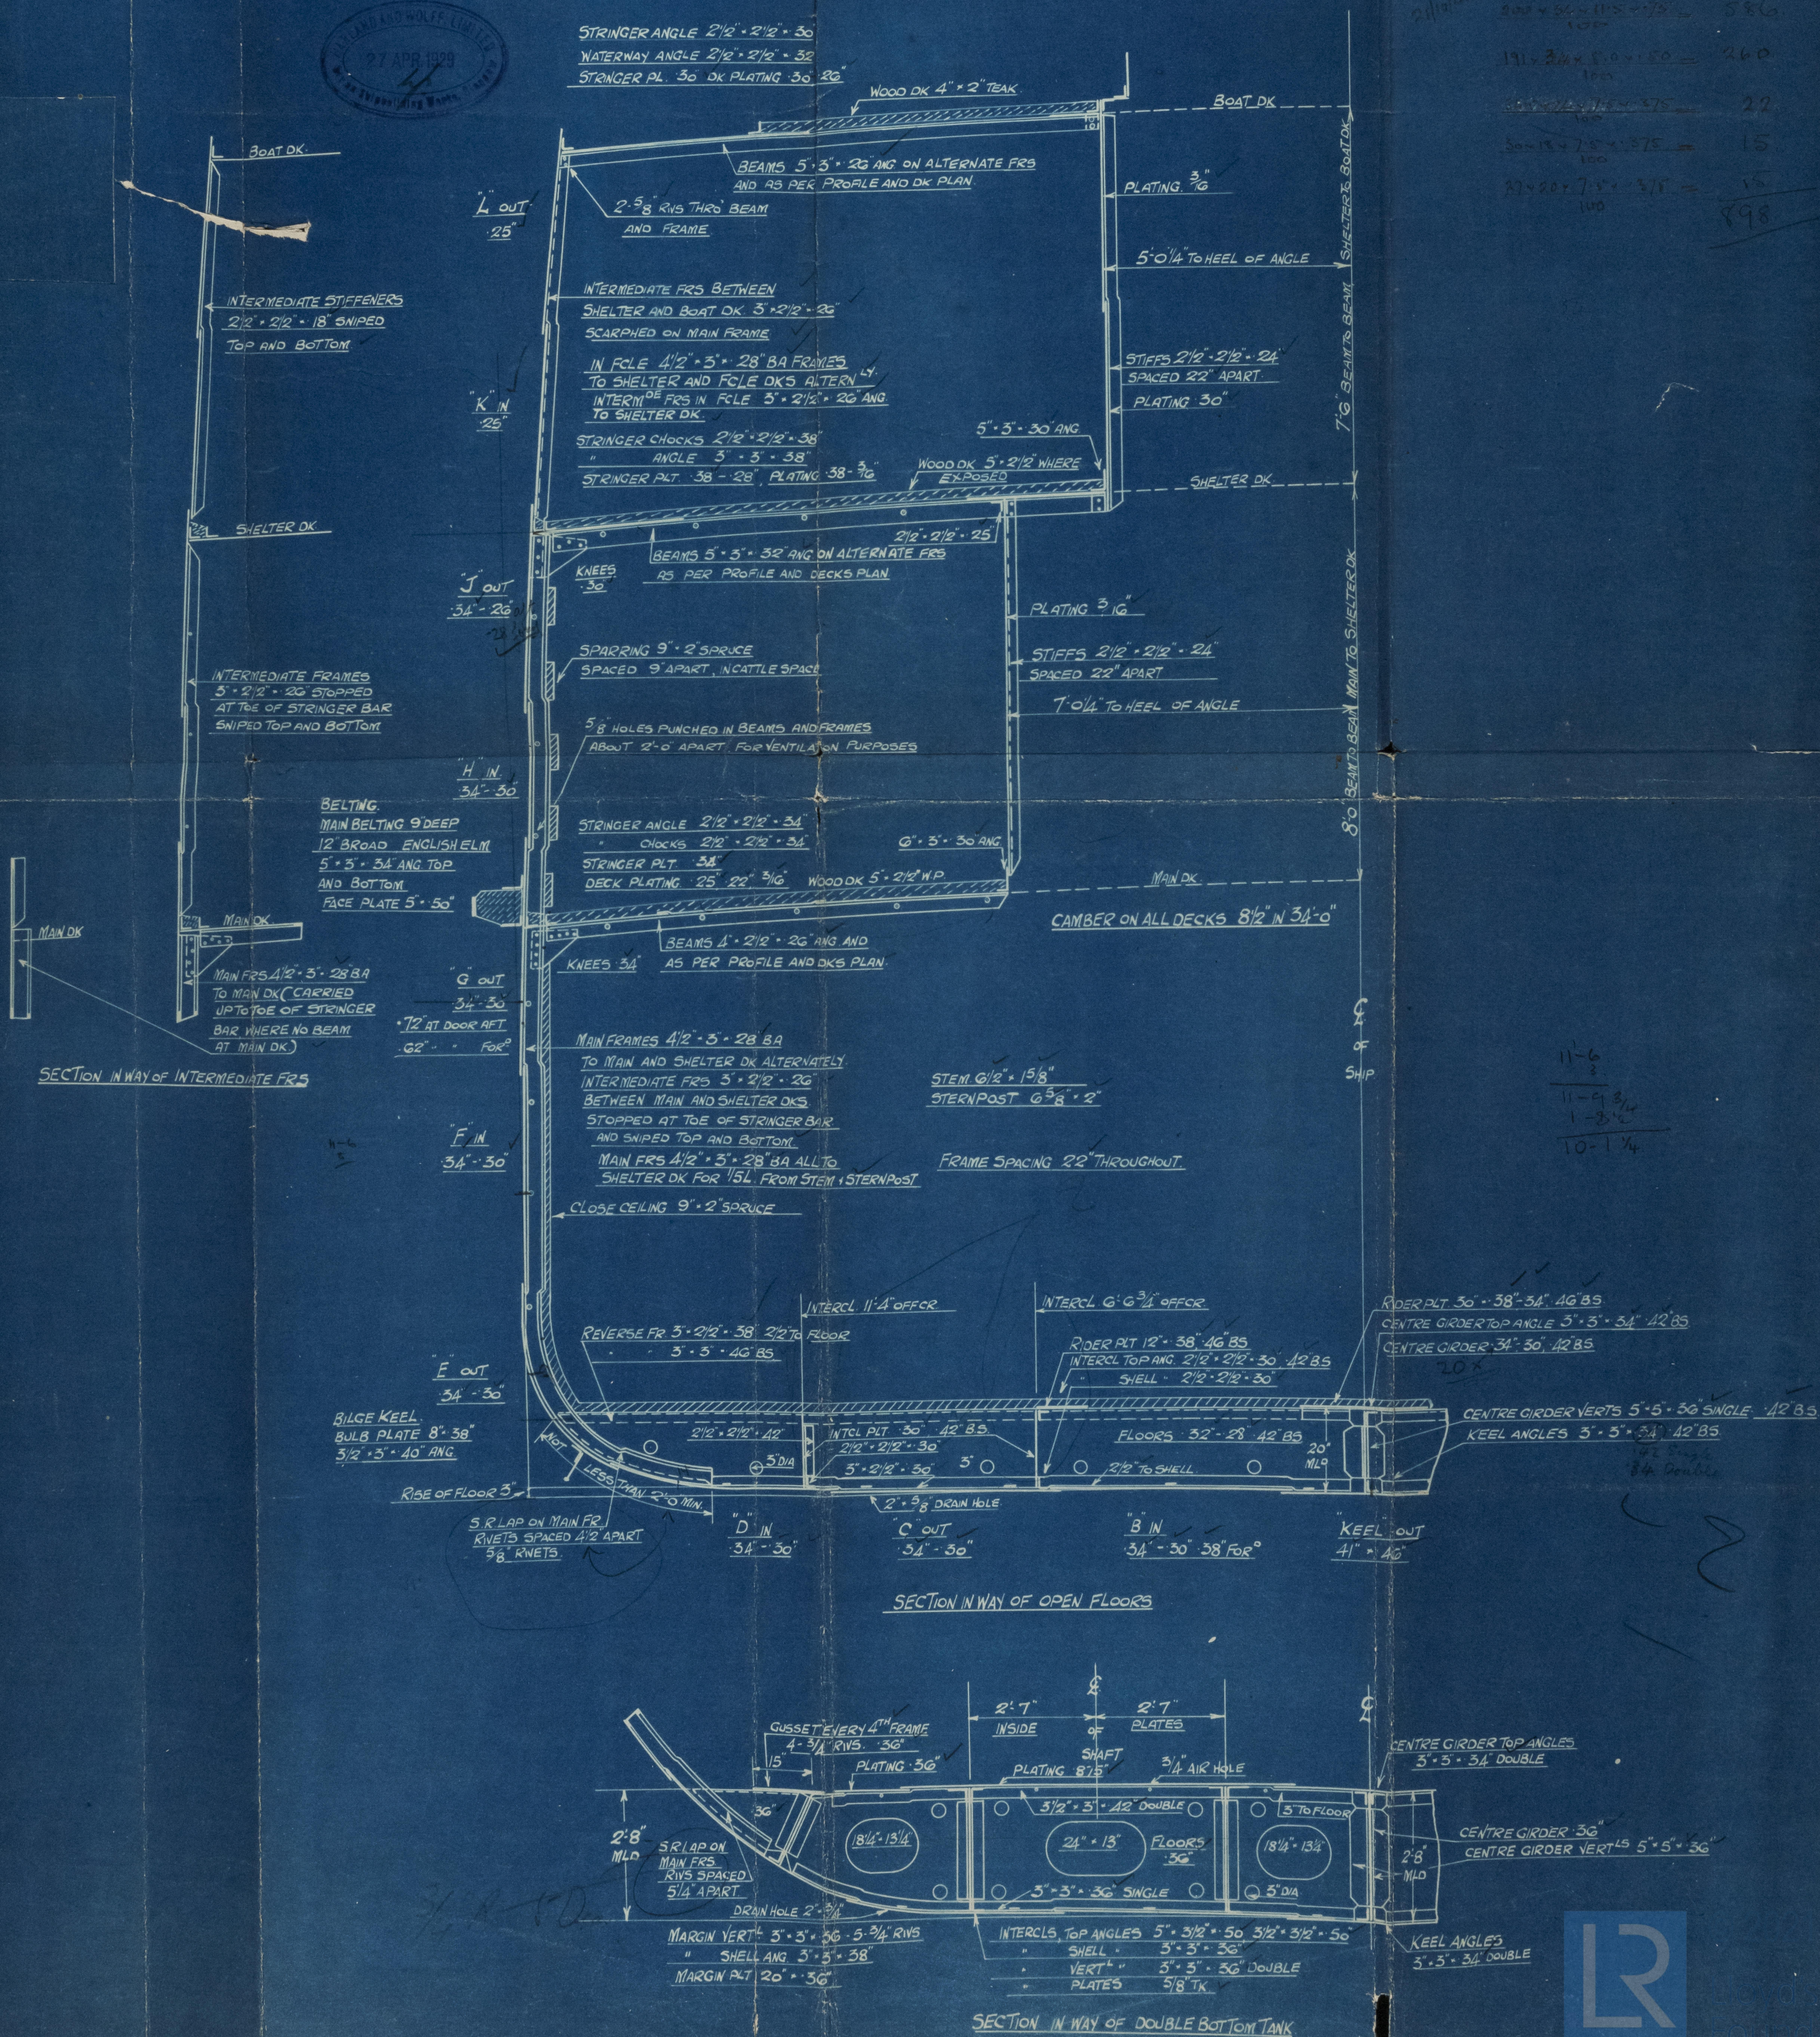

13

[FOR EQUIPMENT - SEE NOTES ON PLAN No. 1.]

Midship Section.

Harland & Wolff, Ltd.

No. 872^G

Reference.

"Lochness"



© 2021

Lloyd's Register
Foundation

011186-011196-0231