
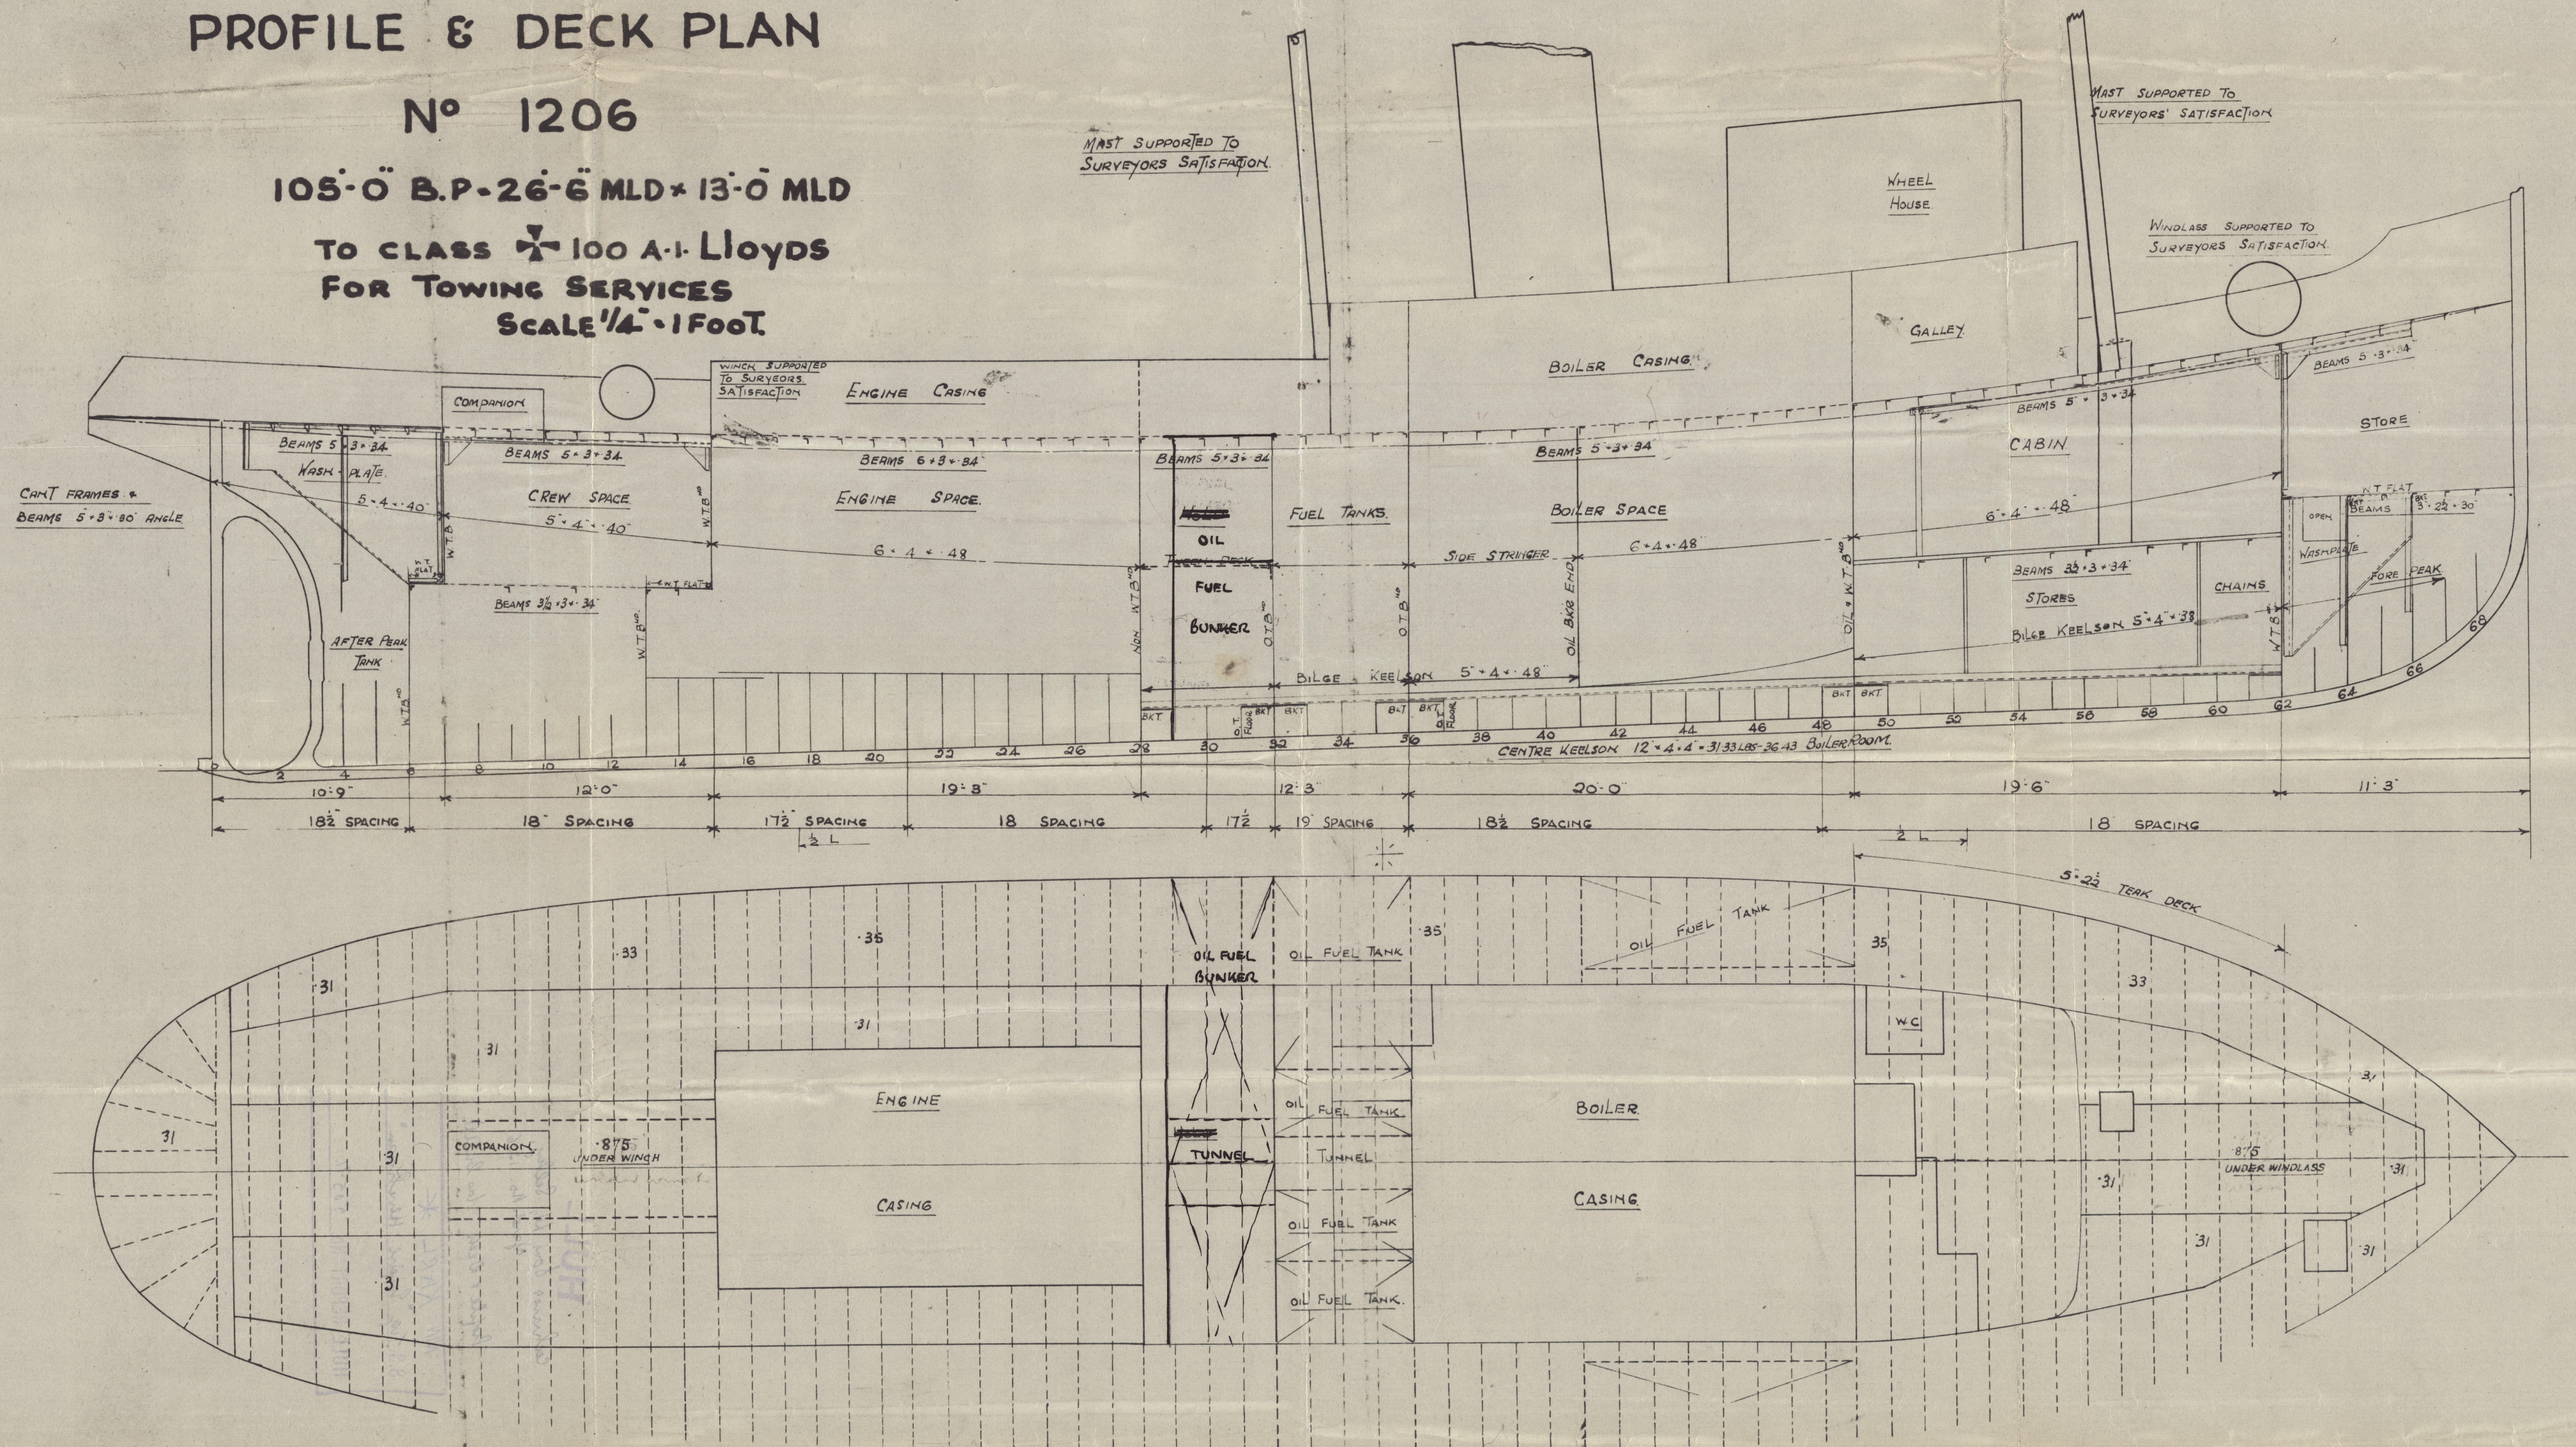


PROFILE & DECK PLAN

Nº 1206

105-Ö B.P-26-Ö MLD* 13-Ö MLD

TO CLASS  100 A-1 Lloyds
FOR TOWING SERVICES
SCALE 1/4" = 1 FOOT



HULL

Cochran & Son, Ltd., Selly.
Yard. No. 1206.

Profile & Deck (as built).

N/N KARL *

S.S. Tug. "Empire Henschman"

HULL REPORT No. 50591.



© 2019

Lloyd's Register
Foundation