


COASTAL TANKER "CHANT 58"
CONVERSION TO CARGO CARRIER
MIDSHIP SECTION

SCALE $\frac{3}{4}":1'-0"$

Call 23 JUL 1946

Approved

29.7.46

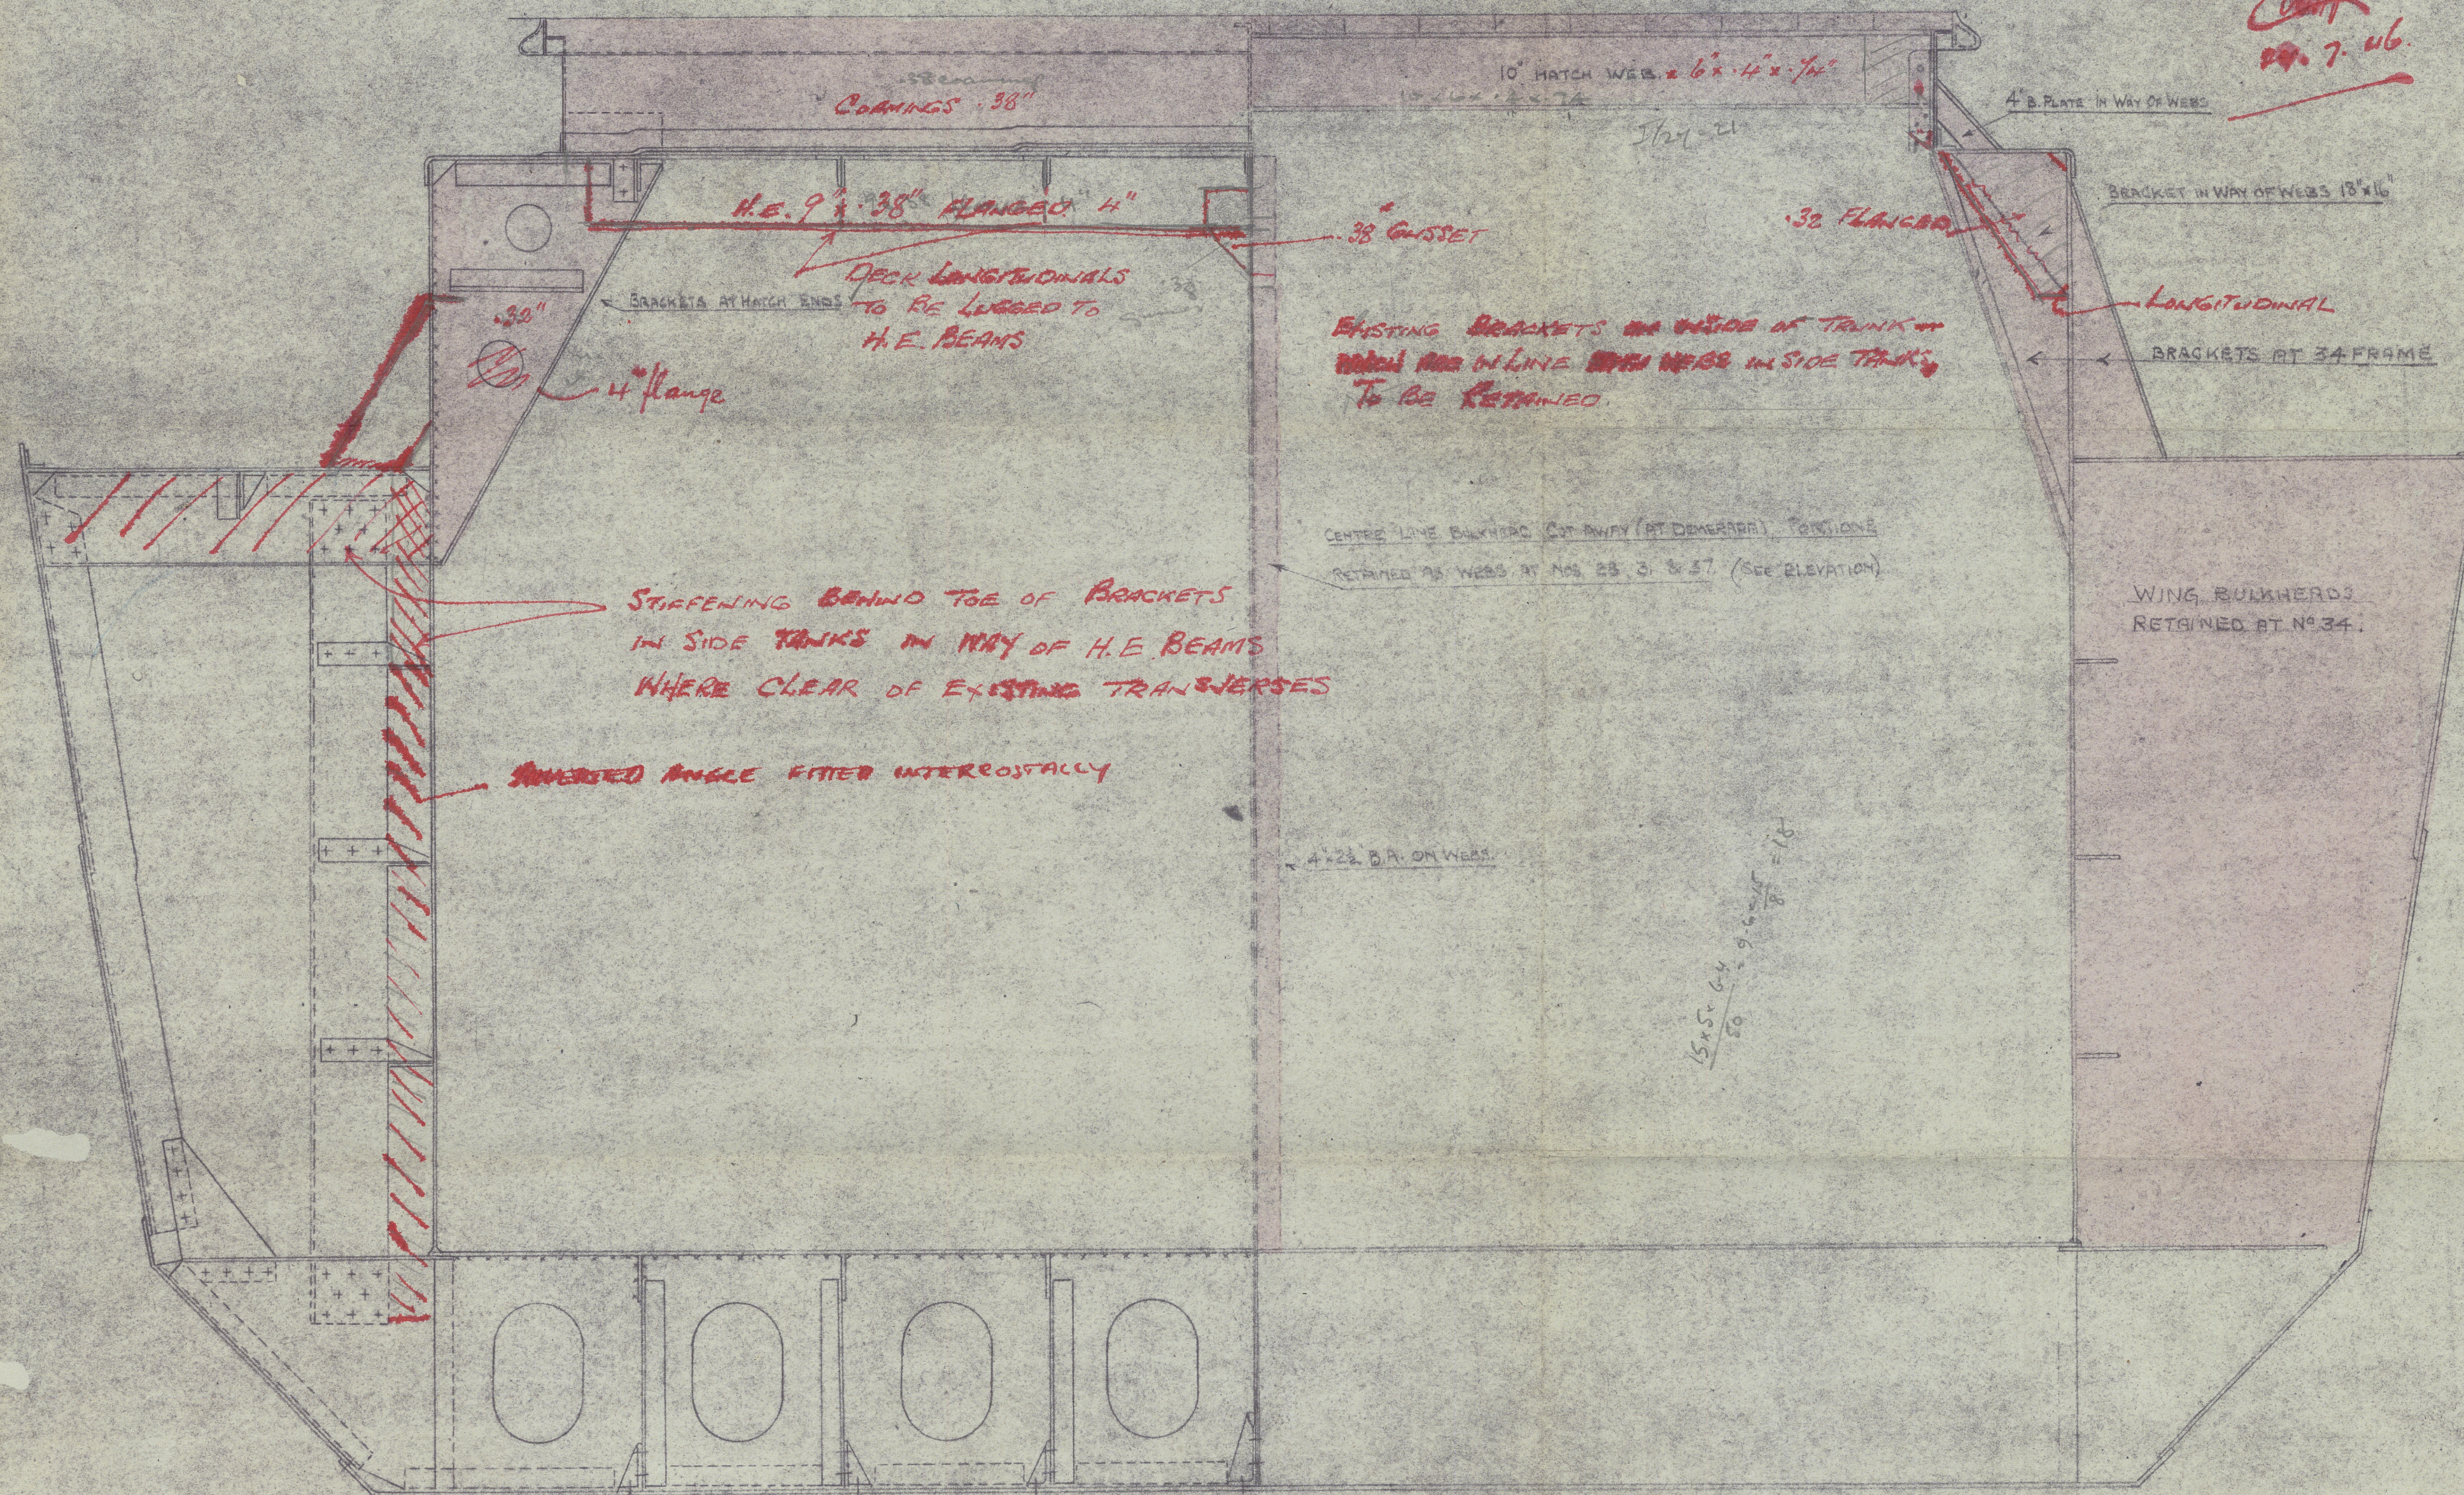

Midship section
conversion to barge Tanker
chant 58

23 JUL 1946

Bag



© 2021

Lloyd's Register
Foundation

011235-011243-0181