


SCANTLING NUMERALS	
1 1/2" " "	7168.0
1 1/2" " "	12.59 TO M.D. 9.8 TO R.Q.D.
1 1/2" " "	11.0 TO M.D. 14.75 TO R.Q.D.
EQUIPMENT No. 8100	

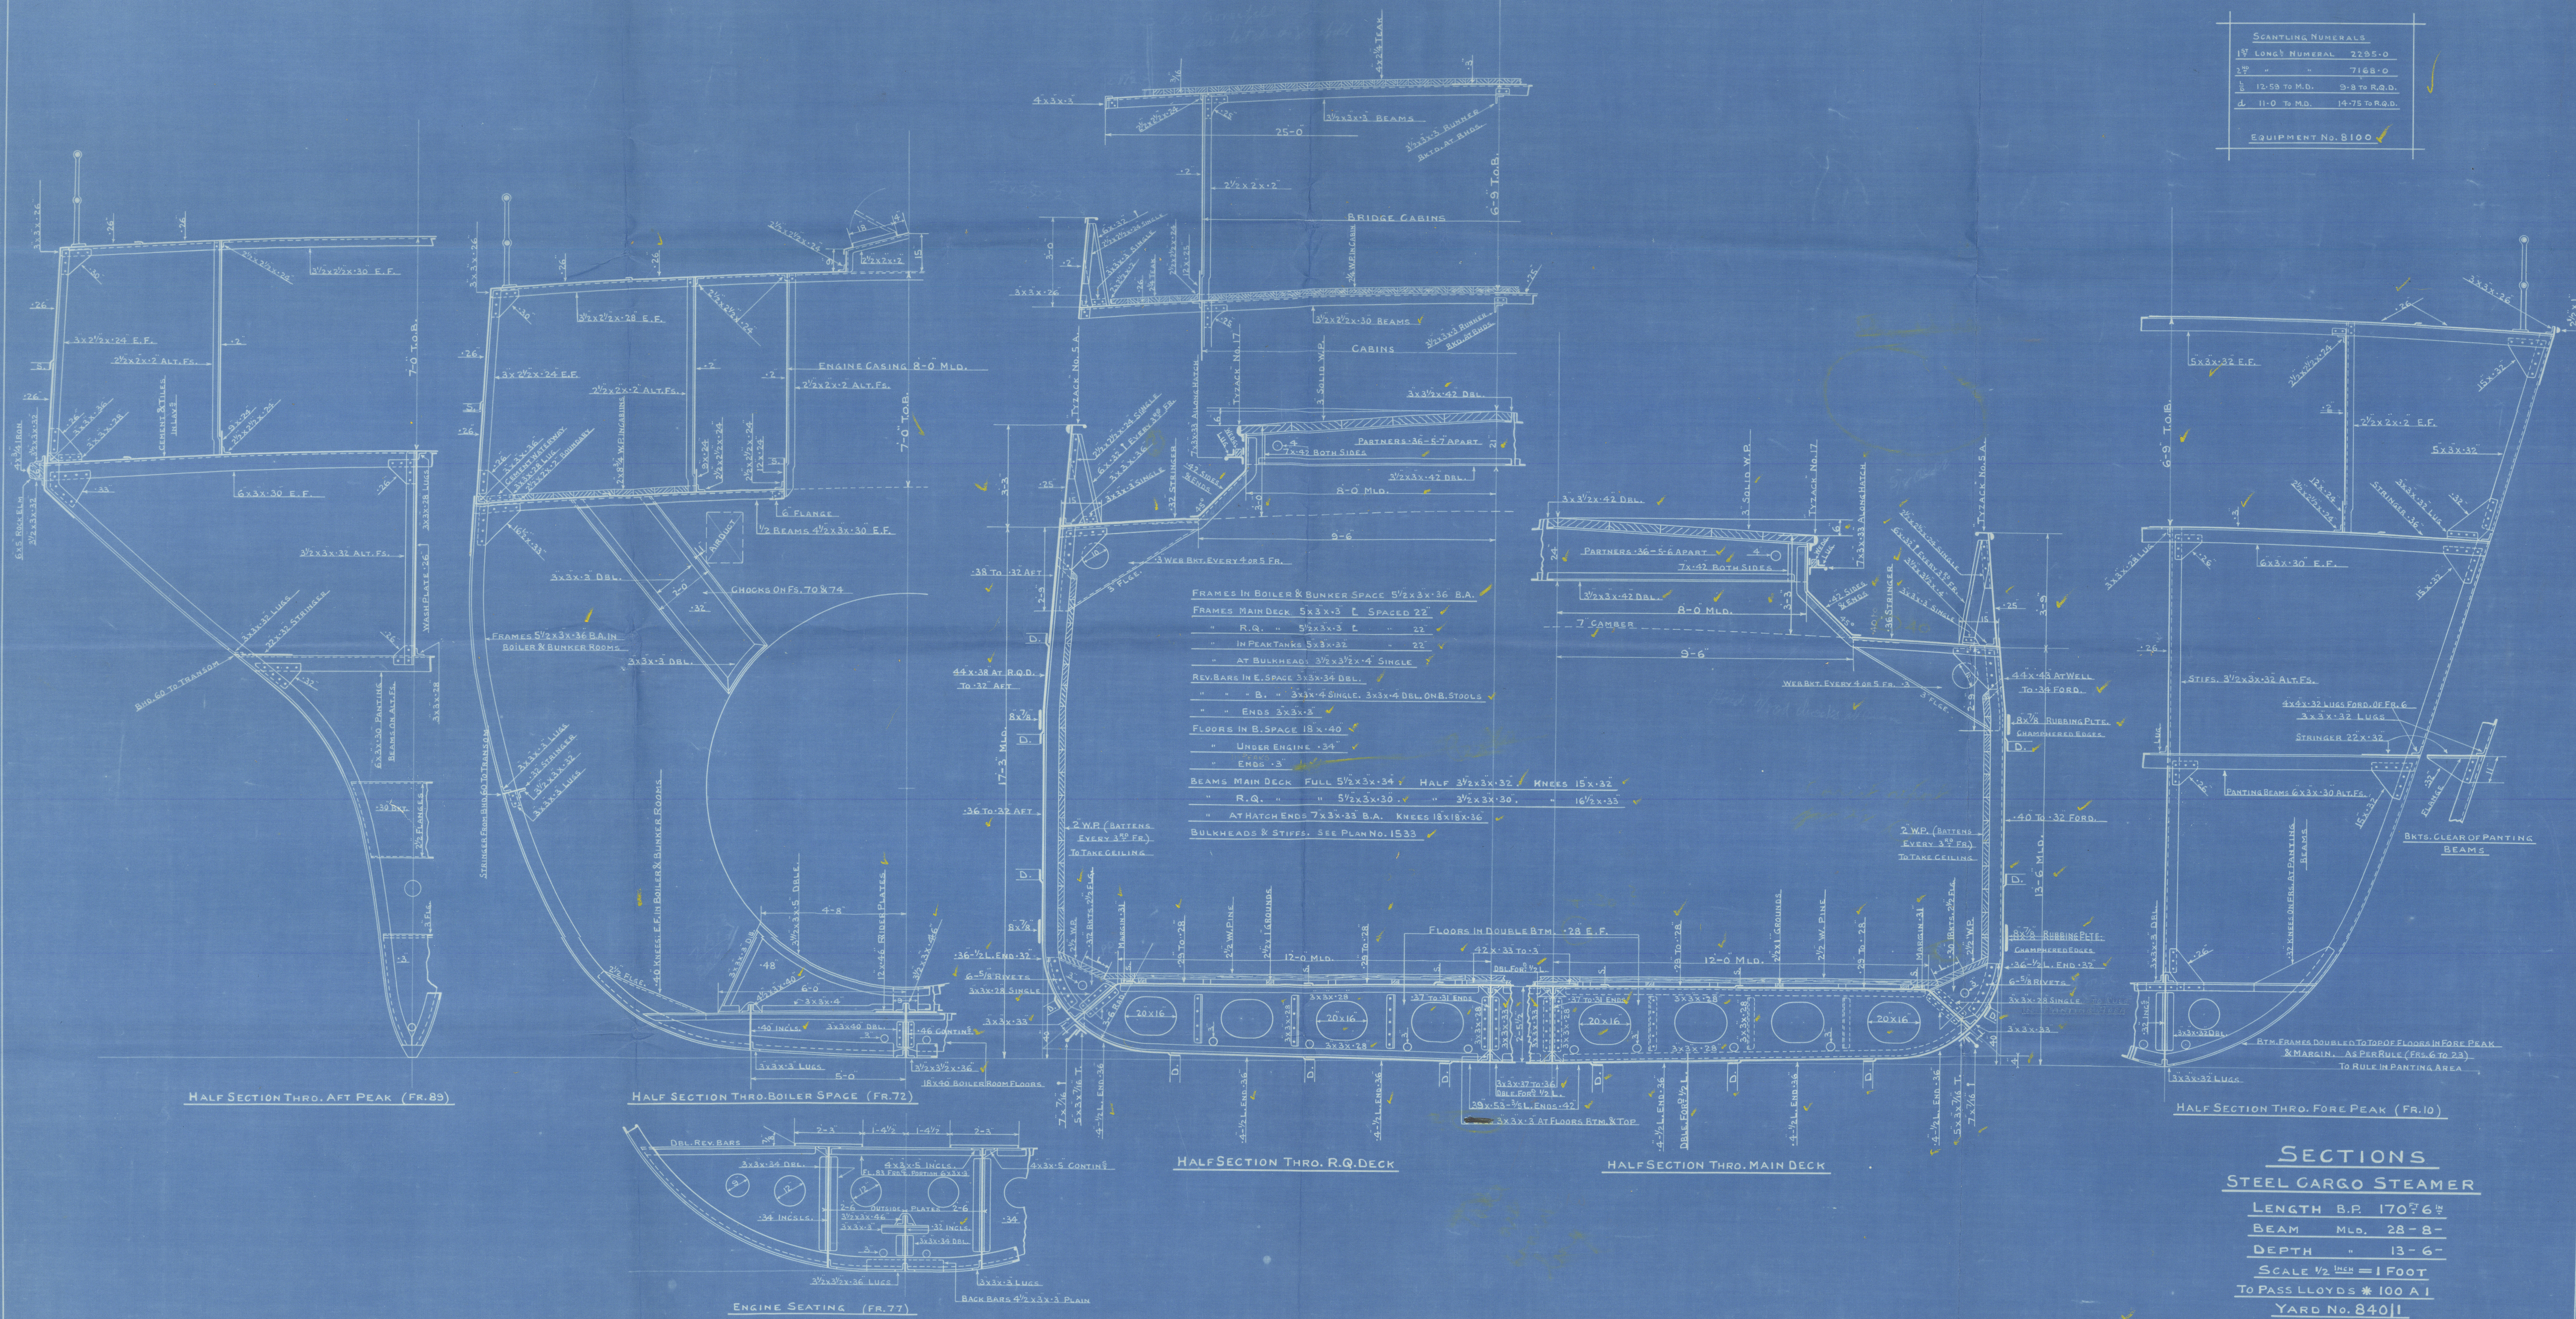

SECTIONS	
STEEL CARGO STEAMER	
LENGTH B.P.	170' 6"
BEAM	M.D. 28'-8"
DEPTH	" 13'-6"
SCALE 1/2" = 1 FOOT	
TO PASS LLOYD'S # 100 A I	
YARD No. 84011	

APPROVED BY LLOYD'S 4/2/36 AND 10/6/36



✓  
Midship Section of  
vessel as Built

S/S No. 841

Lytham S/B RE. Co Ltd

S/S BROOMFIELD



S. S. Broomfield

LIVERPOOL

Report No. 110700



© 2021

Lloyd's Register  
Foundation

011251-011258-0001