




SECTIONAL ELEVATION ON E. OF SHIP

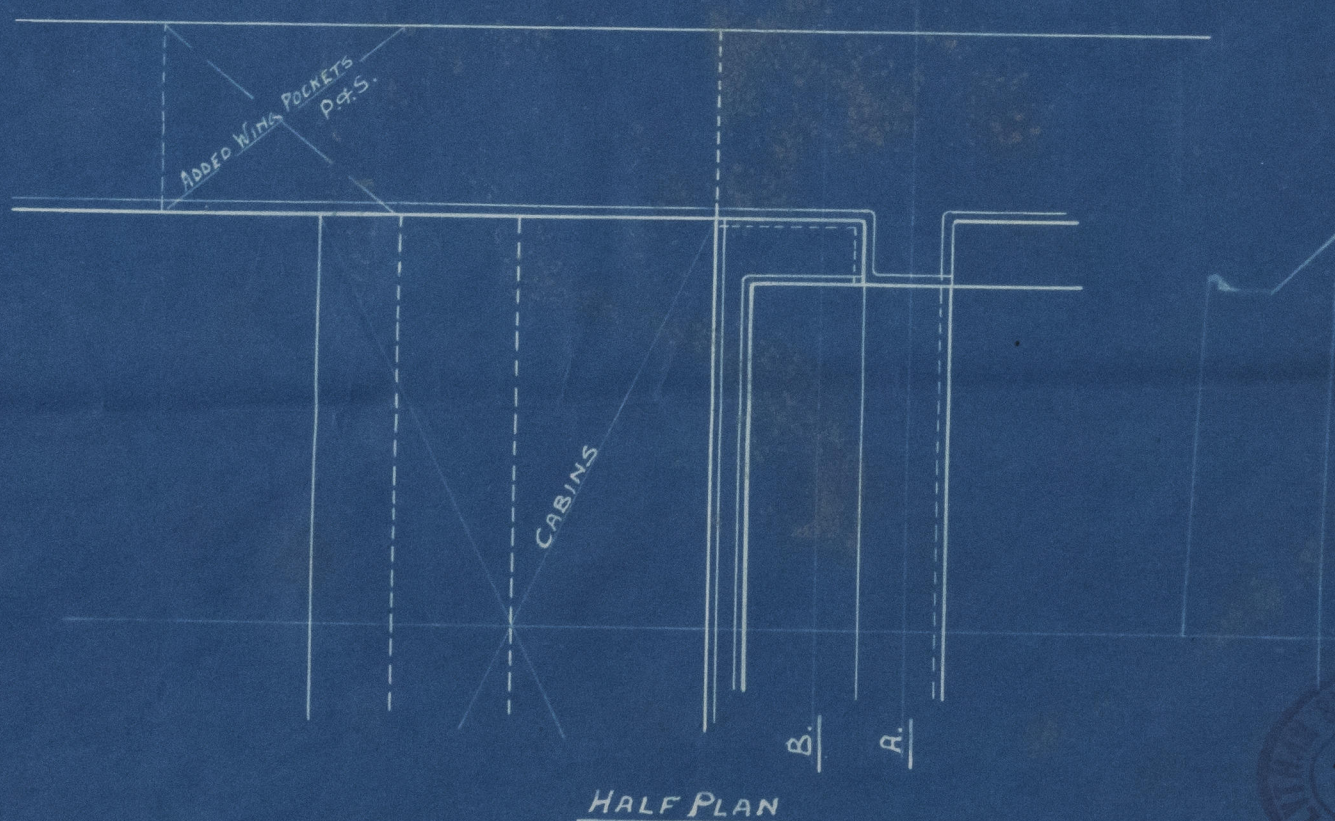

HALF PLAN

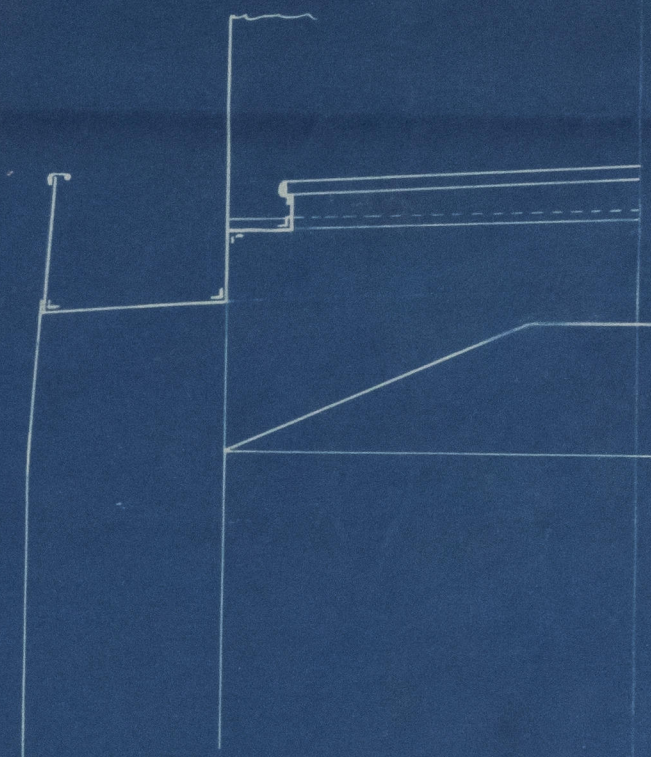


HALF SECTION AT B. LOOKING AFT

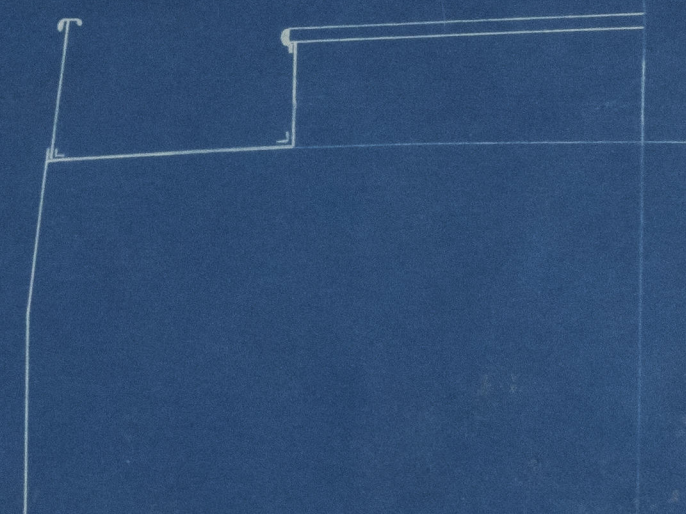

HALF SECTION AT A. LOOKING AFT

PROPOSED NEW ARRANGEMENT  
OF BUNKER HATCH  
S/S. "BROOMFIELD"  
SCALE 1/4" = 1 FOOT

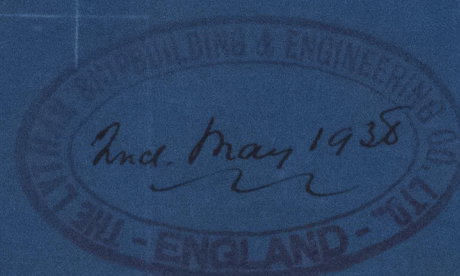

Lloyd's Register  
 Foundation



24

SAI only  
Alteration to  
Books

S. S. Broomfield

LIVERPOOL:

Report No. 110700



© 2021

Lloyd's Register  
Foundation

011251-011258-0002