
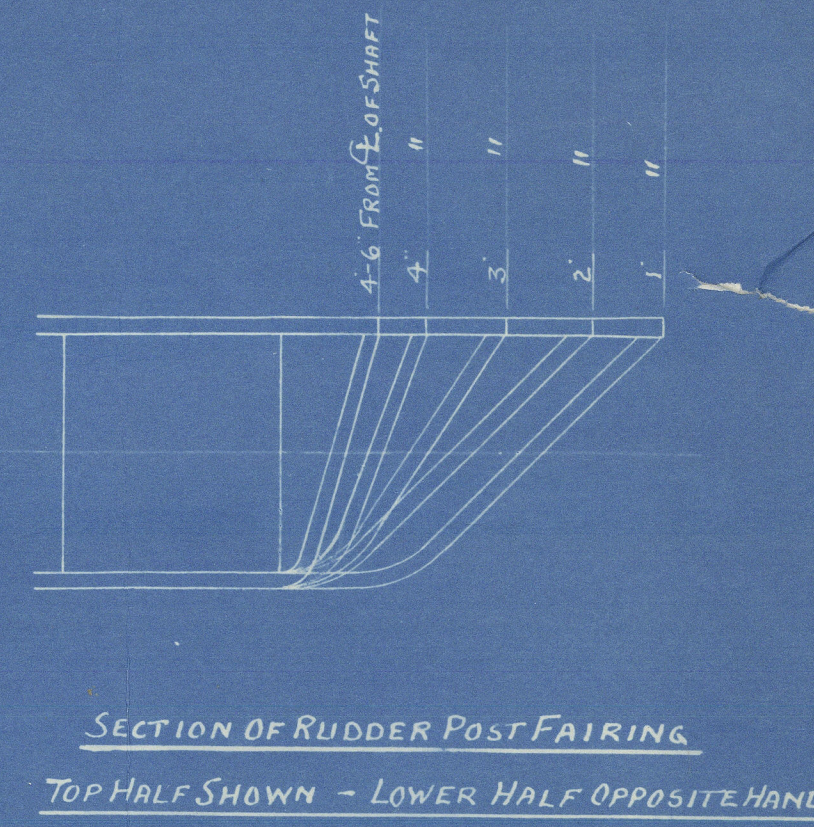
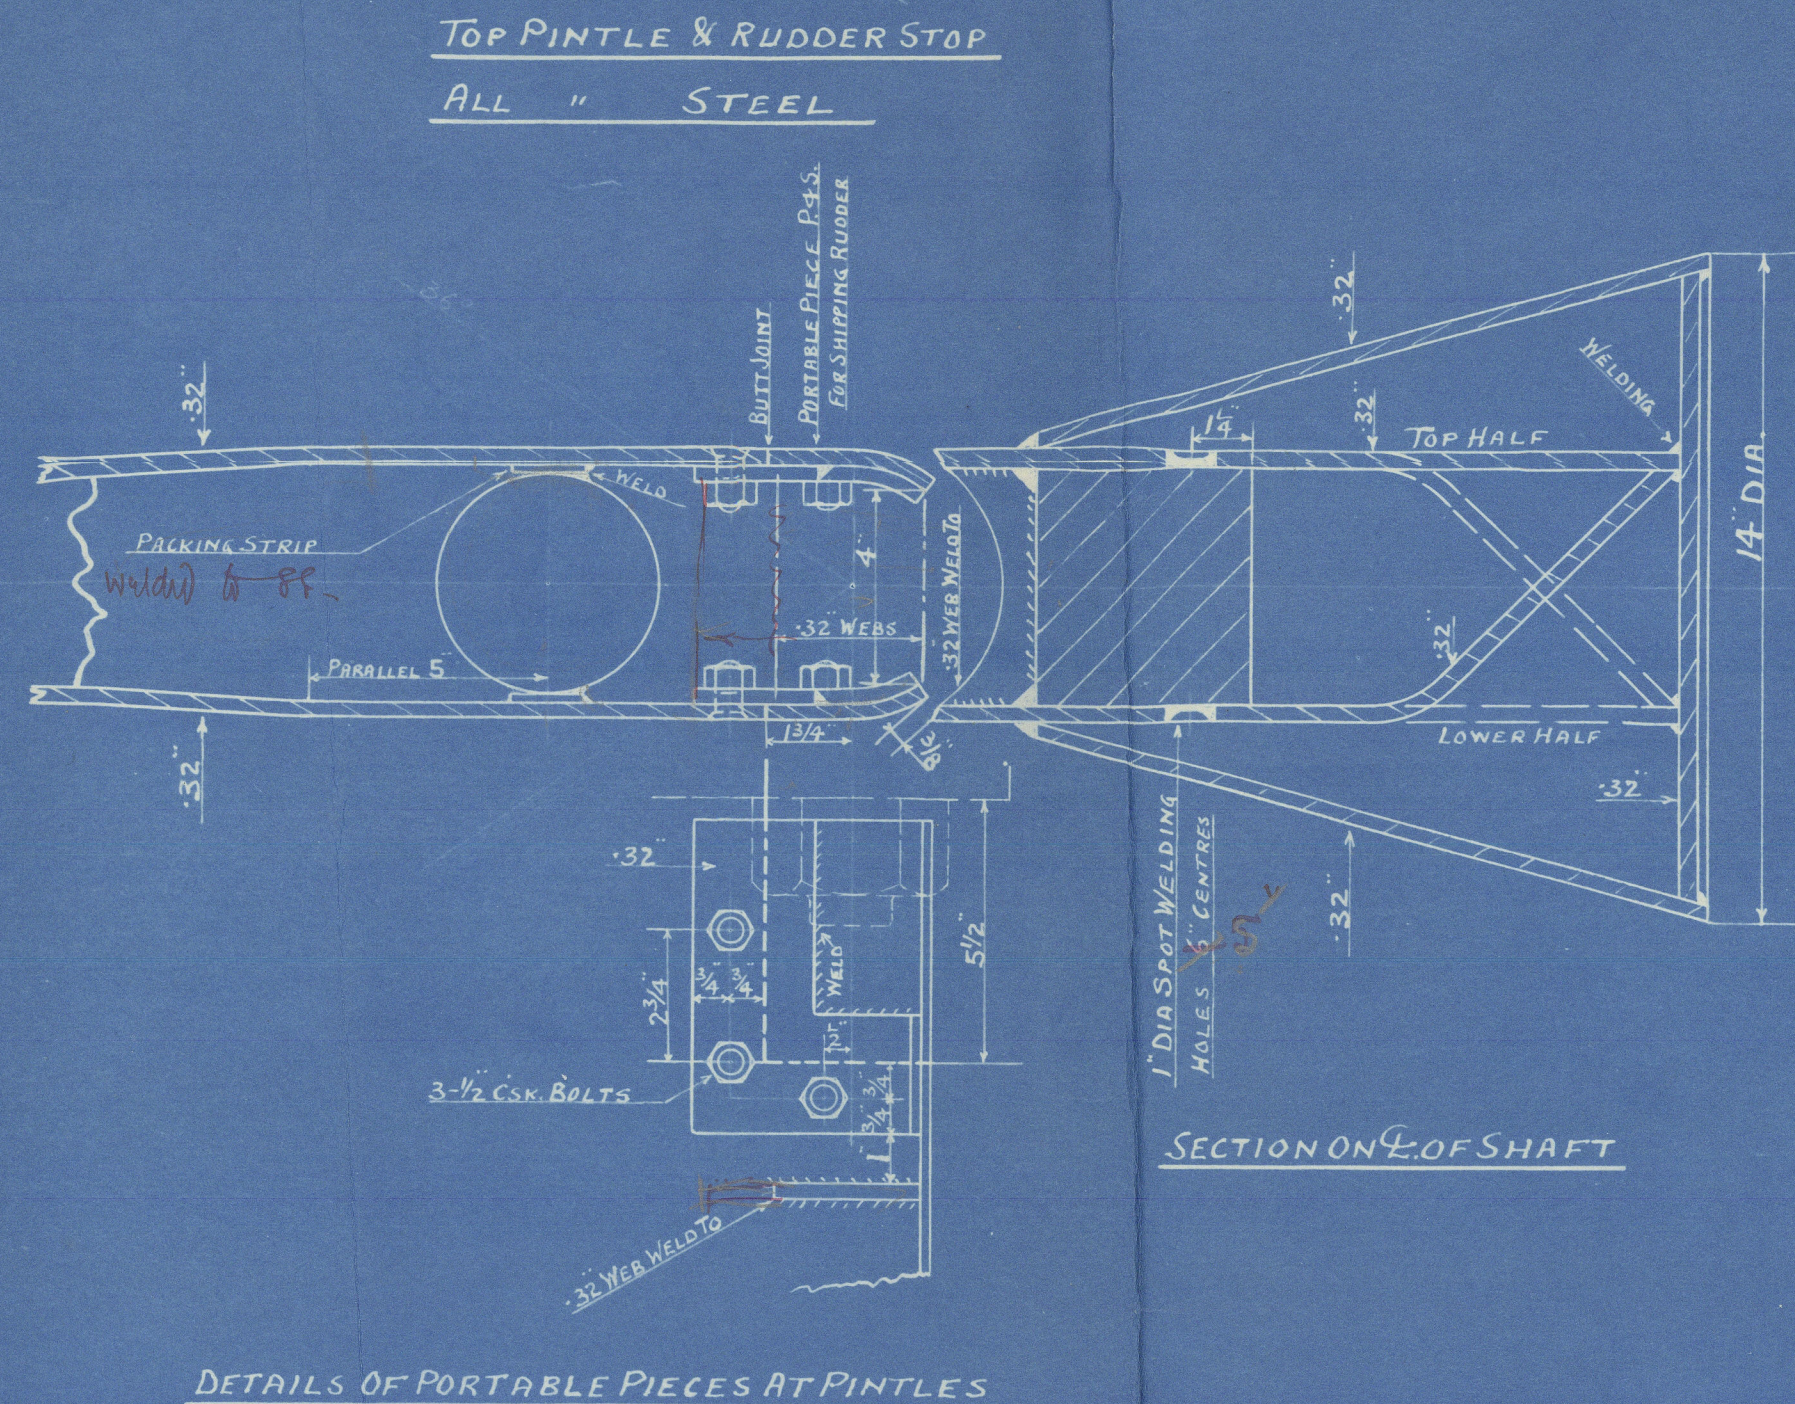
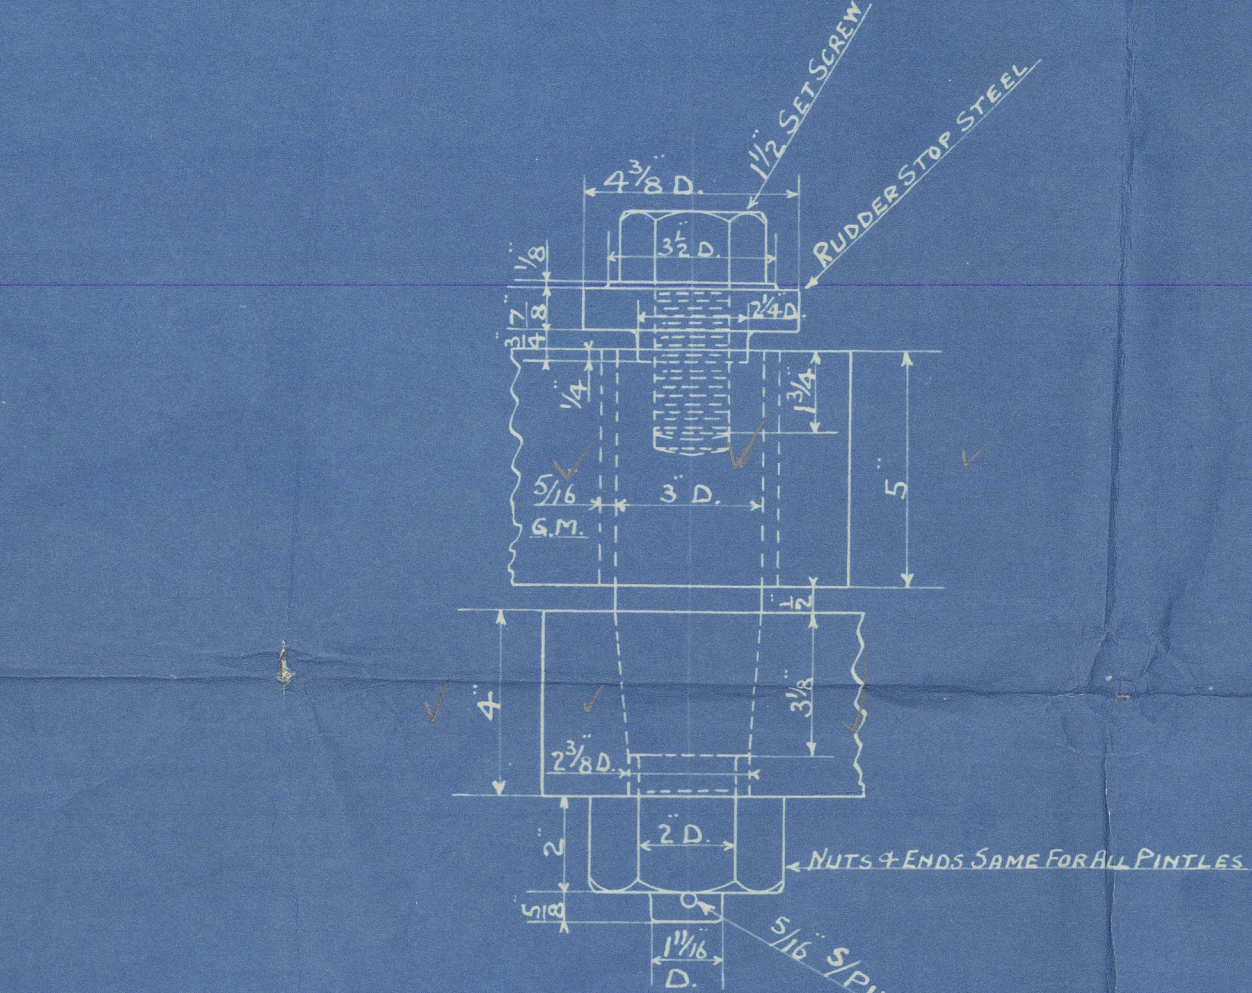
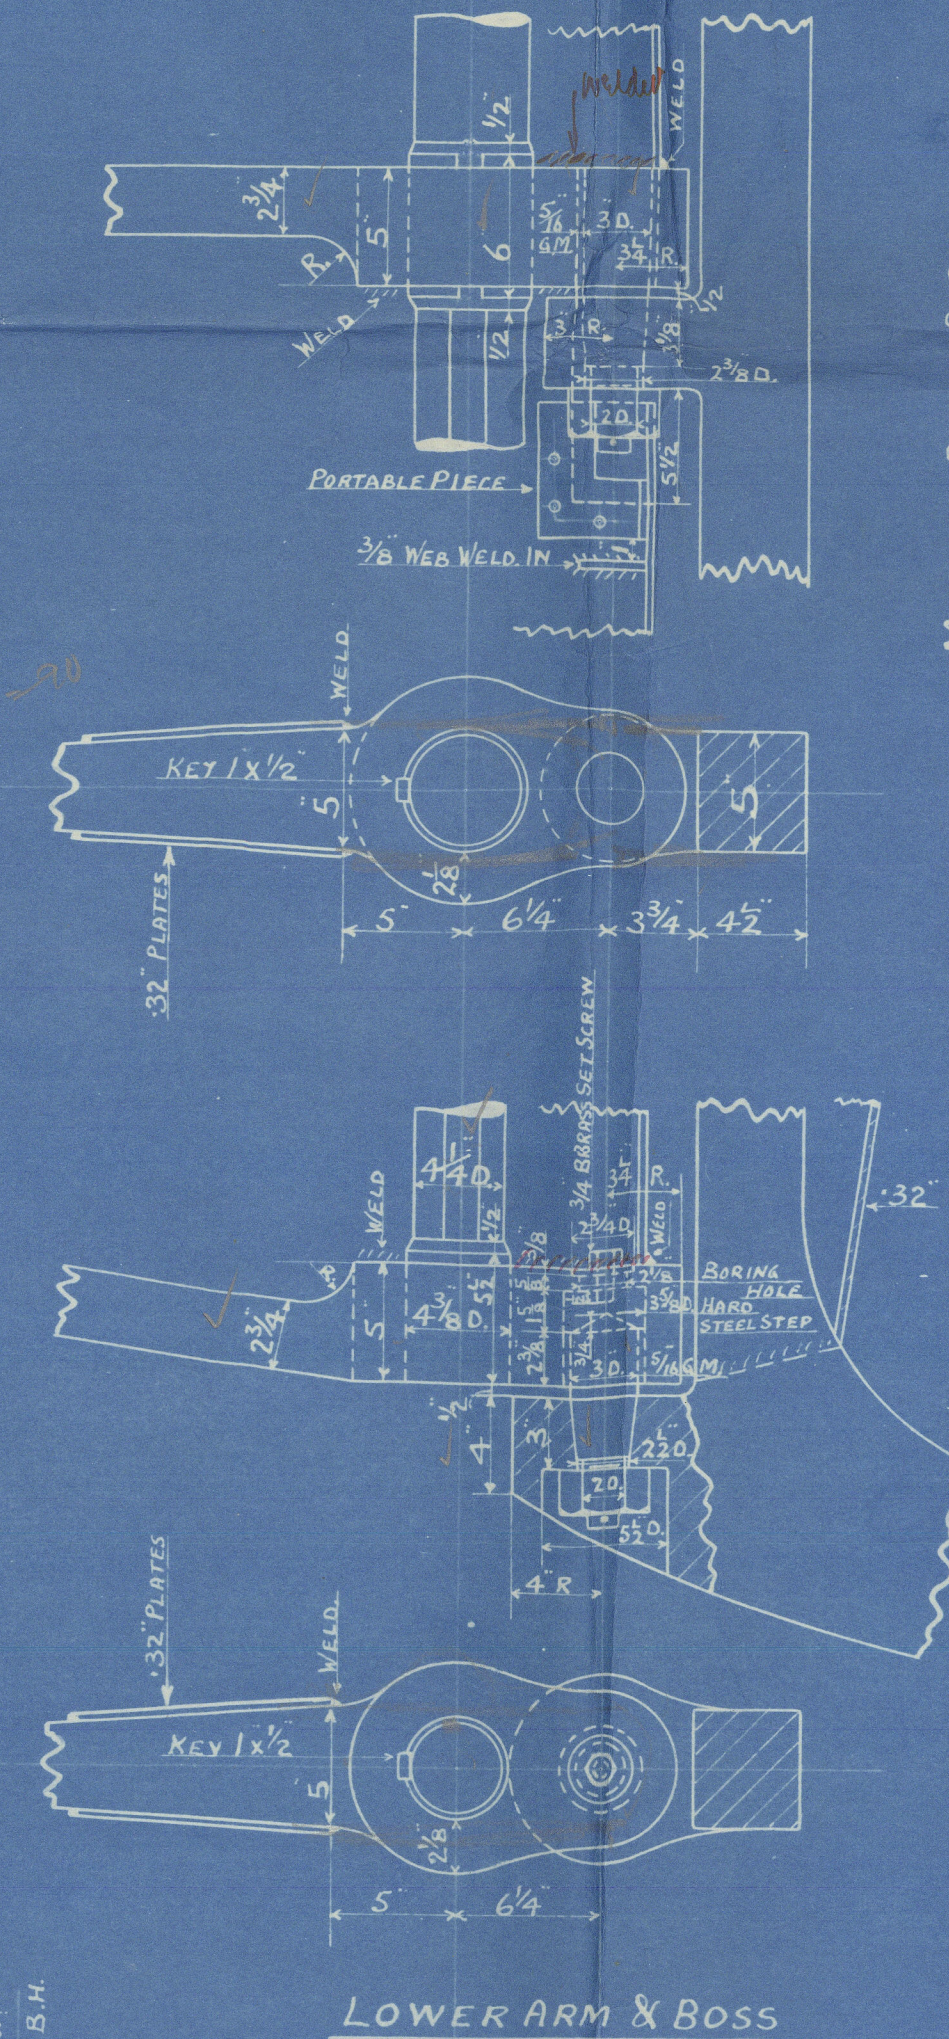
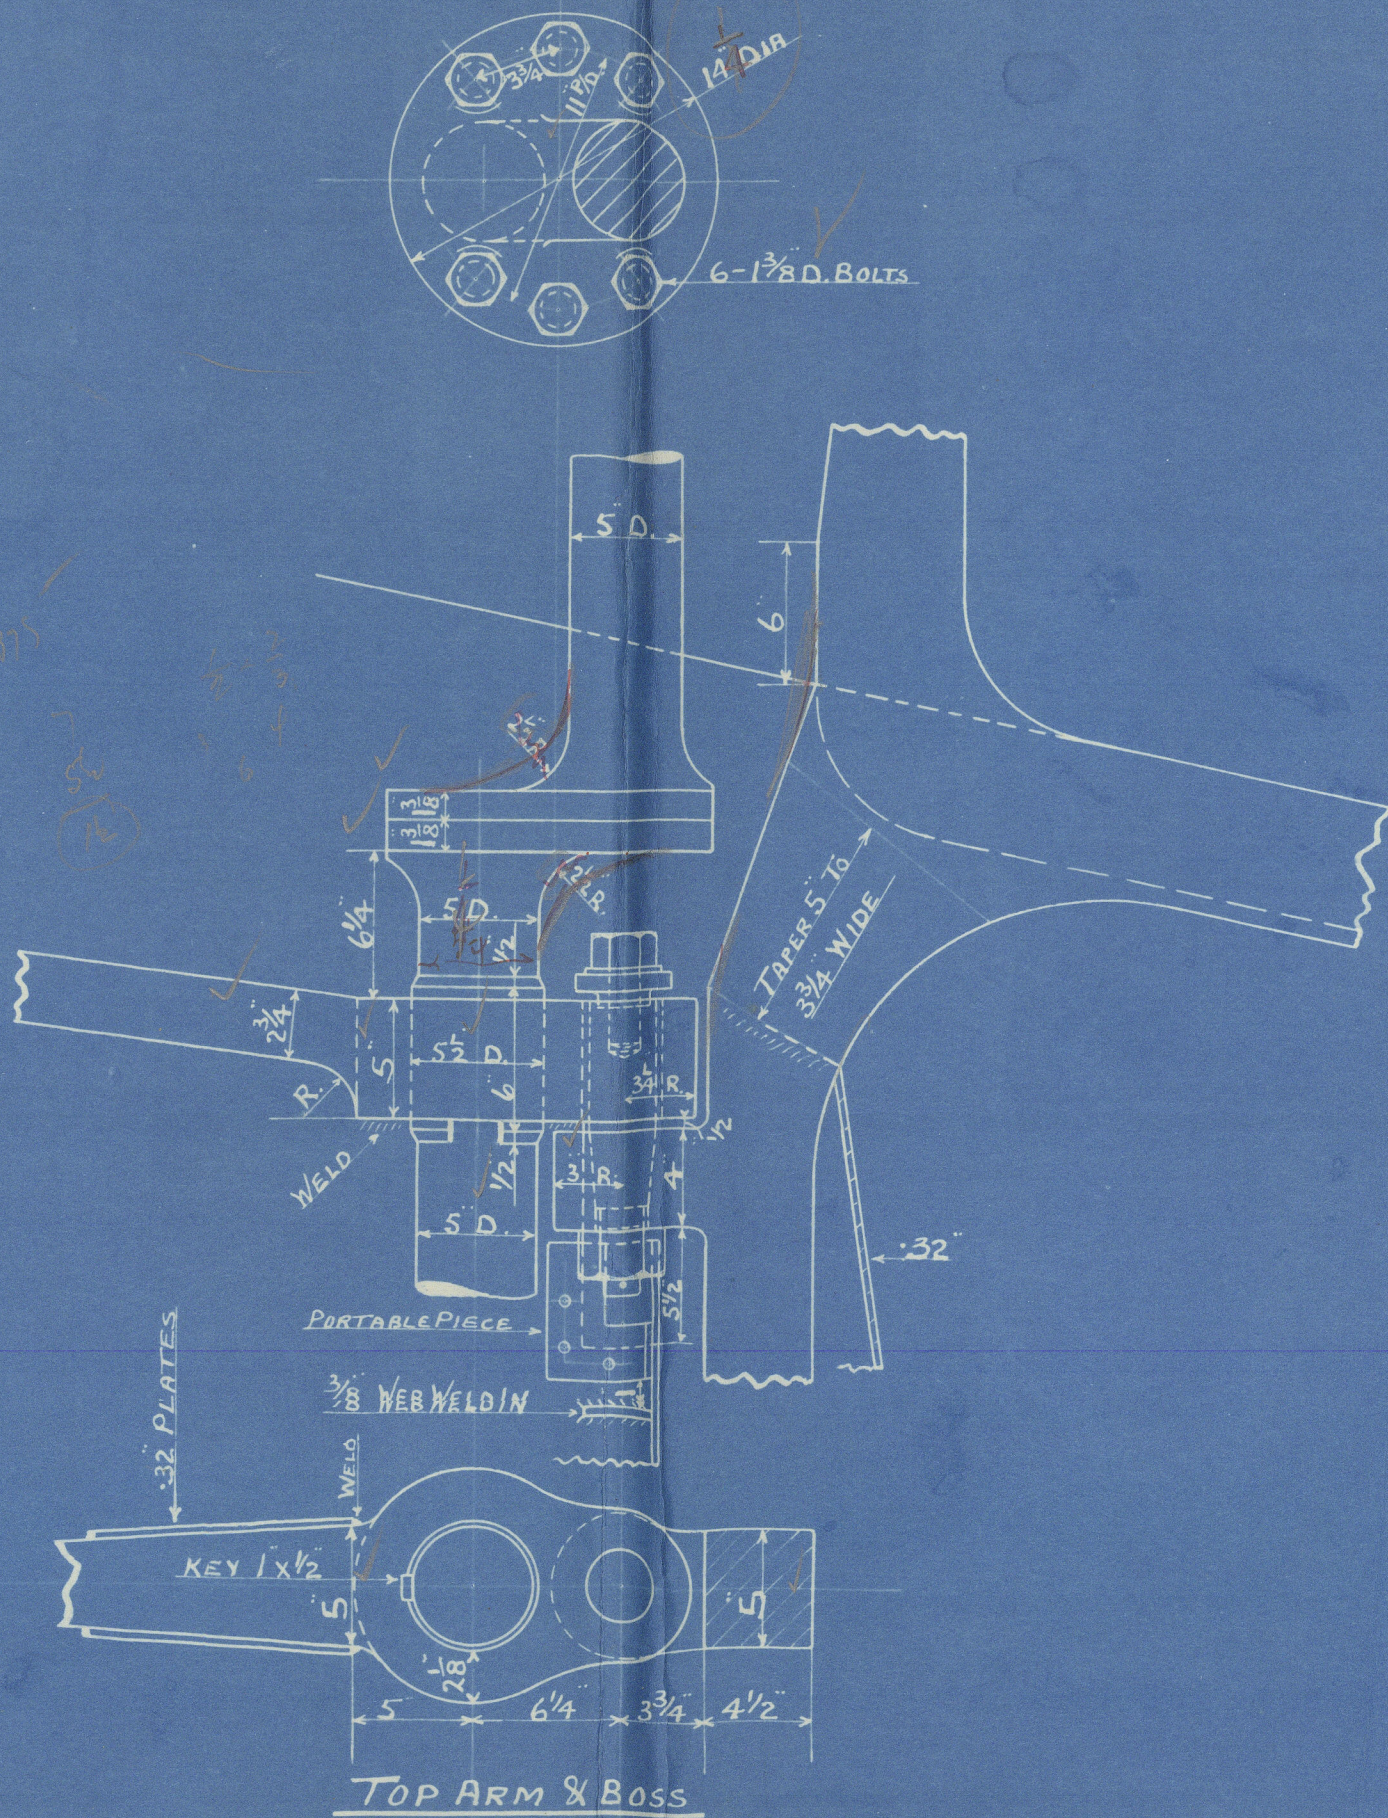


TRACING No. 1534 B.

FOR DETAILS OF UPPER RUDDER STOCK
& QUADRANT ARM SEE FLY TO
TRACING No. 1534 A.

on account of length shorter supports
3" from center
(18")

$$A \times D = 43.3 \times 2.125 = 92.012$$

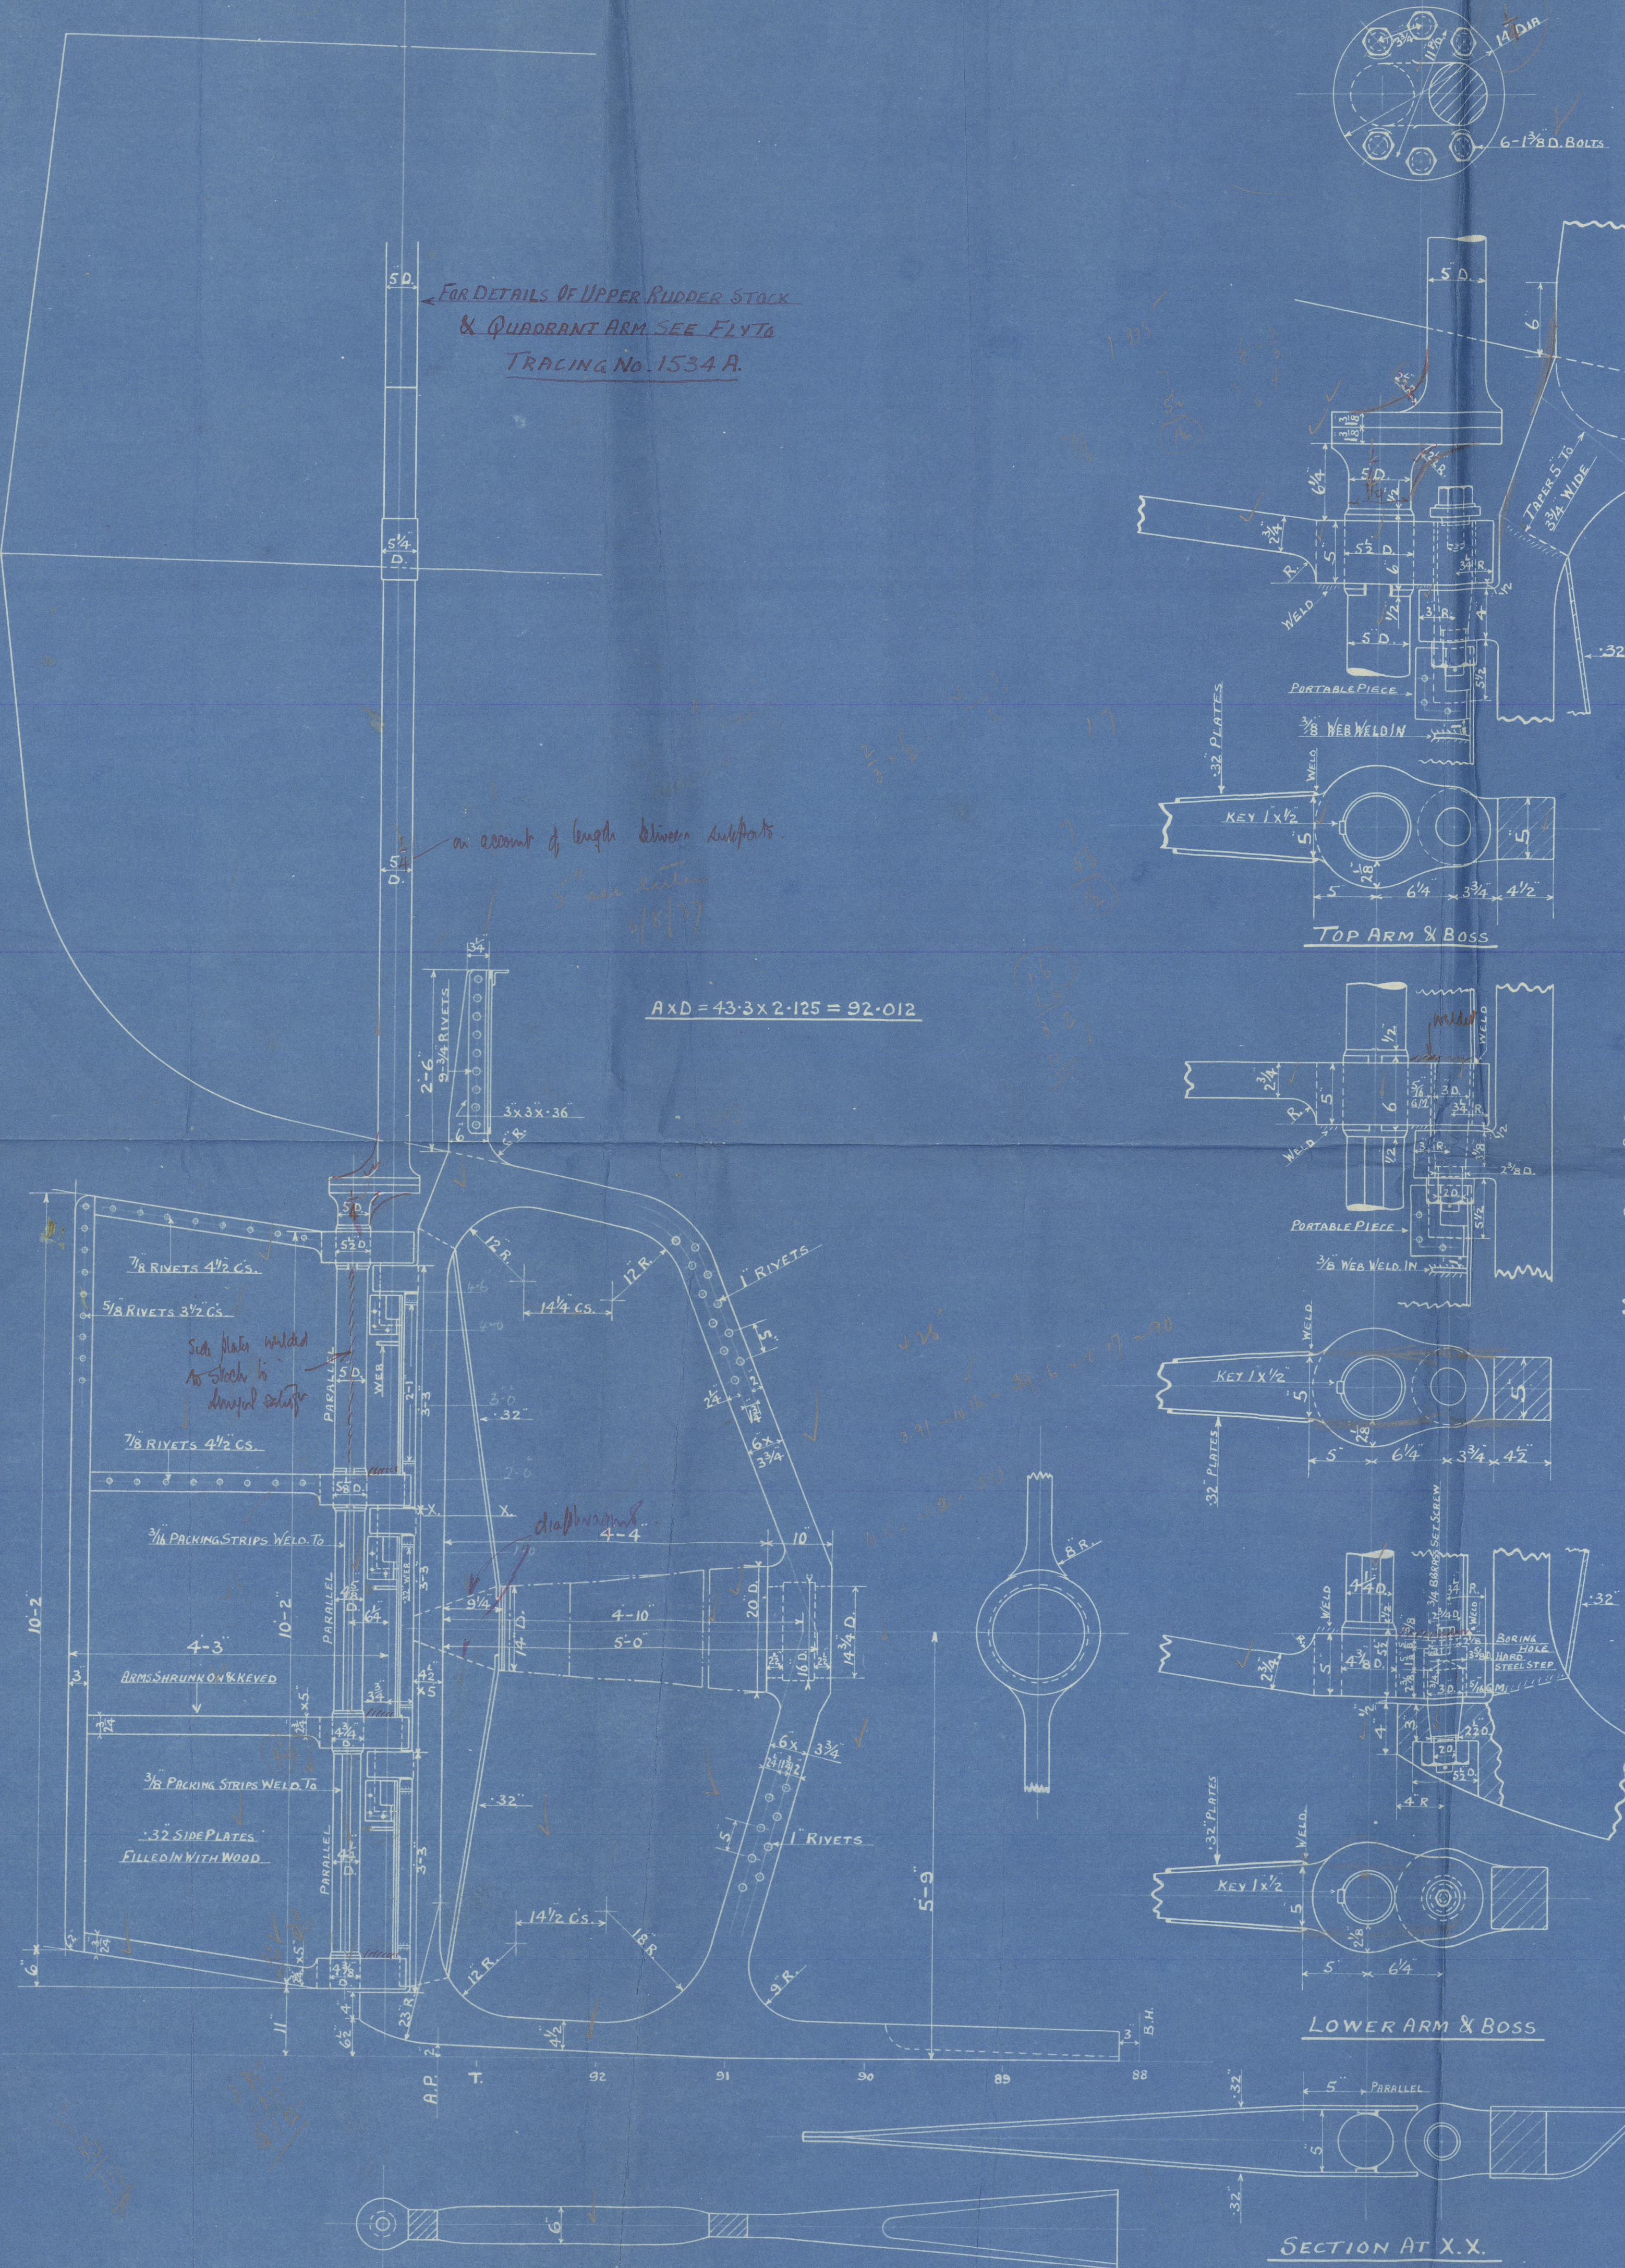

STERN FRAME & RUDDER
SHIP No. 841
SCALES 3/4", 1/2", 3/8" = 1 FOOT

July 15th 1933
M. J. L. - ENGLAND -

27-7-37

~~10 A~~

~~"BRACKENFIELD"~~
841" BROOMFIELD"

Lyrkan 840

P. L. R.

21



© 2021

Lloyd's Register
Foundation

011251-011258-0004