

Lloyd's Register of Shipping.


SURVEYS FOR FREEBOARD.

(CONDITIONS OF ASSIGNMENT.)

Supplement to
 Liverpool Rpt
 No 2181. Feb.

Ship's Name S/S BROOMFIELD. (S/S No 871) Port of Survey Lytham (Liverpool Sea)
Lytham S.B.T.E.C.
 Official Number _____ Surveyor's Signature T. Webb
 Nationality and Port of Registry Liverpool British Date of Survey during construction

Disposition and dimensions of superstructures, trunks, deckhouses and machinery casings to be inserted in the diagrams and tabular statement: -

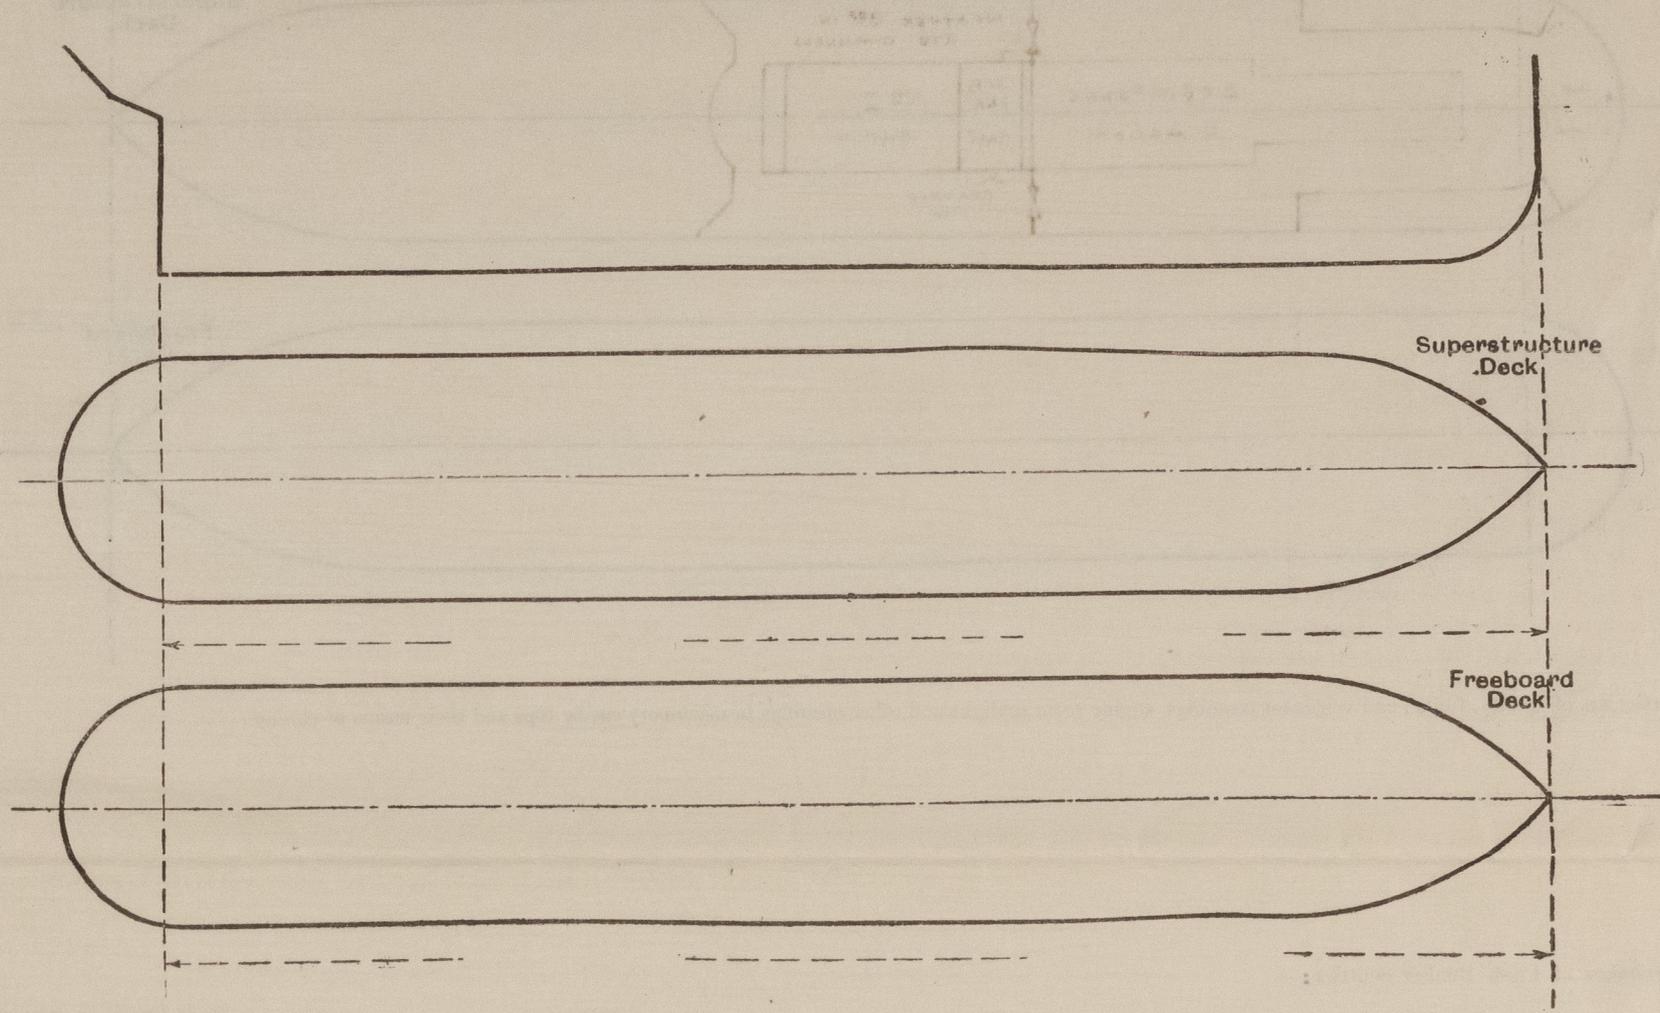


Particulars of Superstructures, Trunks, Casings, Deckhouses.

	Coaming	Plating	Stiffeners	Spacing	End Attachments of Stiffeners	Size of Openings	Height of Sills	Height of Casings
Poop Bulkhead								
Raised Quarter Deck Bulkhead ...								
Bridge, After Bulkhead								
Bridge, Forward Bulkhead								
Forecastle Bulkhead								
Trunk, Aft								
Trunk, Forward								
Exposed Machinery Casings on Freeboard or Raised Quarter Decks ...								
Exposed Machinery Casings on Superstructure Decks								
Machinery Casings within Superstructures not fitted with Class I Closing Appliances								
Deckhouses on Flush Deck Ships ...								

Particulars of Closing Appliances (state if capable of being manipulated from both sides).


Poop Bulkhead	
Raised Quarter Deck Bulkhead ...	
Bridge, After Bulkhead	
Bridge, Forward Bulkhead	
Forecastle Bulkhead	
Exposed Machinery Casings on Freeboard or Raised Quarter Decks ...	
Exposed Machinery Casings on Superstructure Decks	
Machinery Casings within Superstructures not fitted with Class I Closing Appliances	
Deckhouses on Flush Deck Ships ...	

This report refers only to certain alterations which have been embodied in the original Rpt G11
 R.S.B.
 26/3/38

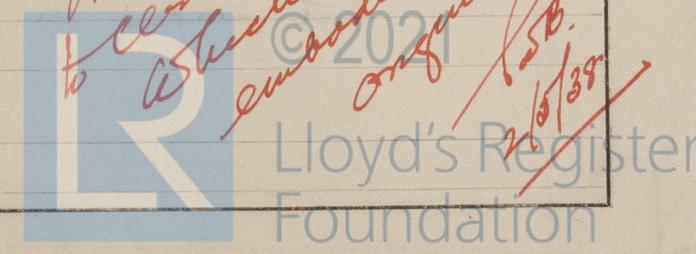

PARTICULARS OF PROTECTION TO OPENINGS, ETC.

The following diagrams should be used to indicate the positions of cargo and coaling hatchways, gangway, cargo and coaling ports, ventilators, companionways, etc., which would affect the seaworthiness of the ship:—

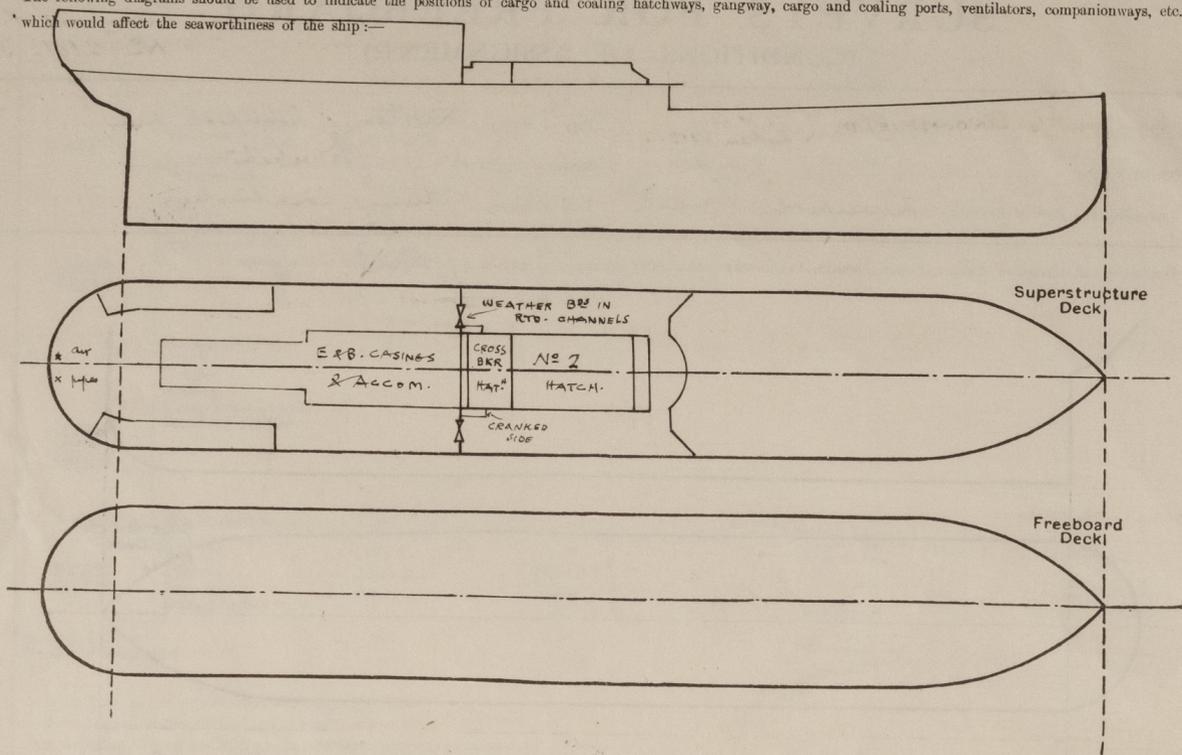

Particulars of fiddle, funnel and ventilator coamings, engine room skylight and other openings in machinery casing tops and their means of closing:—

Particulars of Flush Bunker Scuttles:—

Particulars of Companionways:—

Particulars of Ventilators in exposed positions on freeboard and superstructure decks:—

Plugs & canvas covers fitted

Particulars of Air Pipes in exposed positions on freeboard, raised quarter, or superstructure decks:—

Plugs & Canvas covers provided after peak air pipe not secured cap now as previously reported. A second air pipe has now been fitted to after peak 2 1/2" dia x 34" high

Particulars of Gangway Cargo and Coaling Ports:—

Particulars of Scuppers and Sanitary Discharge Pipes:—

Particulars of Side Scuttles:—

Vertical distance of Sill of lowest Side Scuttle above top of keel

Particulars of Guard Rails:—

Particulars of Gangways, Lifelines, etc.:—

Lifelines fitted in fore well. — Satisfactory

Particulars of Freeing Arrangements.

	Length of Bulwark	Height of Bulwark	Size of Freeing Ports	Number each side	Area each side	Rule area each side
After Well						
Forward Well						

State position of each freeing port (After Well:—
(F. and A. position and height above deck edge) (Forward Well:—

State whether the freeing ports are fitted with shutters, bars, or rails, and give particulars of such:—

Additional area where sheer is less than standard.

PARTICULARS OF PROTECTION TO OPENINGS, ETC.

HATCHWAYS ON FREEBOARD AND SUPERSTRUCTURE DECKS.									
Description of Hatchway	Cross Bunker Hatch				
Dimensions of Hatchway	4'-0" x 16'-2"				
COAMINGS	{ Height above Deck ... Thickness { Sides ... { Ends ... Stiffeners ... Brackets, Stays	36"				
	42				
	42				
		Stiffened by cross				
HATCH BEAMS	{ Number ... Spacing ... Scantling and Sketch	None				
						
FORE AND AFTERS	{ Number ... Spacing ... Unsupported Lengths ... Scantling* and Sketch	None				
						
HATCH COVERS	{ Material ... Thickness ... How fitted ... Bearing Surface	W.P.				
		2 3/4 - 3.				
		7 x 2				
		2 1/2"				
Spacing of Cleats	24				
Number of Tarpaulins	2 (incorporated in No 2 Hatch)				
*Are wood fore and afters steel shod at all bearing surfaces? <input checked="" type="checkbox"/> Are battens and wedges efficient and in good condition? <i>Yes.</i> Are tarpaulins in good condition and in accordance with rule requirements? <i>Yes</i> Are lashings provided in accordance with rule requirements? <i>Yes.</i>									

Particulars of any special features:—

Endorsement at first survey and at surveys for renewal of Certificate:—

The fittings and appliances are in accordance with the particulars shown on this form (or as now modified) and are in good condition.



© 2021

Lloyd's Register Foundation