


YARD No 345. MIDSHIP SECTION.

DIMS ÷ 140'-0" BP x 24'-6" MLD x 10'-1" MLD.
SCALE ÷ 1/2" = 1 FT.
TO CLASS LLOYDS 100 A.1.

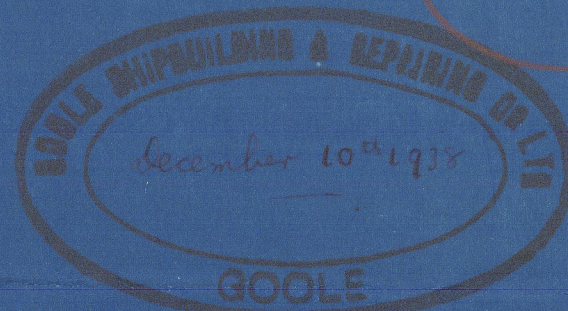


L x D = 140' x 10'-08" = 1.411
L x (B+D) = 140' x 34.58" = 4.841
L/D MAIN DK = 140/10'-08" = 13.88
L/D QUARTER DK 140/3.33" = 10.52
d. MAIN DK = 7.67
d. QUARTER DK = 10.92

EQUIPMENT No		
L x (B+D)	=	4.841 00
POOP	32'25" x 7' x .75	= 169.31
R.Q.D.	52'32" x 3.25	= 170.60
FOCLE	17'75" x 6'75" x .75	= 79.50
BRIDGE	11'25" x 7' x .75	= 55.12
CASING	17'5" x 7' x .5	= 61.25
	+ 8.85 + 3.25 + 5	= 5377.08

EQUIPMENT. *for a manual not specially 3400*
1 BOWER ANCHOR STOCKLESS 8 CWTs.
1 " " " 8 1/4 "
1 STREAM " STOCK 2 3/4 "
165 FATHS. 15/16" STUD LINK CABLE
45 " 2 1/4" CIRC. 9/12 CON. STREAM WIRE
75 " 2 1/2" CIRC. 9/12 CON. TOWLINE
90 " 5" CIRC. HEMP HAWSER.

GOOLE SHIPBUILDING & REPAIRING CO. LTD.
GOOLE.

DRAW. No 3575
PRINT No 12282

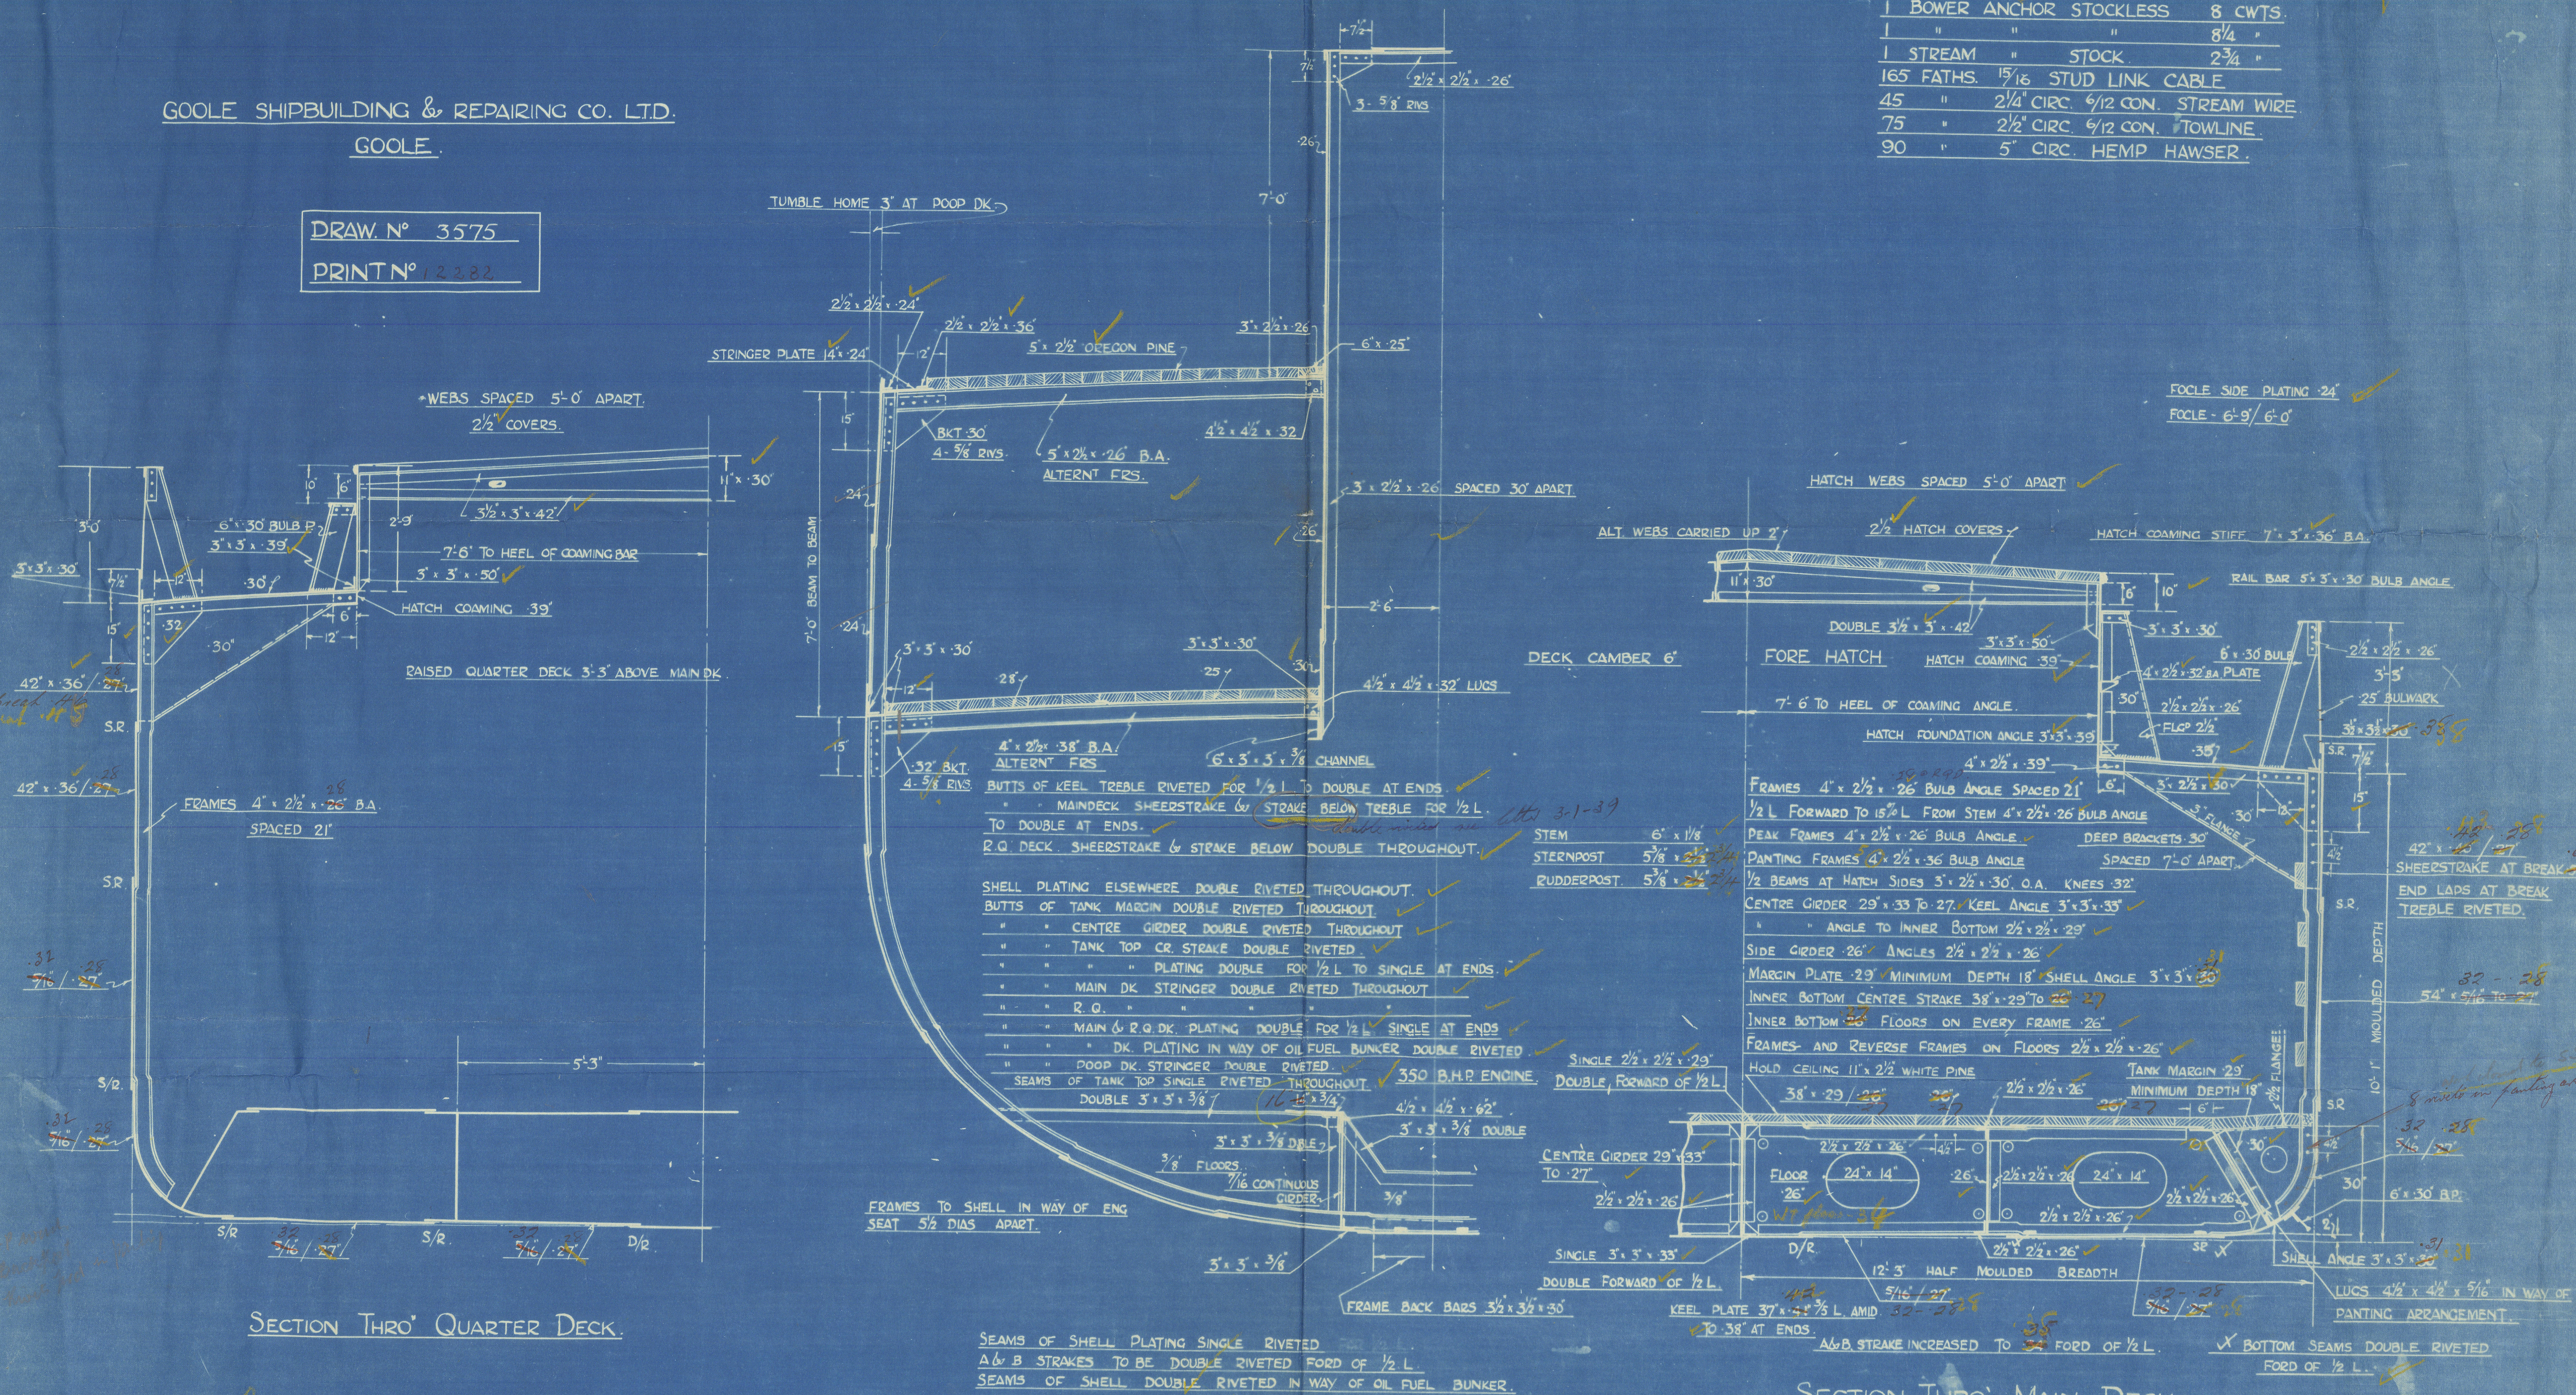

SECTION THRO' QUARTER DECK.

SECTION THRO' ENG. ROOM.

SECTION THRO' MAIN DECK.

Proceeding on ground

1911/12/13

Google's N-345

Medship Section

M.V. GLADONIA

~~GEN BOXING~~

~~358~~

9



© 2021

Lloyd's Register
Foundation

011251-011258-0170