



LOBNITZ & CO LTD  
ENGINEERS & SHIPBUILDERS

DIMENSIONS.		Ft.	Ins.
LENGTH	_____	90	0.
BREADTH MOULDED	_____	23	0.
DEPTH	D <sup>o</sup> _____	7	6.

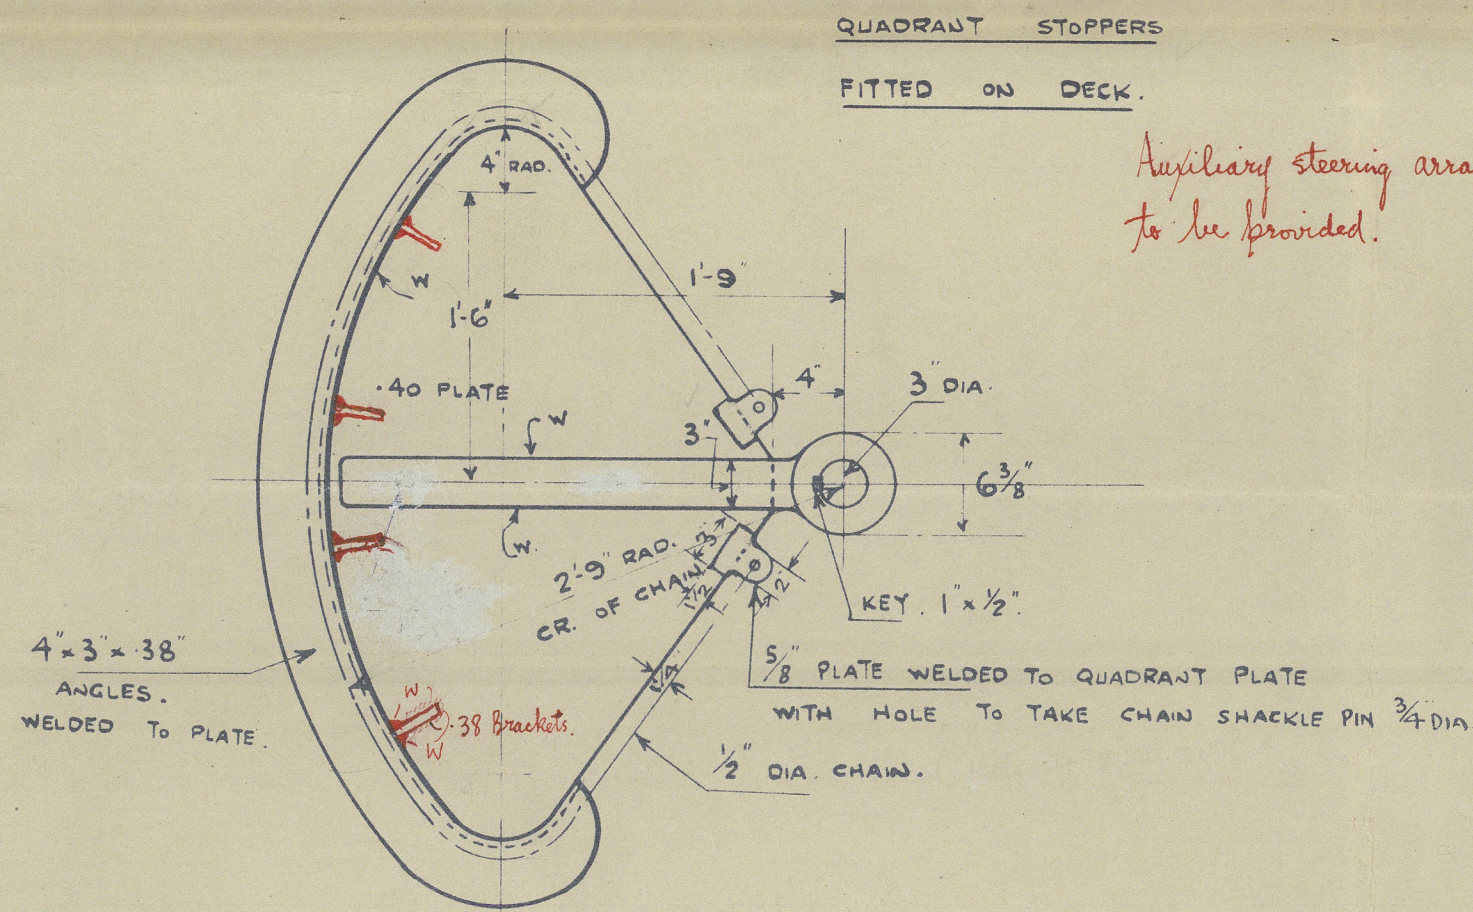

DETAIL OF QUADRANT

SCALE 1" = ONE FOOT.

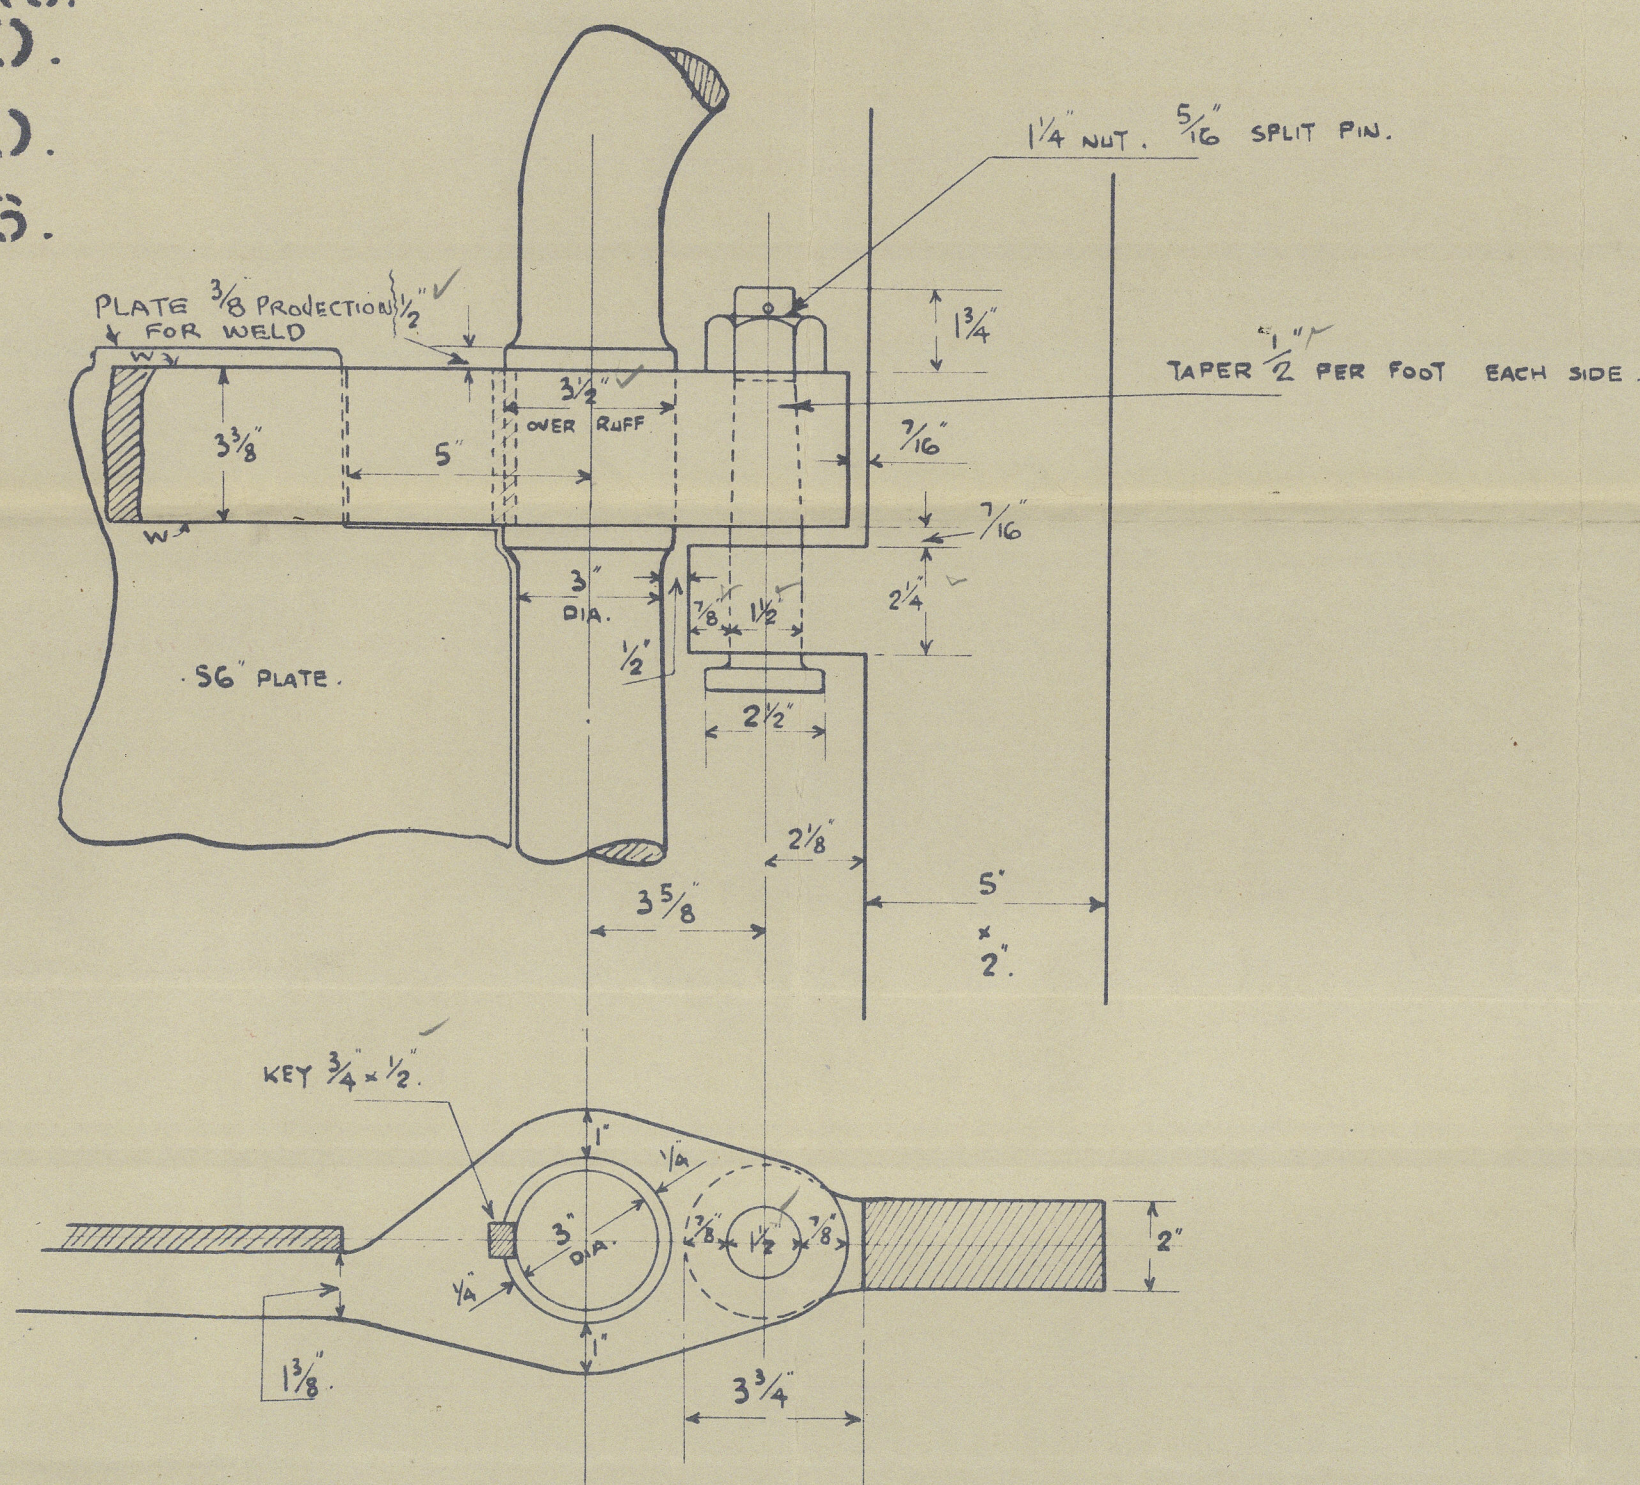

SCALE 3" = ONE FOOT.

MATERIAL - BEST FORGED STEEL


TO PASS BRITISH CORPORATION TEST

$A = 13.4 \text{ SQ. FT.} : R = 1.35 \text{ FT.} : V = 7 \text{ KNOT}$

RUDDER STOCK = 3 INS. DIA.


NOTE:- RUDDER STOCK TO BE MACHINED ONLY IN WAY OF  
RUDDER ARMS, DECK CASTING AND TILLER.  
TILLER TO BE MACHINED ONLY IN WAY OF RUDDER STOCK.  
STERNPOST TO BE MACHINED ONLY IN WAY OF PINITLES AND B&S

OTHERWISE FORGINGS ALL BLACK  
W - INDICATES WHERE WELDED

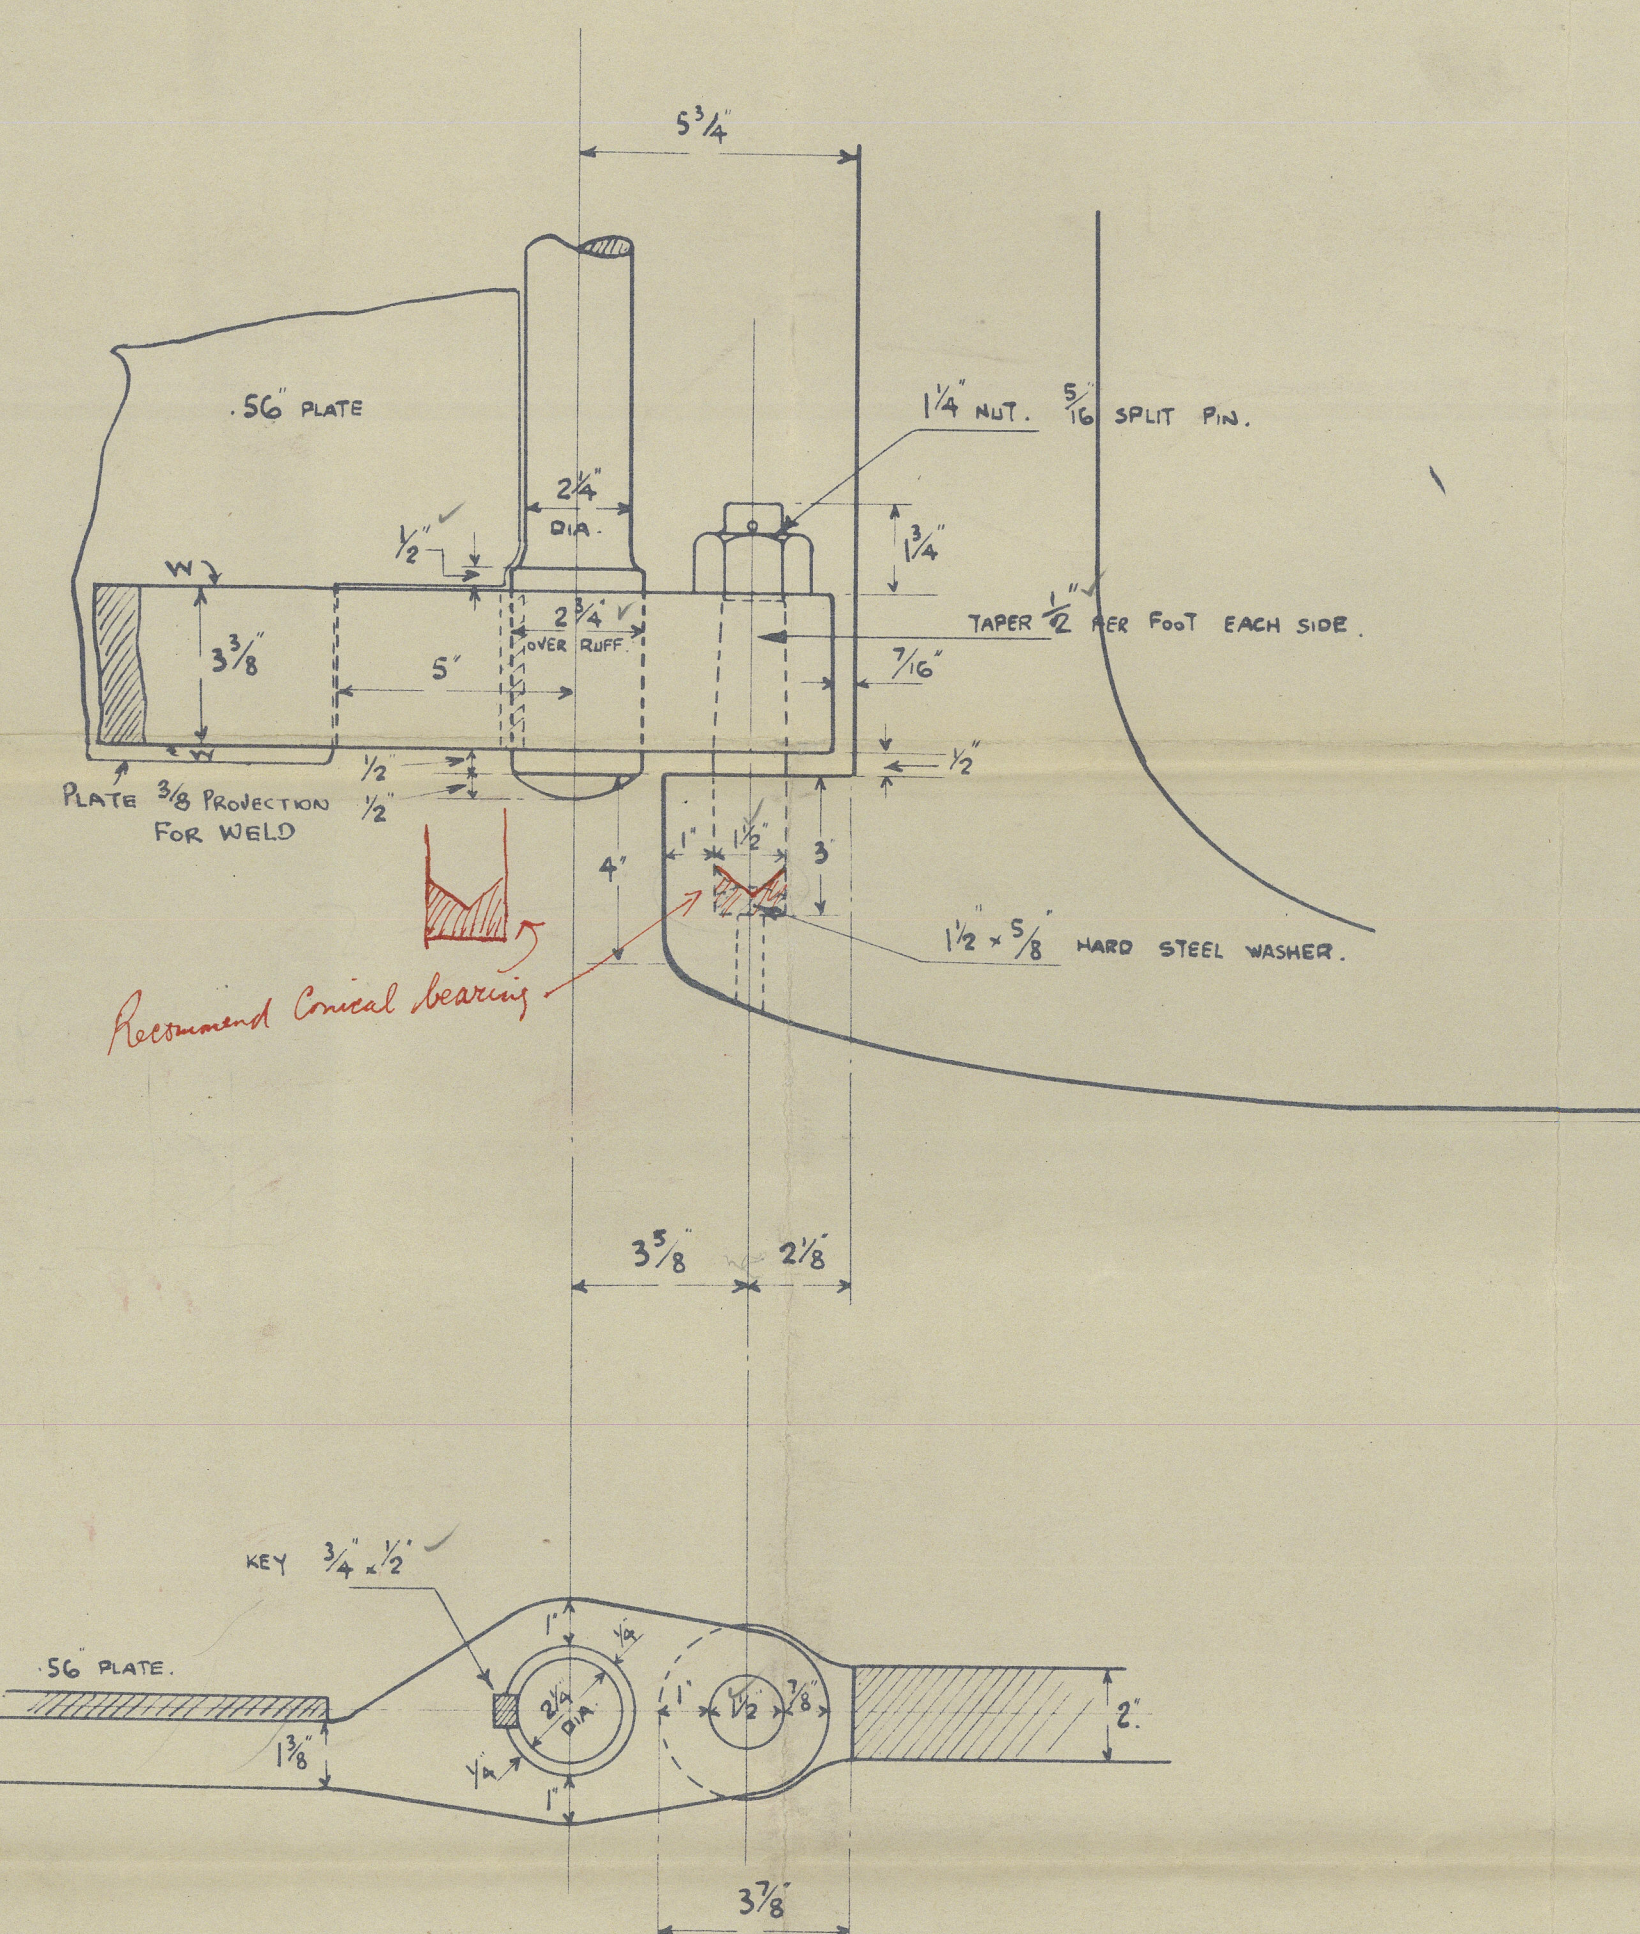

DETAIL OF BOTTOM PINTLE

SCALE 3" = ONE FOOT.

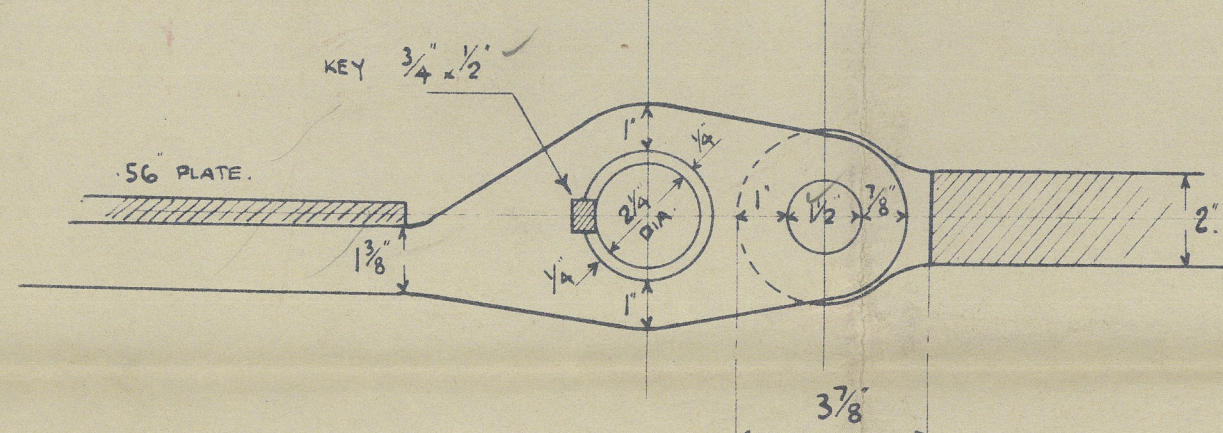

SCALE 1 <sup>INCH</sup> = ONE FOOT

# STERNPOST



# RUIDEIR

№ 955

LOBNITZ & CO LTD RENFREW  
No. 988.  
Drawn by A. Lums.  
Checked by J.M.R.  
DATE 11th Sept. 1935.

DWG No. S-4813

011273-011274-0005 Lloyd's Register Foundation



2

TRANSFERRED TO:  
L. R. SYSTEM

Budder Sternpost.

Sobnitz & Co.

No 988

2.10.26.

See Plan No 1211

2<sup>2</sup> MANNIN. TRANSFERRED TO:  
L. R. SYSTEM

Island.

Please return to H.O.

8-11-35

Sternpost & Budder

Sobnitz & Co. 988.



© 2021

Lloyd's Register  
Foundation

011273-011274-0057