






Esso laltens \*.

Richard Dunston Ltd Yard No 916.

Mull. F.E. Report No. 62532.

RECORDS DEPT.,  
LONDON.

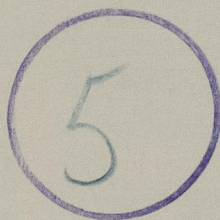

Mid Body Steelwork (As fitted)




© 2021

Lloyd's Register  
Foundation

011273-011274-0154



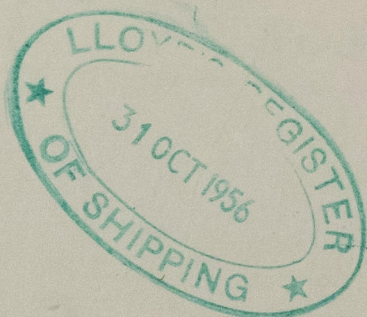

0159



© 2021

Lloyd's Register  
Foundation