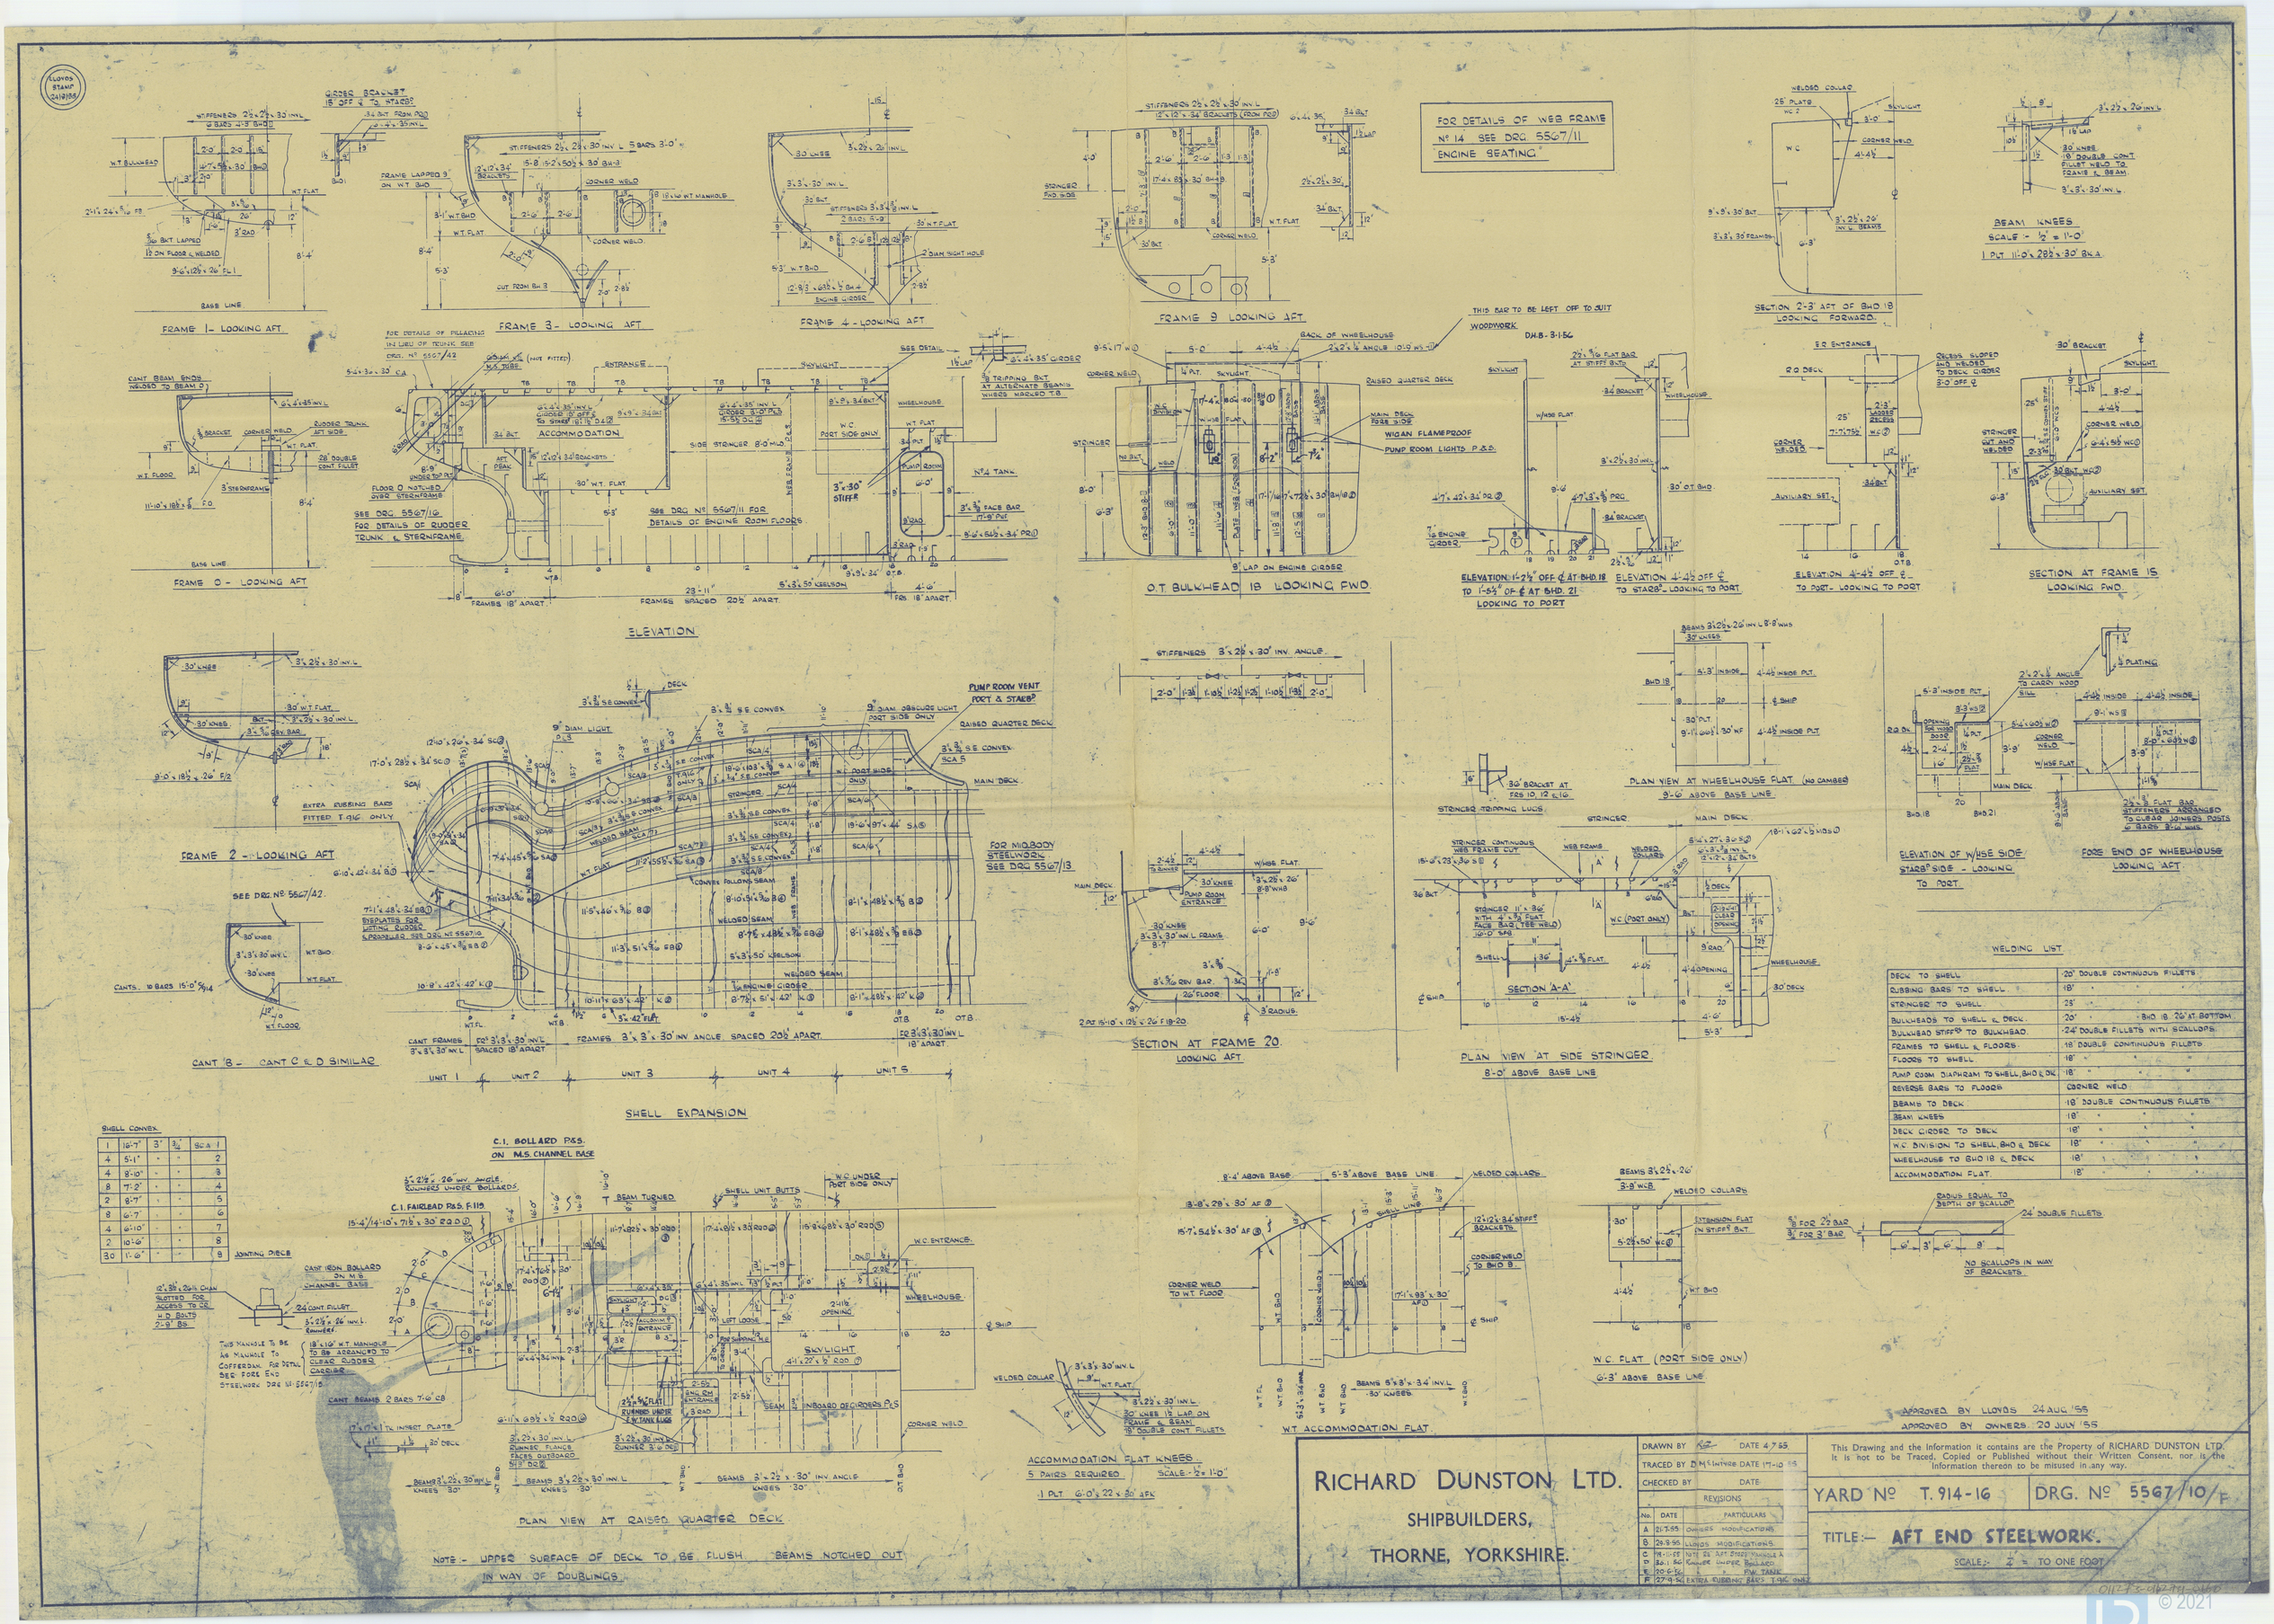

© 2021 Lloyd's Register Foundation

"ESSO SALTEND"

Richard Dunston Ltd.

Yard No. 916.

Hull T.E. Report No. 62532.

AFT. END STEELWORK (As fitted).

RECORDS DEPT.
LONDON.
2

© 2021
Lloyd's Register
Foundation

011273-011279-0160

LLOYD'S REGISTER
HULL
31 OCT 1956
OF SHIPPING

0160

© 2021
Lloyd's Register
Foundation