


Lloyd's Register of Shipping.

SURVEYS FOR FREEBOARD.

(CONDITIONS OF ASSIGNMENT.)

Ship's Name "POOLE RIVER" Port of Survey Sunderland.
 Official Number 183081 Surveyor's Signature Jas Rennie
 Nationality and Port of Registry British London. Date of Survey Whit building.

Disposition and dimensions of superstructures, trunks, deckhouses and machinery casings to be inserted in the diagrams and tabular statement: --

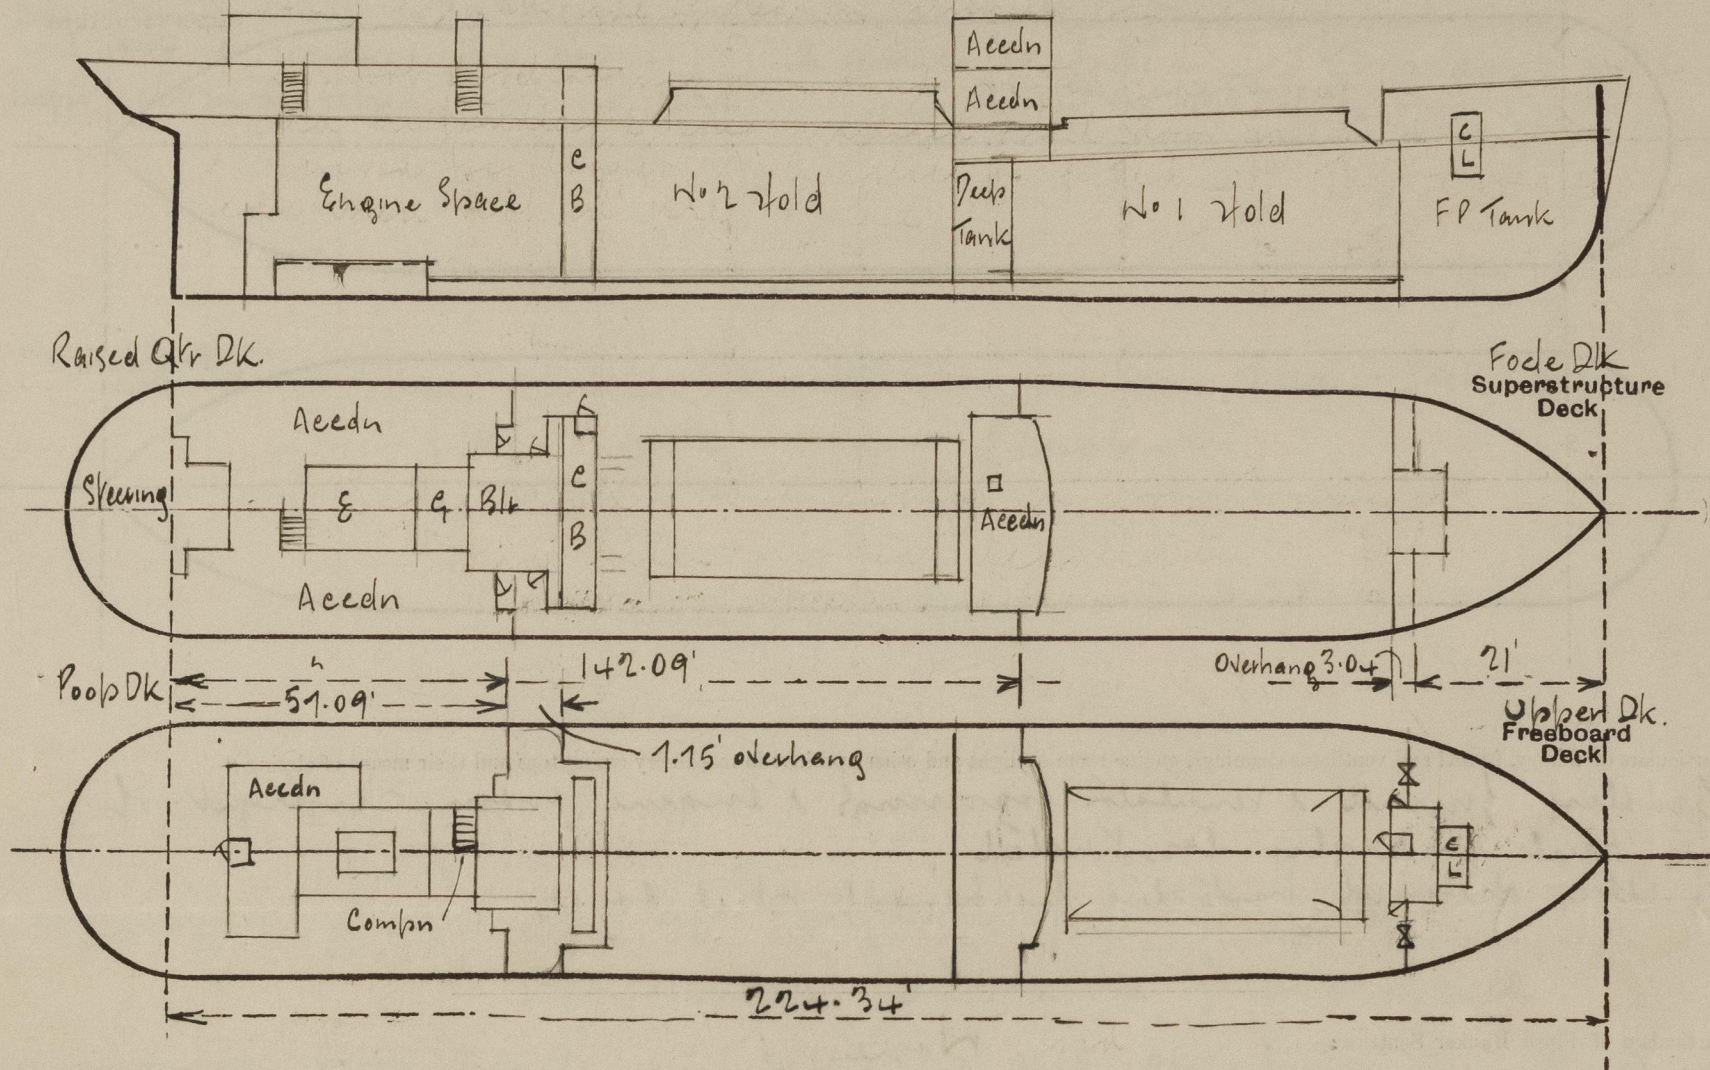

Particulars of Superstructures, Trunks, Casings, Deckhouses.


	Coaming	Plating	Stiffeners	Spacing	End Attachments of Stiffeners	Size of Openings	Height of Sills	Height of Casings
Poop Bulkhead <i>Sides Brackets Forward</i>	✓	-25 -32	2 1/2" + 1" round 1 + 3 1/2" + 3 1/2"	30" 33"	✓	2 @ 5' + 2'	18"	7'
Raised Quarter Deck Bulkhead ...	✓	-32	4 + 3 + 30 L	24 - 31 1/2"	✓	✓	✓	3' - 10"
Bridge, After Bulkhead ...	✓							
Bridge, Forward Bulkhead ...	✓							
Forecastle Bulkhead ...	✓	-25	3 + 3 + 30 L	21 - 30"	Dk bars.	2 - 4' - 6" + 3' - 1" 2 @ 4' - 6" + 2'	18"	7'
Trunk, Aft ...	✓					1 @ 4' - 0" + 20"	24"	
Trunk, Forward ...	✓							
Exposed Machinery Casings on Freeboard or Raised Quarter Deck ...	-30	-26	3 + 3 + 30 L	27"	✓	2 @ 4' - 9" + 2'	18"	7'
Exposed Machinery Casings on Superstructure Decks ...	✓							
Machinery Casings within Superstructures not fitted with Class I Closing Appliances ...	-30	-26	3 + 3 + 30 L	24" - 36"	Bkts Top Dk bars Btm	1 @ 4' - 2'	18"	7'
Deckhouses on Flush Deck Ships ...								

Particulars of Closing Appliances (state if capable of being manipulated from both sides).

Poop Bulkhead ...	Hinged steel doors 2" thick <i>seeming from either side.</i>
Raised Quarter Deck Bulkhead ...	✓ NO OPENINGS. ✓
Bridge, After Bulkhead ...	✓
Bridge, Forward Bulkhead ...	<i>striking Boards 2 1/2" thick in welded channels.</i>
Forecastle Bulkhead ...	2 Hinged steel doors <i>seeming from either side & hinged w. T. steel door seeming from either side.</i>
Exposed Machinery Casings on Freeboard or Raised Quarter Deck ...	Hinged steel doors <i>seeming from either side.</i>
Exposed Machinery Casings on Superstructure Decks ...	✓
Machinery Casings within Superstructures not fitted with Class I Closing Appliances ...	Hinged steel doors <i>seeming both sides.</i>
Deckhouses on Flush Deck Ships ...	✓

PARTICULARS OF PROTECTION TO OPENINGS, ETC.

The following diagrams should be used to indicate the positions of cargo and coaling hatchways, gangway, cargo and coaling ports, ventilators, companionways, etc., which would affect the seaworthiness of the ship:—

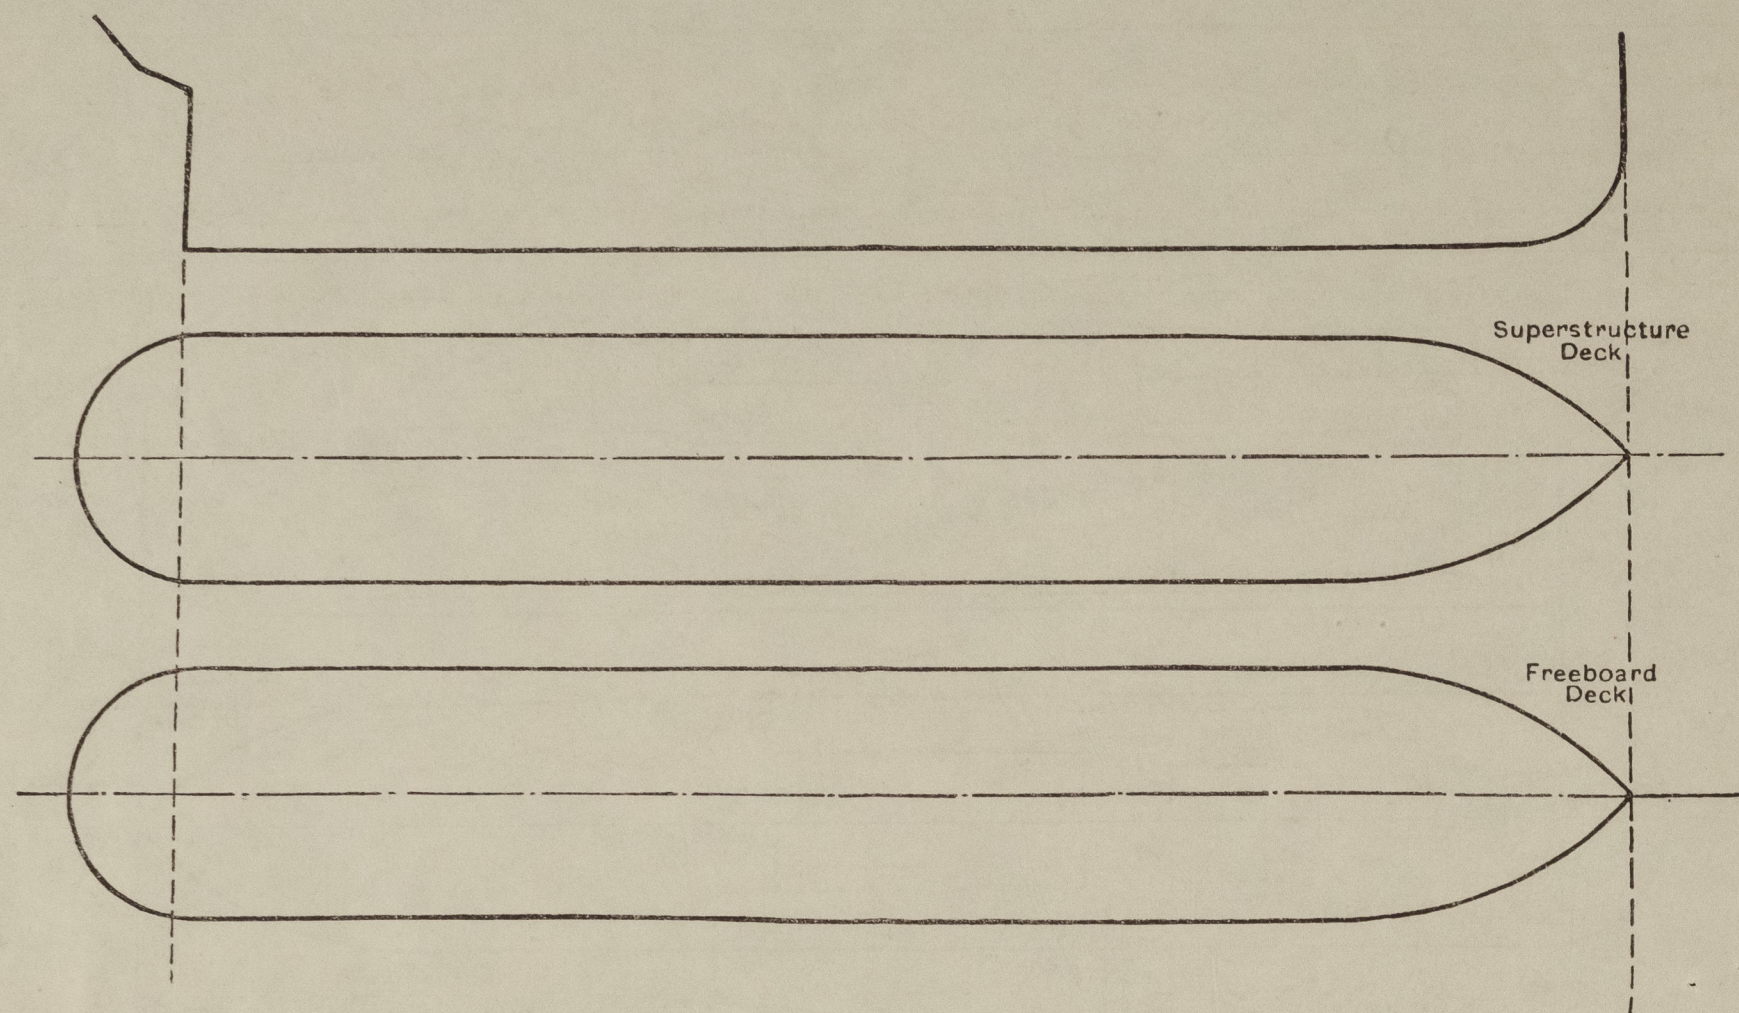

Particulars of fiddle, funnel and ventilator coamings, engine room skylight and other openings in machinery casing tops and their means of closing:—

Fiddle, funnel & ventilator coamings & engine room skylight of steel strongly constructed. Fiddle openings protected by hinged steel covers.

Particulars of Flush Bunker Scuttles:—

None.

Particulars of Companionways:— Green bunks to holds 1 in fore part, 1 in bunker casing side aft each secured by steel WT door operating both sides. Sills 24" high.

Steel companionway on Poop Deck leading to crew space. secured by hinged steel door operating from either side. 18" sill.

Particulars of Ventilators in exposed positions on freeboard and superstructure decks:—

Fore Dk. Tween Dk. 1'-6" dia 36" high 30 thick.
" " 2 G.W. vents 6" x 4" 18" high.
Upper Dk. No. 1 Hatch Top 2 vents 1-15" dia 1-12" dia 15" high 36 thick.
R. Qk Dk. No. 2 " 2 " 1-15" 1-12" 15" 36 "
" Stores 2 G.W. vents 6" x 4" 30" high.
Poop Dk. Tween Dk. 4'-6" dia 30" high 30 thick.
" " 2-6" " 30" 30 "
" Crew space 1 MV's 5' x 6" dia 30 "
" " 13 G.W. vents 6" x 4" 18" high.

Ventilation fitted with wooden plugs & canvas covers.

Particulars of Air Pipes in exposed positions on freeboard, raised quarter, or superstructure decks:—

Fore Dk. Fore Peak. 1-6" dia 1-3" dia 18" high to opening.
Upper Dk. No. 1 dbk 2-4" " 6'-3" high.
" Deep Tank. 2-6" " 6'-6" high.
R. Qk Dk. No. 2 dbk 2-5" " 30" high.
" No. 3 dbk 2-4" dia 2-2 1/2" dia 30" high.
Poop Dk. No. 4 & 5 dbk 4-2 1/2" dia 18" high.
" A. Pk Tank. 2-3" " 18" "

Air pipes fitted with wooden plugs and/or canvas covers.

Particulars of Gangway Cargo and Coaling Ports:—

None.

6 AUG 1949

Particulars of Scuppers and Sanitary Discharge Pipes:—

Scuppers & Sanitary discharges from spaces above the freeboard deck fitted with brass automatic non return storm valves at ship's sides. Slots 6" x 2" x 4" x 2" 6 off each side. fitted in gunwale bar for drainage of upper R. Qk Decks.

Note:— 15" ash shoot discharging overhead stowed side about R. Qk Deck level at inboard end in fiddle casing a hinged steel door is fitted, opening outward & secured by toggles (2) & notice is fitted: " This door is to be kept closed when not in use " Sill 18" ✓

Particulars of Side Scuttles:—

Side scuttles 10" x 12" dia in Poop Tween Deck each fitted with hinged deadlights.

Vertical distance of Sill of lowest Side Scuttle above top of keel

26' @ 55'-10 1/2" fwd of After Perp.

No side scuttles fitted above freeboard deck.

Particulars of Guard Rails:—

Guard rails on fore & poop decks 3'-6" x 3'-9" high with 2 rails, a stanchion spaced at 15' to 5' apart. Steel bulwarks 4'-0" x 3'-9" high fitted along Upper & lower Quarter Decks strongly constructed & efficiently stowed.

Particulars of Gangways, Lifelines, etc.:—

Provision made for rigging lifelines on each side of vessel along freeboard deck.

Particulars of Freeing Arrangements.

	Length of Bulwark	Height of Bulwark	Size of Freeing Ports	Number each side	Area each side	Rule area each side
After Well R. Qk Deck	61.15'	3.15'	4.25 + .30 51.15 + .30 1.50 + 1.0 Semi circular	1	14.00 #	17.55 #
Forward Well Upper Dk	61.25 58.21	4.00	41.00 + .30	1	13.5 #	12.32 #

State position of each freeing port ...

(F. and A. position and height above deck edge)

State whether the freeing ports are fitted with shutters, bars, or rails, and give particulars of such:—

Additional area where sheer is less than standard.


R. Qk Dk. After Well:— 5'-9" x 1'-3" respectively from fore end R. Qk Dk to fore end of opening. Forward Well:— 4'-0" x 13'-0" " R. Qk Dk from bulkhead to after end of opening. Height above deck edge. R. Qk Dk 8" Upper Dk 9 1/2" 2 slots only.

PARTICULARS OF PROTECTION TO OPENINGS, ETC.

		HATCHWAYS ON FREEBOARD AND SUPERSTRUCTURE DECKS.					
		Upper Dk		R. Qtr Dk.		Casing Top	
Description of Hatchway	...	No 1		No 2			Bunker Hatch
Dimensions of Hatchway	...	45' x 21'		47' x 22'			4'6" x 22'
COAMINGS	Height above Deck	48		48			L
	Thickness	44		44			3 x 3 x 30
	Stiffeners	12 x 3 1/2 x 44 Sides		12 x 3 1/2 x 44 Sides			
	Brackets, Stays	9 x 3 1/2 x 44 end		7 x 3 1/2 x 44 ends			
HATCH BEAMS	Number	5 sections of patent steel covers					
	Spacing	each section as per detail below					
	Scantling and Sketch						
	Bearing Surface						
FORE AND AFTERS	Number						
	Spacing						
	Unsupported Lengths						
	Scantling* and Sketch						
HATCH COVERS	Material	Macgregor Patent Steel Covers. (in accordance with approved plan)					WP 2 1/2
	Thickness	29		26			F & A
	How fitted	Althwart (see above sketch)					23/4
	Bearing Surface						24
Spacing of Cleats	...	35-39		35-39			2
Number of Tarpaulins	...	✓		✓			

*Are wood fore and afters steel shod at all bearing surfaces? ✓
 Are battens and wedges efficient and in good condition? ✓
 Are tarpaulins in good condition and in accordance with rule requirements? ✓
 Are lashings provided in accordance with rule requirements? ✓

Note:- Galvanized steel bands fitted to ends of hatch covers. ✓

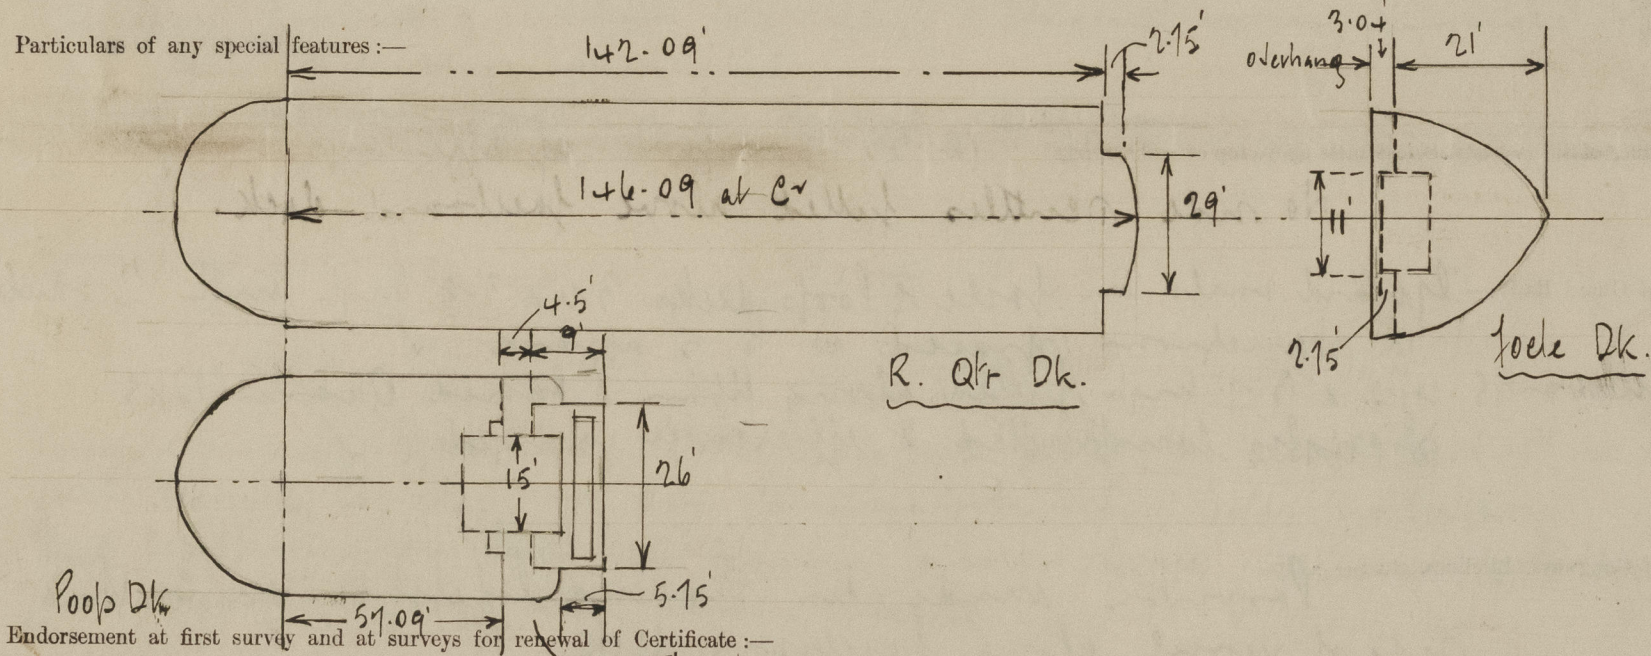

The fittings and appliances are in accordance with the particulars shown on this form (or as now modified) and are in good condition.