

CARDIFF

41853

Rpt. C. 11 (Contd.)

Index No.


Lloyd's Register of Shipping.

15 NOV 1952

Ship's Name "POOLE RIVER".

Official No. 183081

Memorandum of alterations reported since ship was surveyed for assignment of Load Lines in

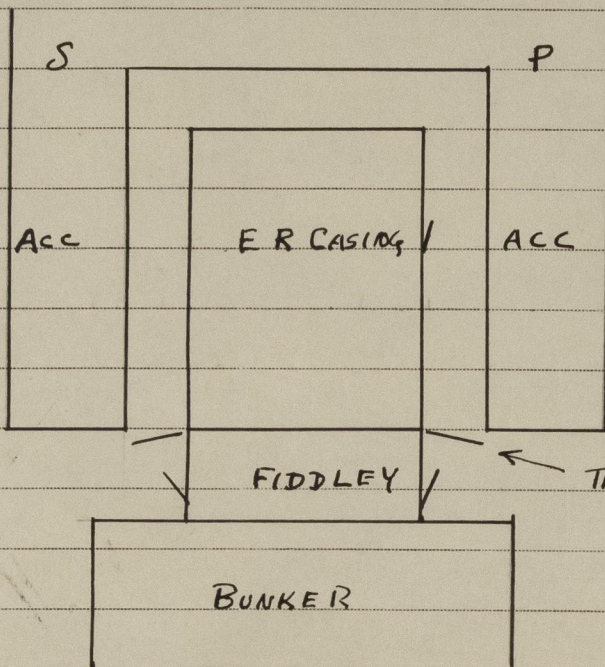

At Owners request these 2" wood doors on P & S alleyways now replaced by HINGED STEEL DOORS

J. Grieve

SURVEYOR TO LLOYD'S REGISTER OF SHIPPING

assumed on R.P.D.

noted.

96

18 NOV 1952

Raw.