

16 JAN 1950

Rpt. C. 11 (Contd.)

Index No.

Lloyd's Register of Shipping.

Ship's Name *ex* "ARROWHEAD"
"T. R. V. No. 8"


Official No. 183171

Memorandum of alterations reported since ship was surveyed for assignment of Load Lines in


Torpedo hatch covers removed and coamings heightened and ordinary cargo hatches as detailed hereunder now fitted.

PARTICULARS OF PROTECTION TO OPENINGS, ETC.

HATCHWAYS ON FREEBOARD AND SUPERSTRUCTURE DECKS.									
Description of Hatchway	...	Main							
Dimensions of Hatchway	...	23'4"x12'4"							
COAMINGS	Height above Deck	36"							
	Thickness	Sides	Orig.						
		Ends	Orig.						
	Stiffeners	...	Orig.						
Brackets, Stays	...	7							
HATCH BEAMS	Number	3							
	Spacing	5' 9 1/4"							
	Scantling and Sketch		.38" x 3"						
			.38 x 12" - 15"						
Bearing Surface	...	3 x 3 x .26							
FORE AND AFTERS	Number	N							
	Spacing	...	0						
	Unsupported Lengths	...	N						
	Scantling* and Sketch	...	E						
	Bearing Surface	...							
HATCH COVERS	Material	...	Red Pine						
	Thickness	...	3"						
	How fitted	...	F & A						
	Bearing Surface	...	3"						
Spacing of Cleats	...	24"							
Number of Tarpaulins	...	2							

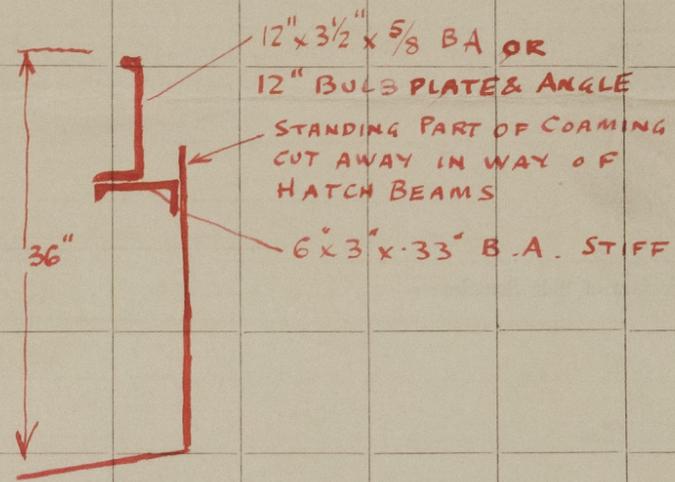

- *Are wood fore and afters steel shod at all bearing surfaces? Yes.
- Are battens and wedges efficient and in good condition? Yes.
- Are tarpaulins in good condition and in accordance with rule requirements? Yes.
- Are lashings provided in accordance with rule requirements? Yes.

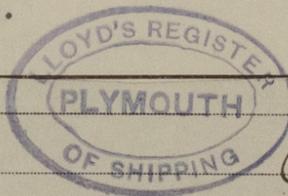

Robert J. Collins
9-1-50

J.B.
G.H.W.
199 JAN 1950