

7.4.19

— 14'-0" x 24'-0" x 14'-0" —

-CLASSED AT LLOYD'S ✕ 100.A.1.-

-SCALE 1/20-


LONG: L NUMBER L (B + D) = 140 x 38 = 5320.

$$f(A) = \frac{140}{14} = 10.$$


~~+ .04" FOR
OMMISSION
OF STRINGER~~

~~1.04" FOR
COMMISSION
OF STRINGER.~~

24-3-19

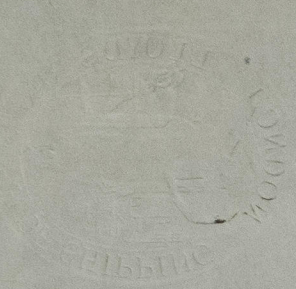

Bottom's

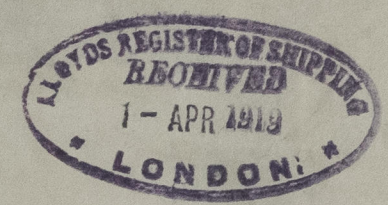

No. 289

Midship section

app plan
Reader Premiers



© 2021

Lloyd's Register
Foundation

011316-011329-0192