


7419



Independent means of steering to be provided to Surveyor's satisfaction which may be by block & tackle or by after wheel.

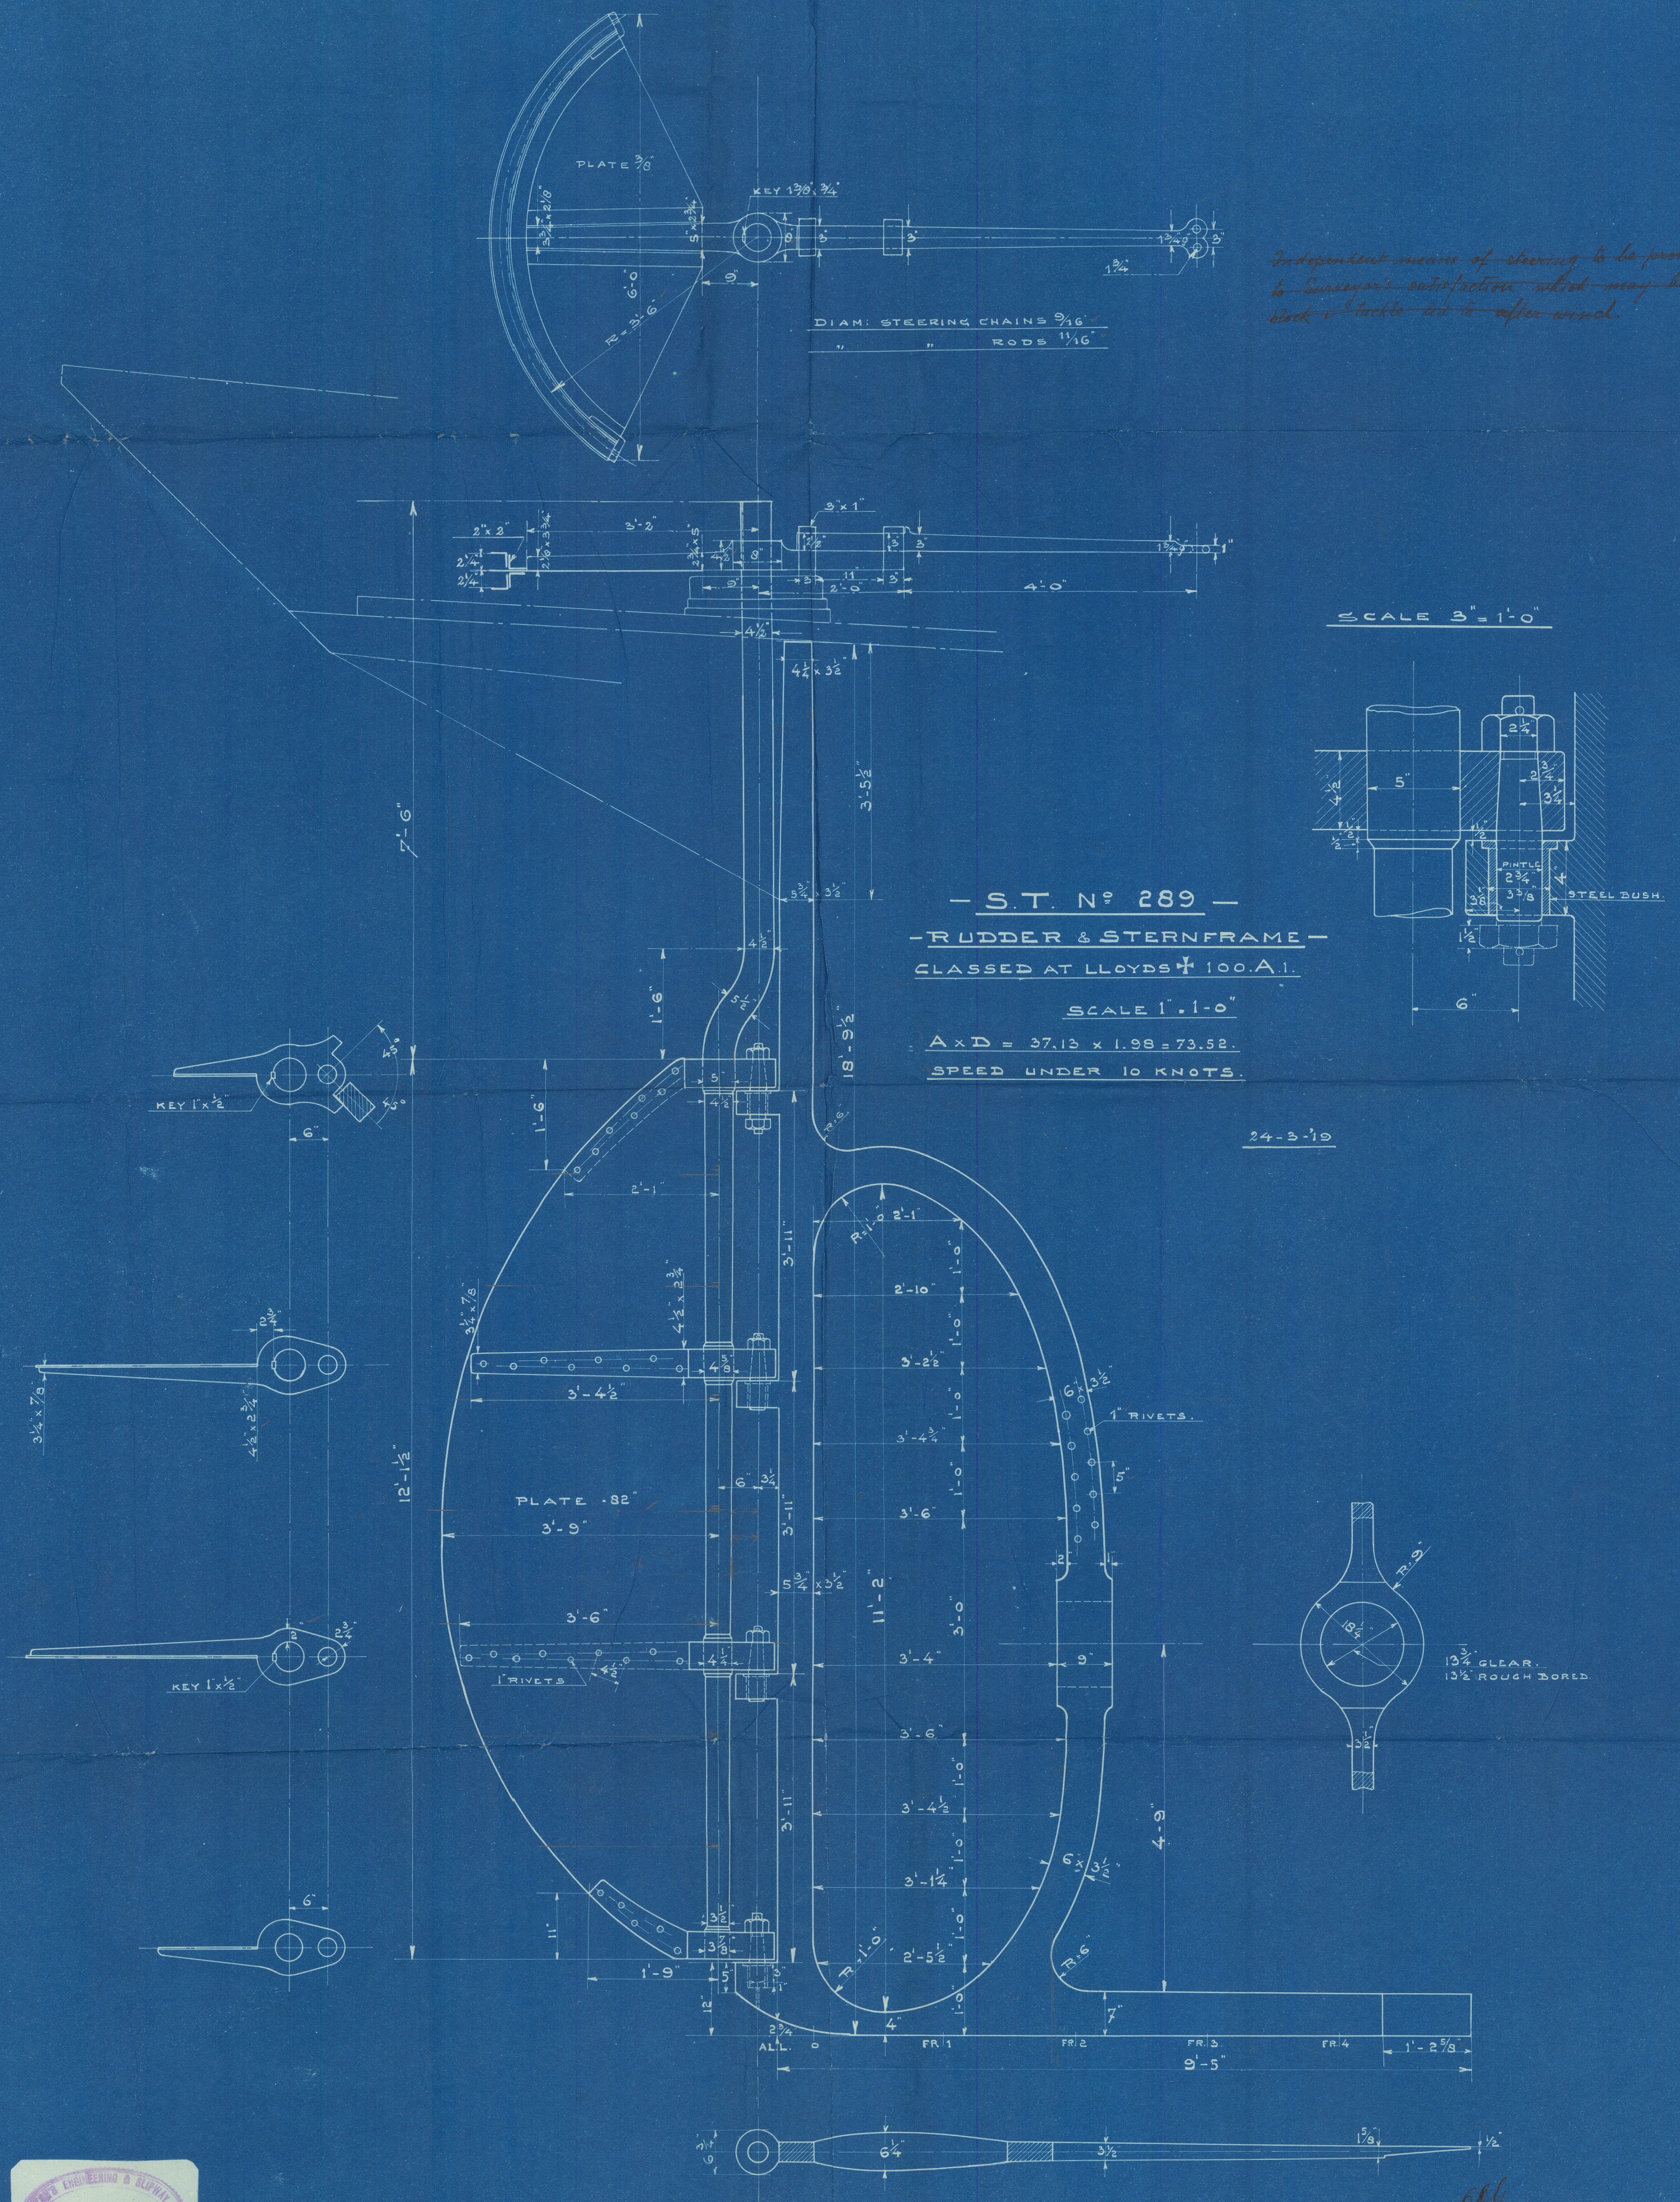

661
7.4.19

Willson's



No 289

Sternpenn. Rudder

Pescador Premeiro app. plan



© 2021

Lloyd's Register

Foundation