

**W. SIMONS & CO. LTD.**  
**LONDON WORKS.**  
**RENFREW.**

Nº 680.


DRAG & CUTTER SUCTION HOPPER DREDGER.

TO BE CLASSED A1 AT LLOYD'S STEEL DREDGER SPECIAL SURVEY.


PROFILE & DECK PLANS.

SCALE  $\frac{1}{8}$ " = ONE FOOT.

DIMENSIONS	
LENGTH ON DECK	285'-0"
" B.P.	272'-0" <i>Assumed measured as per No 2 plan</i>
BREADTH	52'-6"
DEPTH	19'-5"

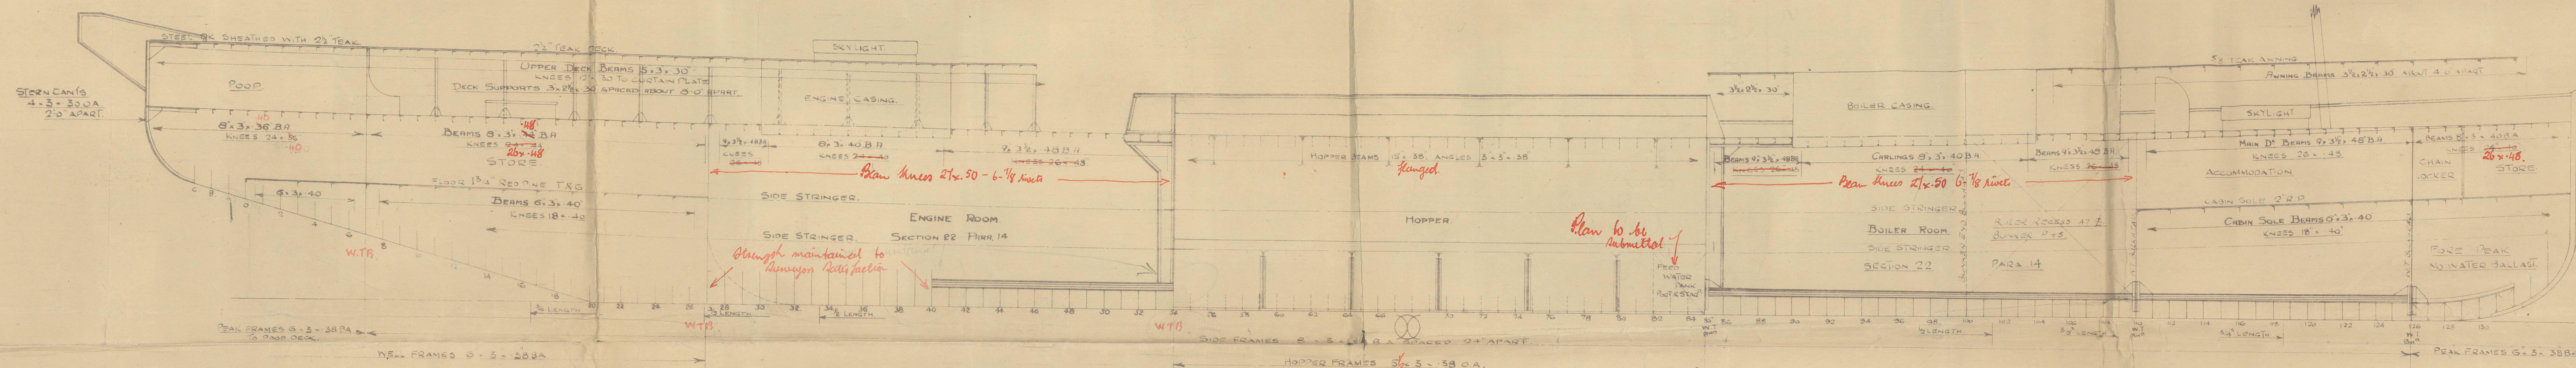

APPROVED  
 LLOYD'S REGISTER OF SHIPPING  
*Montgomery*  
 DATE 28.8.25

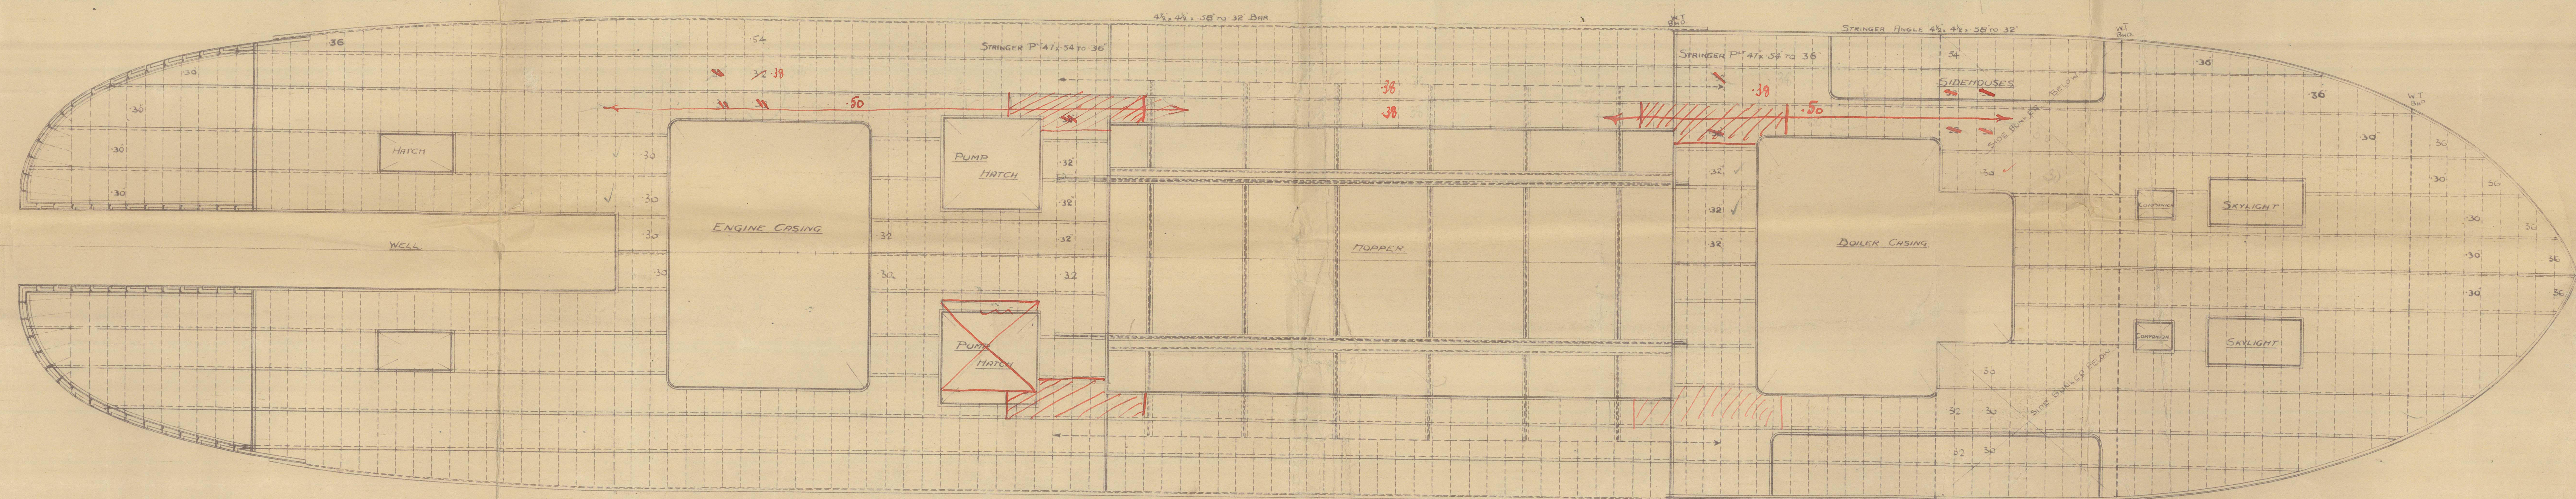

W. SIMONS & CO. LTD.  
 LONDON WORKS.  
 RENFREW.

W. SIMONS & CO. LTD.  
 LONDON WORKS.  
 RENFREW.



MESSRS. WILLIAM SIMONS & CO. LTD.

No. 680.

PROFILE & DECK.



© 2021

Lloyd's Register  
Foundation

011368-013720075



WM SIMONS & CO LD

PROFILE & DECK PLAN.

No 680.

"VIZAGAPATAM."

GLASGOW REPORT No. 46144

0075

copy



© 2021

Lloyd's Register  
Foundation