


^u★ *Virginia Maru*^u
As Built.
Yka F.E. Rpt N°16B
Certified Copy of
Approved Plan.

RECORDS DEPT.
LONDON.

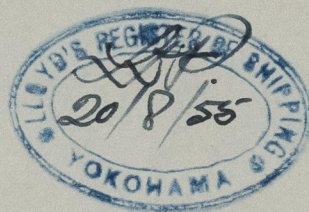

Stemframe & Rudder



© 2021

18367

Lloyd's Register
Foundation

011368-011377-01101