


圖面來歷
1946-4-23
昭和31年6月8日 一部改正

御影山丸

鋼材構造


1/2

尺度 1/100

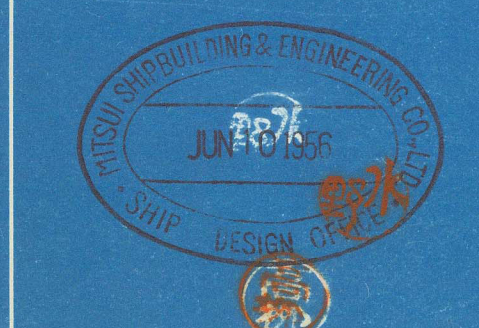


圖面番號 完 4 1/2

Lloyd's Register

 

FR. SPACE 230 x 90 x 11 B.A. IN PEAK TK. 300 x 90 x 10/16 S. 3 IN NO. 4 HOLD. 250 x 90 x 11/16 S. 3 WITH ONE HOR. GIR. 300 x 90 x 10/16 S. 3
FR. IN LOWER TWEEN DK. 180 x 95 B.P. BRACKETED TO MAIN DK. 230 x 11 B.P. SCARPHED TO HOLD FR. 300 x 50 x 12/17 230 x 11 B.P. EXTEND TO SHELTER DK. & SCARPHED TO HOLD FR. 230 x 11 B.P. SCARPHED TO LOWER TWEEN DK. FR.
FR. IN UPPER TWEEN DK. 180 x 95 B.P. BRACKETED TO MAIN DK. 230 x 11 B.P. SCARPHED TO LOWER TWEEN DK. FR. 230 x 11 B.P. SCARPHED TO LOWER TWEEN DK. FR. 180 x 94 B.P. BRACKETED TO SHELTER DK. FR. IN FORECASTLE DK.

 

RECORDS/DEPT.
LONDON

2

'MIKAGESAN MARU' ★

Construction Profile & decks plan.

KOBE RPT. NO. 3856

DATED.



© 2021

Lloyd's Register
Foundation

011378-011385-0095