

7.1.36 EQUIPMENT

1. STOCKLESS ANCHOR 10 1/4 CWTs
1. Do. Do. 9 3/4 CWTs
1. RODGER'S ANCHOR - 4 CWTs (EX STOCK)
150 FATHOMS 1 3/8" STUD LINK CABLE.
60 Do. 6" HAWSER.
60 Do. 5 1/2" WARP.

MIDSHIP SECTION

Nº 611 SHIP.

DIM:- 165'-0" B.P. x 27'-6" B.MLD. x 15'-0" DEPTH MLD.

SCALE 1/2" = 1 FOOT.


COOK WELTON & GEMMELL LTD.

SHIPBUILDERS.

BEVERLEY.

LLOYDS NUMERALS.

D.	15.00
B+D	42.50
L x D	2475.00
L x (B+D)	7012.50
"d"	13.50
L/D 11.00 : L/B 6.00	

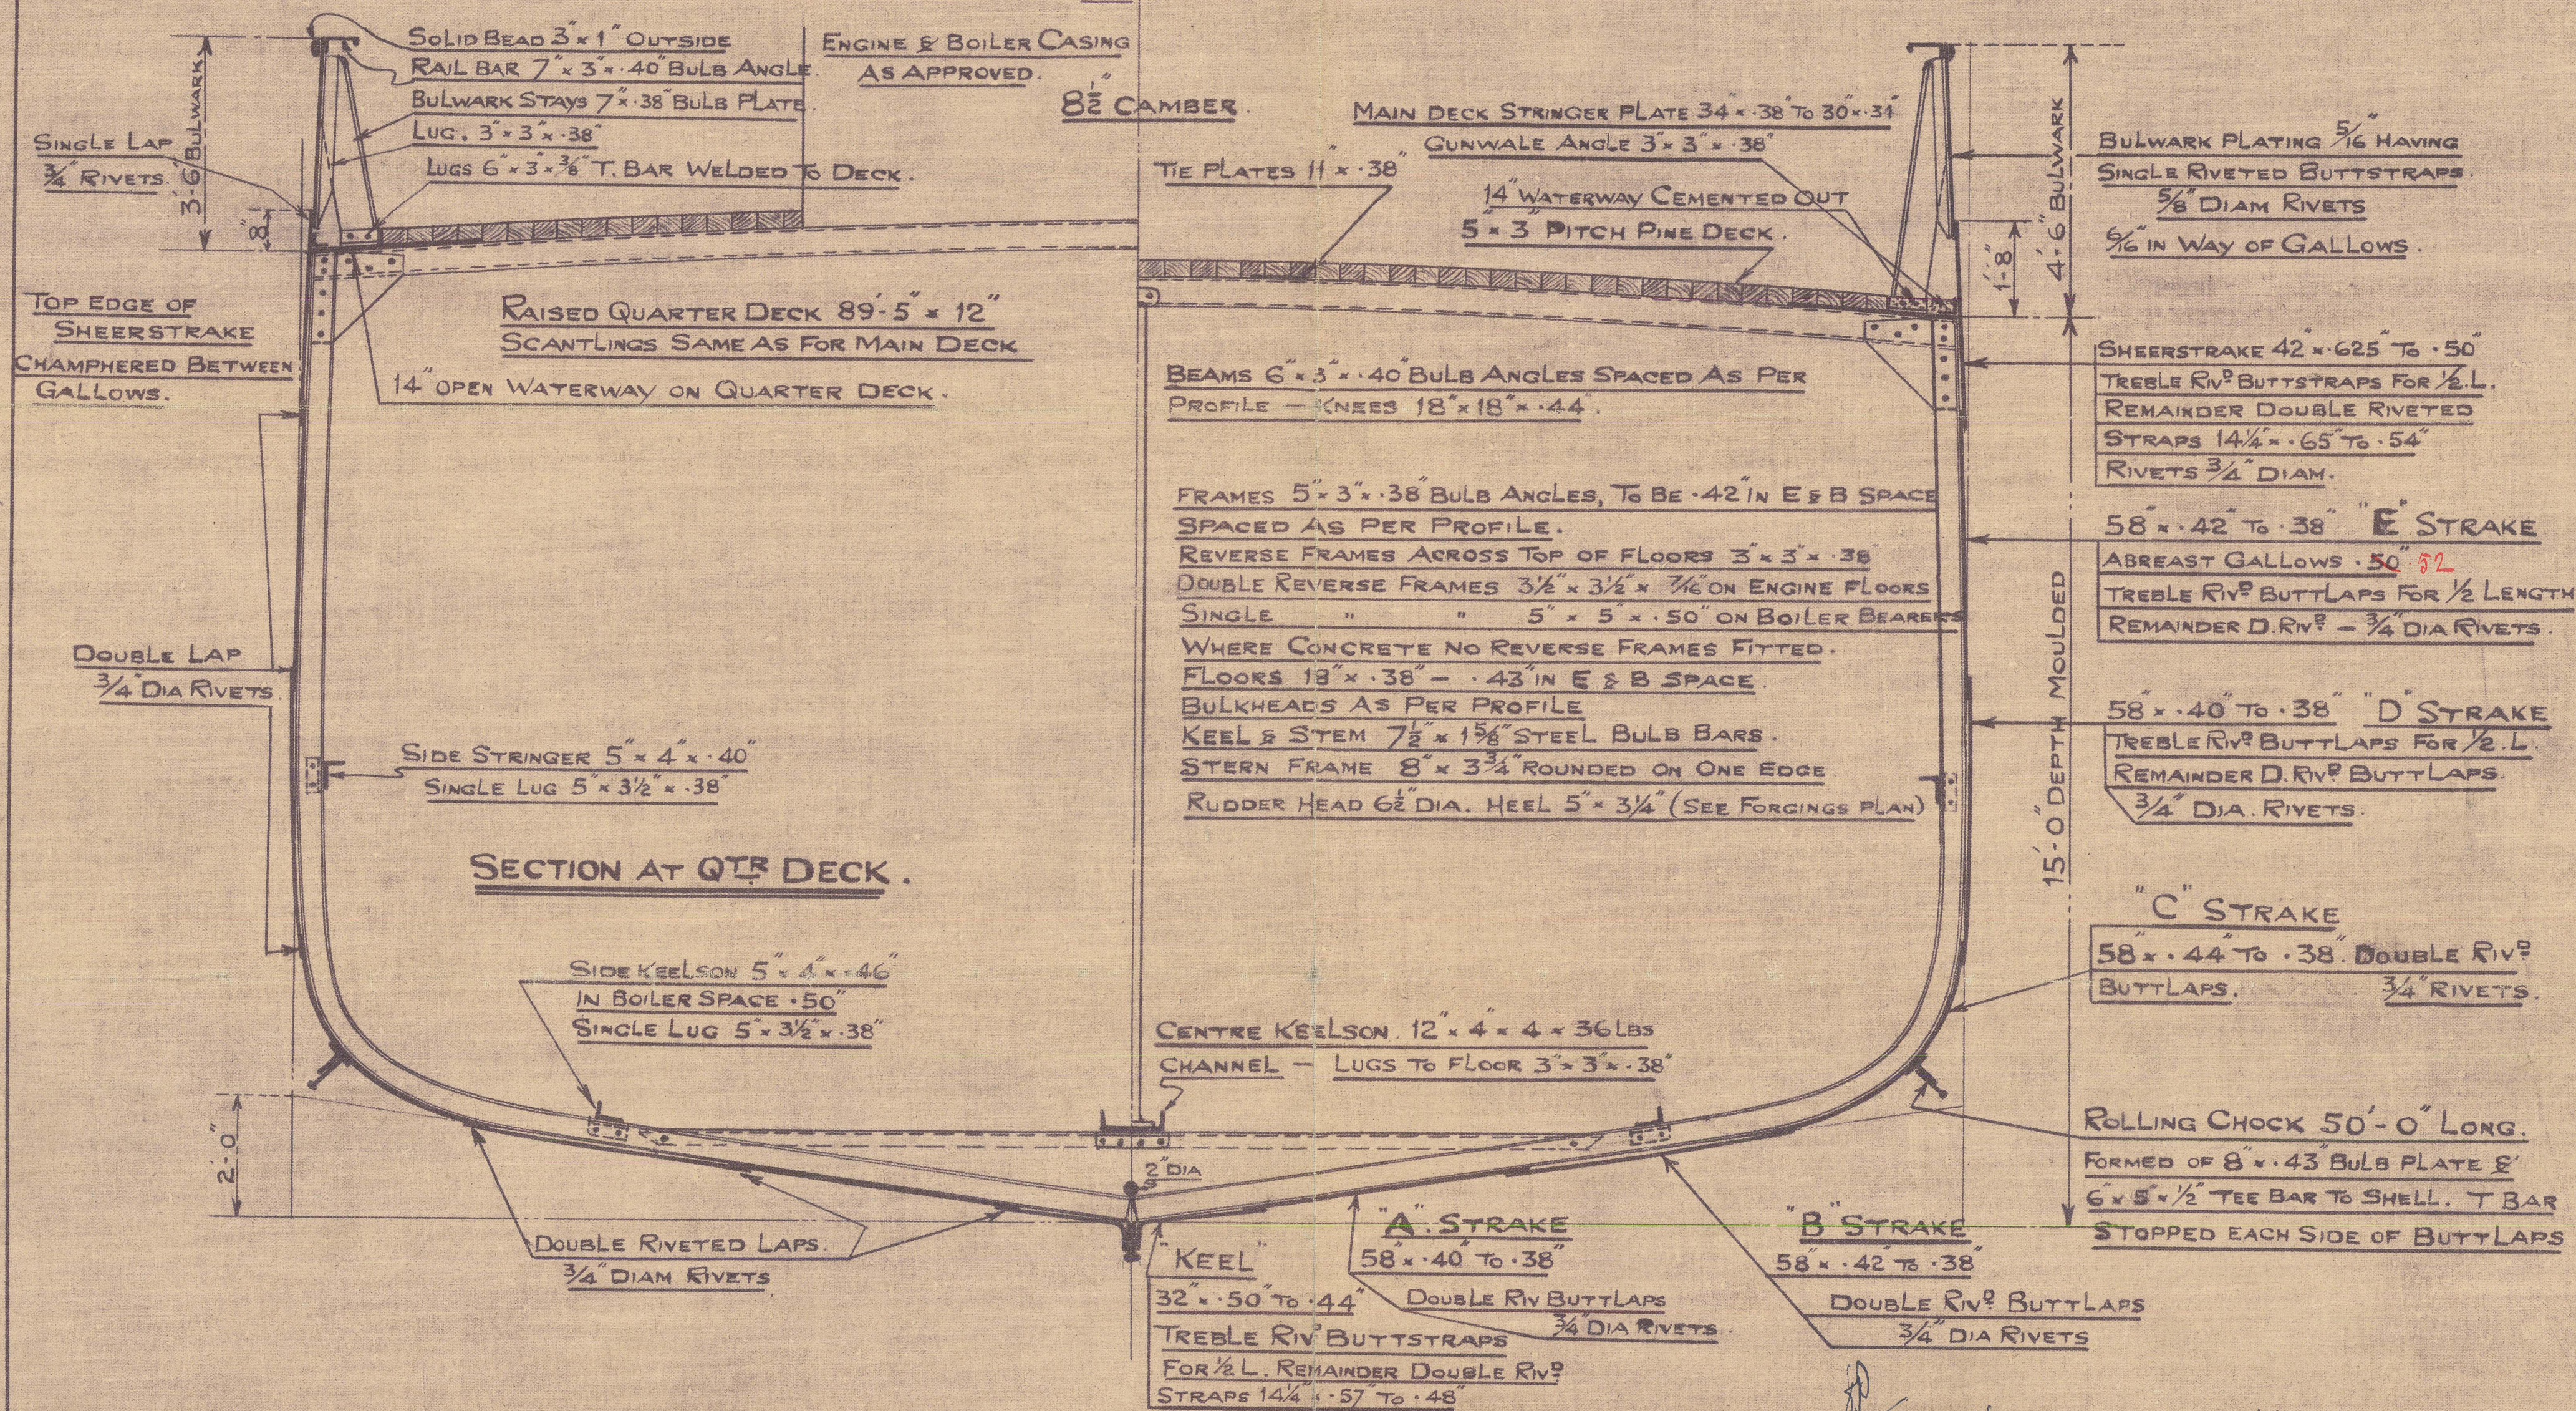

COOK WELTON & GEMMELL LTD

YARD No. 611

MIDSHIP SECTION

S.S.

Cape Conover

HULL REPORT NO.

46829.



© 2021

Lloyd's Register
Foundation

011397-011407-0241