


Section thro' E. R.

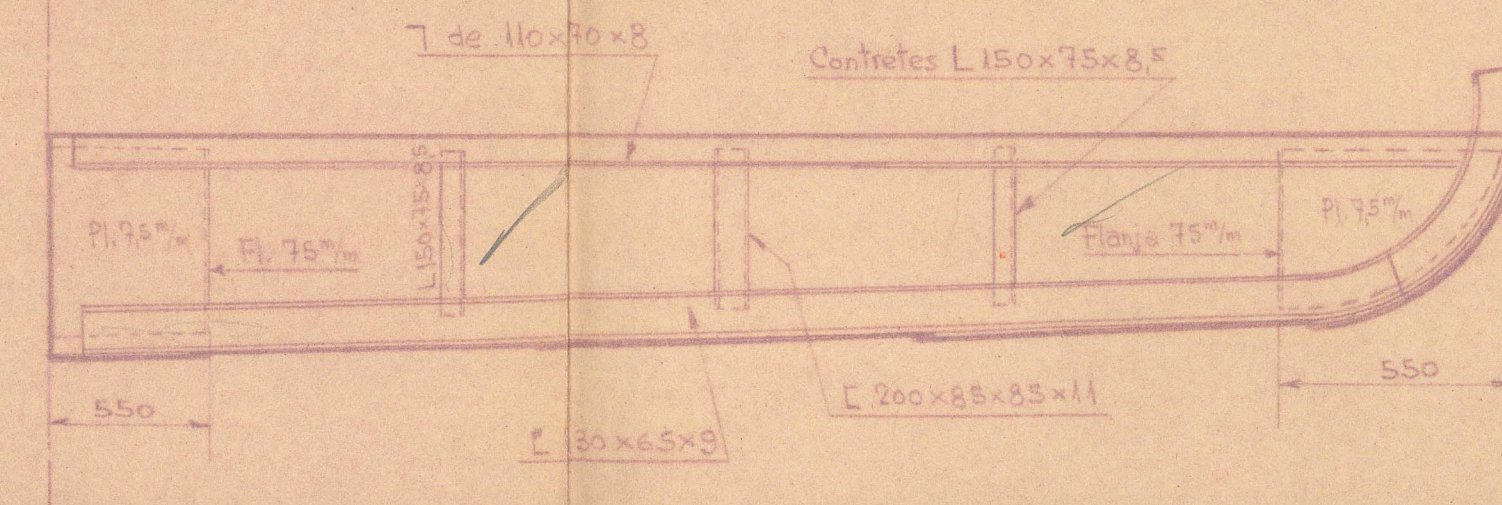

length between prop.	Esfera entre pp.	60,7 cms.
breadth	Manga	3,75 "
depth	Punta	5,65 "
existing draught	Calado actual	3,339 mts.
draught after alterations.	Calado despues de transformado.	4,115 mts.


MIDSHIP SECTION. ALTERATION FROM  
OPEN TO CLOSED SHELTER DECK.



SS/MS " SAN FLORO "	
TO ACCOMPANY	BBO Rpt. No 12458
Dated 26/11/58	
SUBJECT:- Midship Section <del>SSD - CSD</del>	

2 die

RECORDS DEPT..  
LONDON.

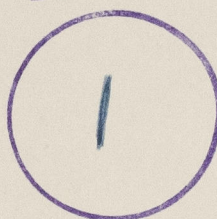

© 2021

Lloyd's Register  
Foundation

011421-011426-0046