



YARD N° 609 STERNPOST AND RUDDER. SCALE $\frac{3}{4}" \& 3" = 1 \text{ FOOT}$.

DETAILS OF COUPLING SCALE $3" = 1 \text{ FOOT}$

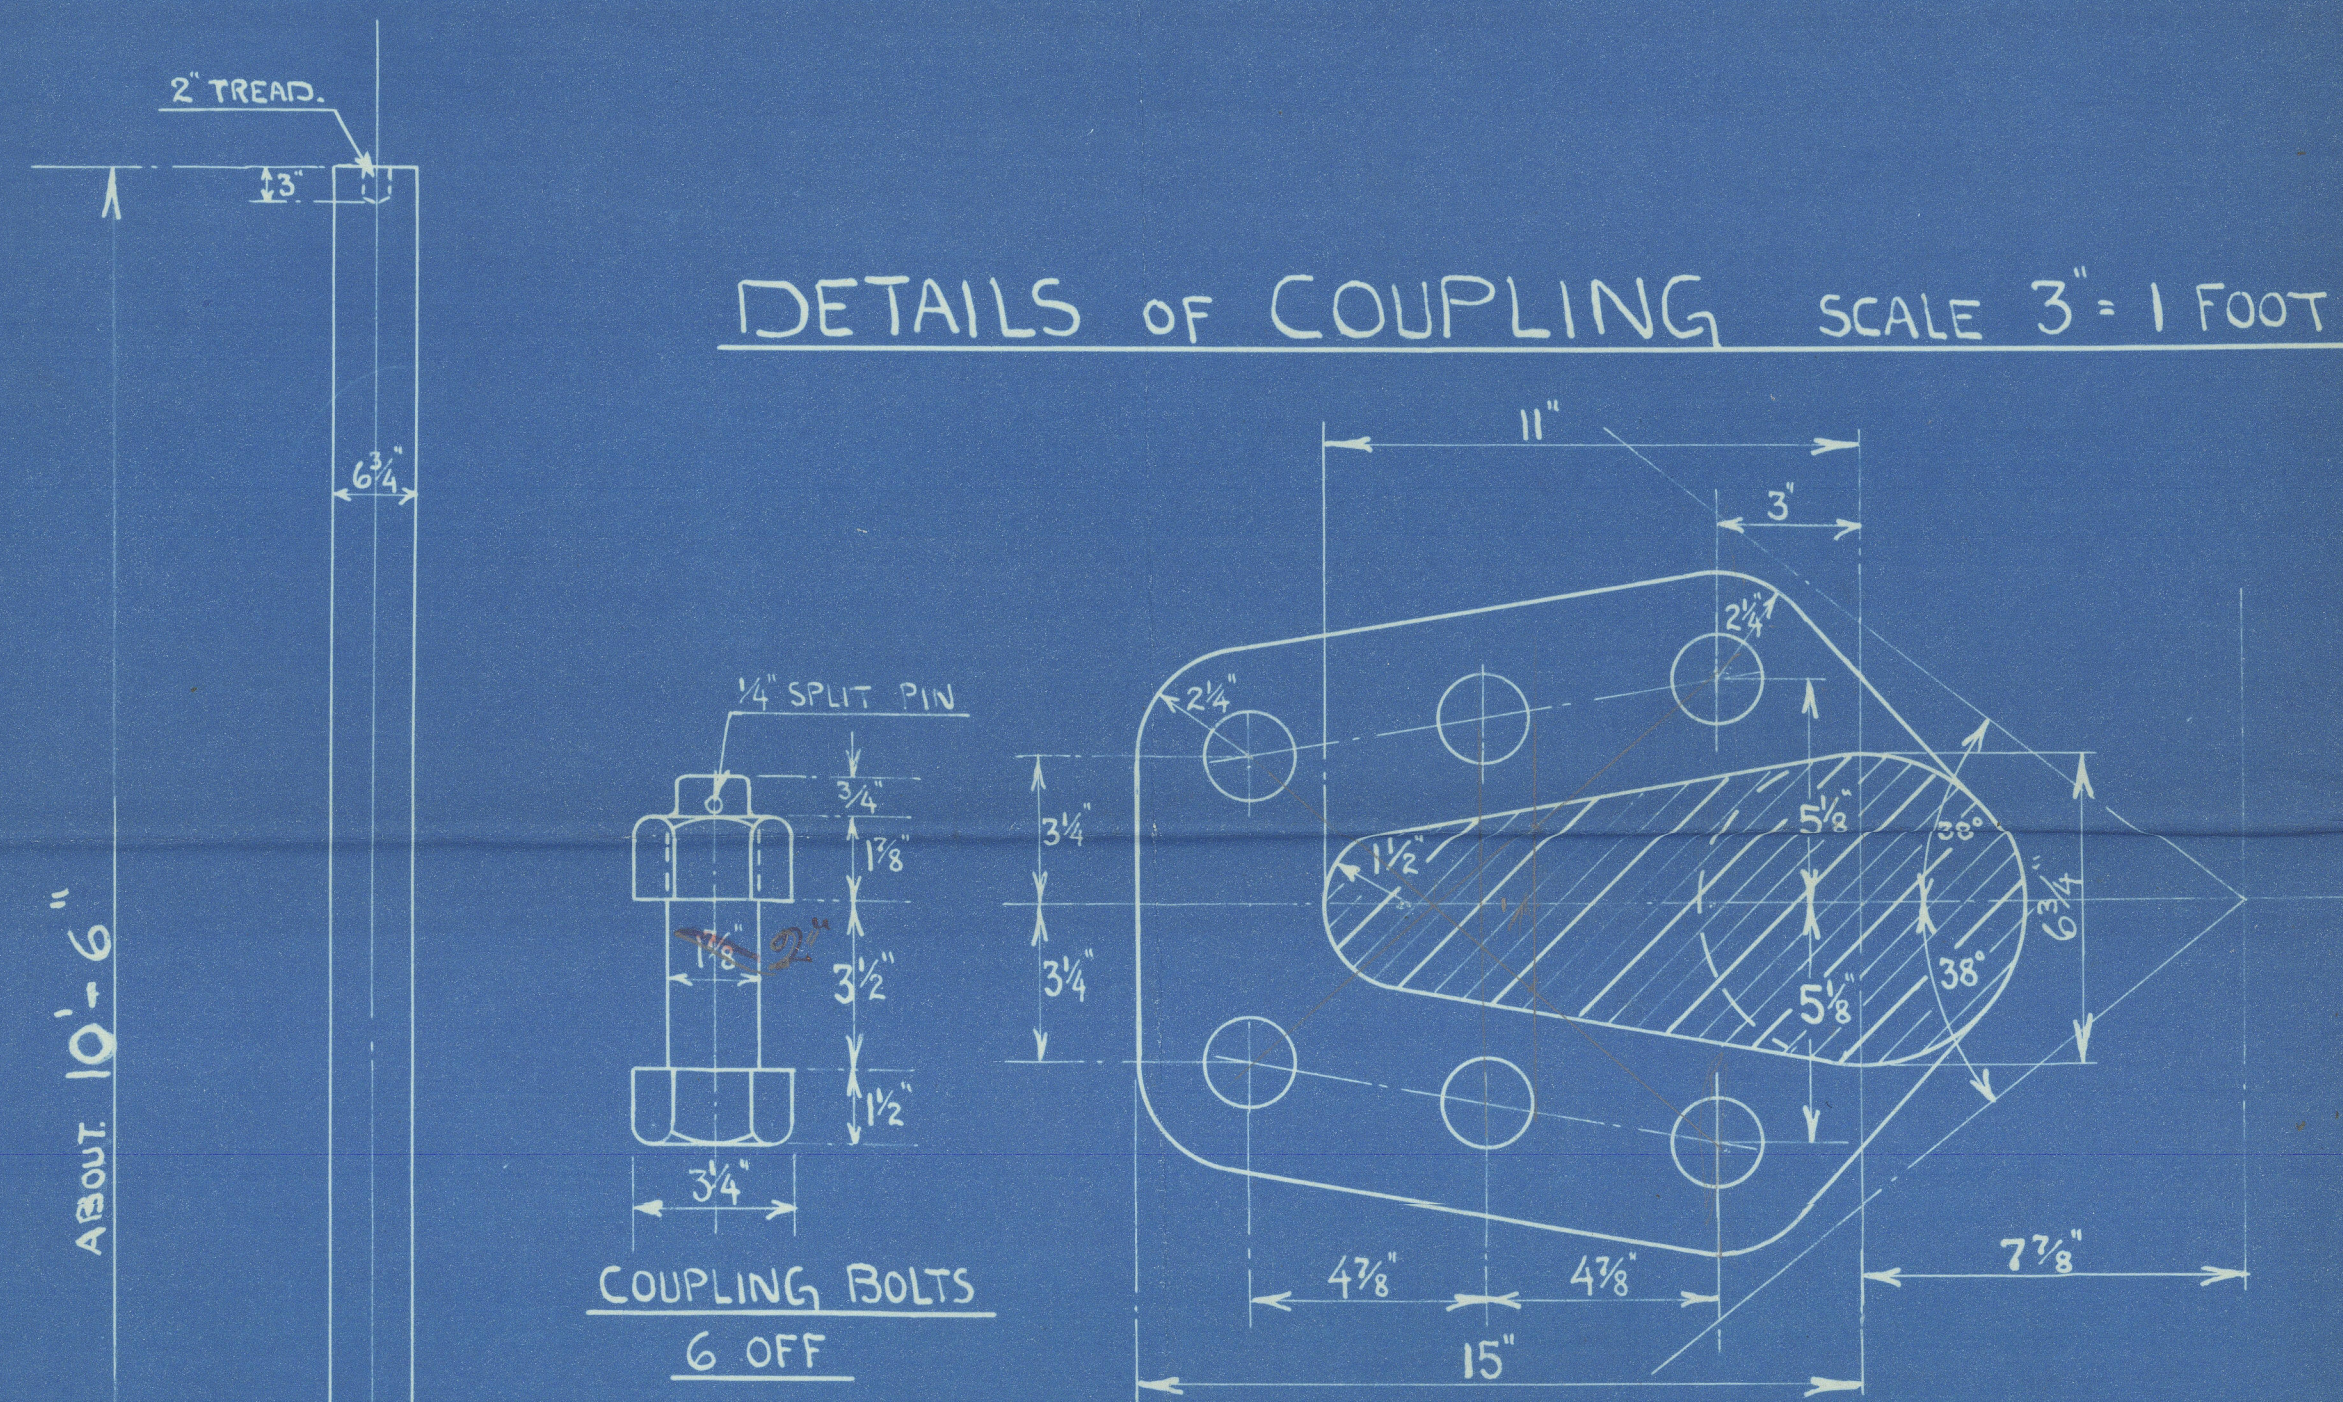

STERNPOST - RUDDERHEAD - MAINPIECE AND ARMS OF FORGED STEEL.

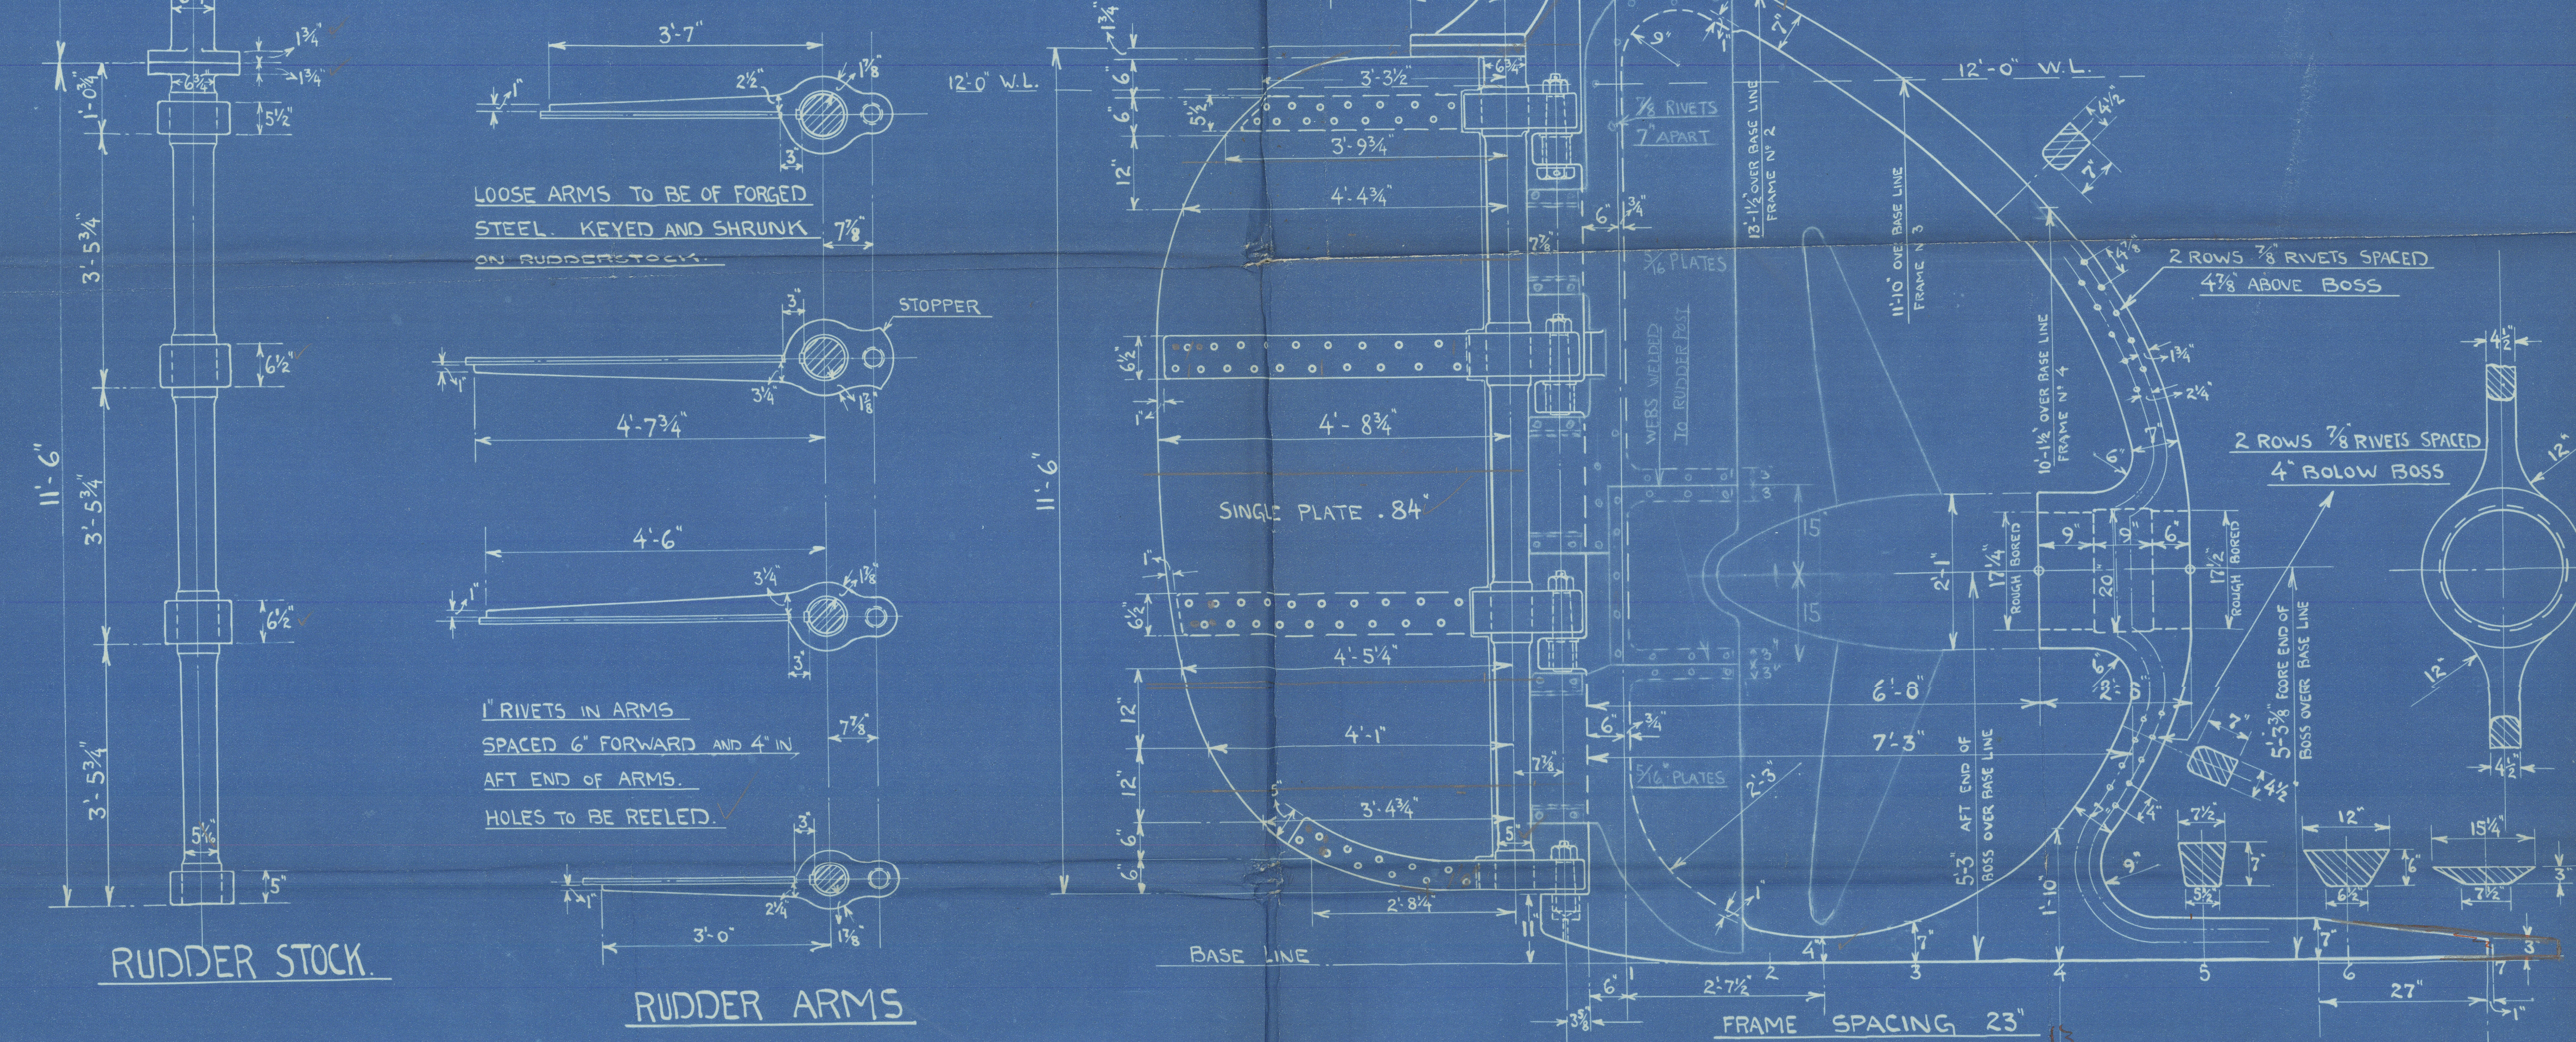





AREA OF RUDDER = 54.89 m^2 FROM ϵ OF PINTLES TO BACK EDGE OF PLATE.

CENTRE OF GRAVITY = 2.464 m ABAFT ϵ OF PINTLES

TRIAL SPEED OF VESSEL 12 KNOTS

DIAM OF RUDDER STOCK = $.26 \sqrt[3]{2.464 \cdot 54.89 \cdot 11.4^2} = 6.75$

DETAILS OF PINTLES SCALE $3" = 1 \text{ FOOT}$

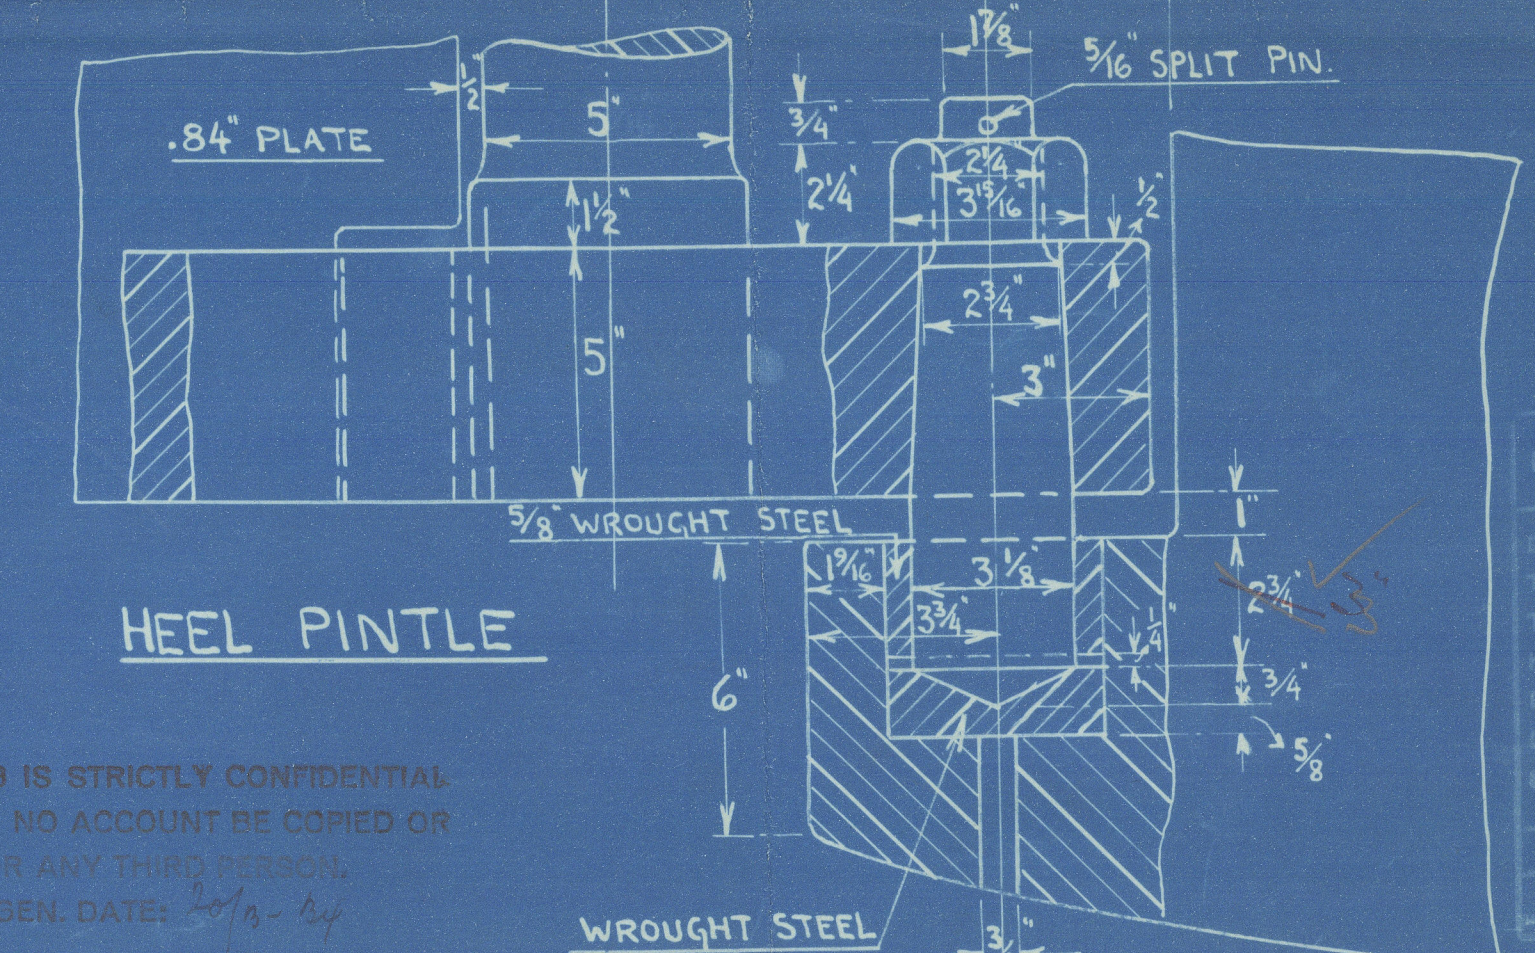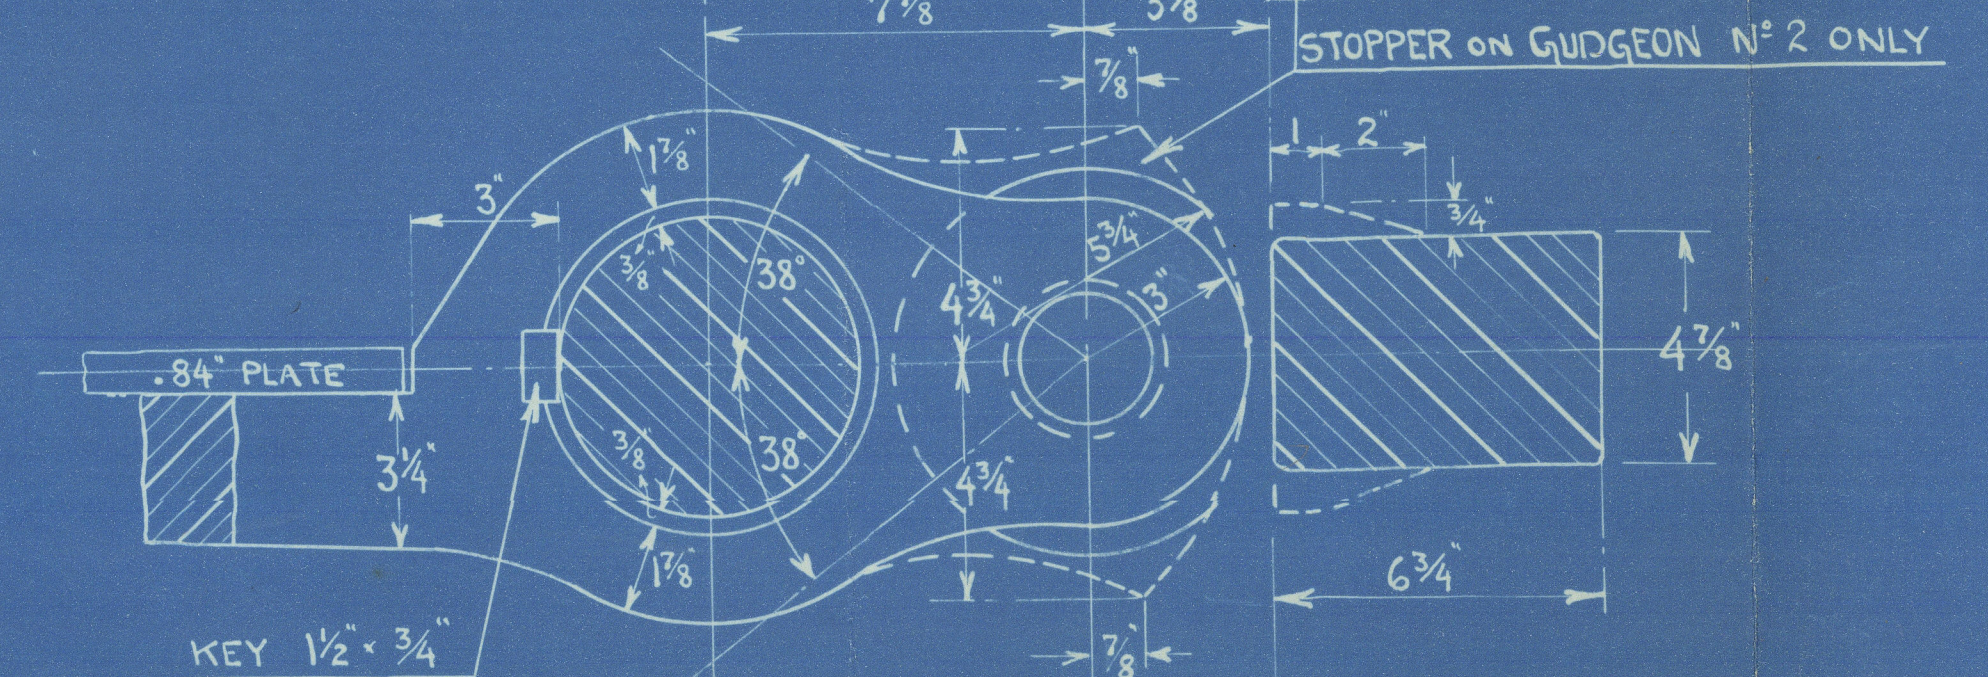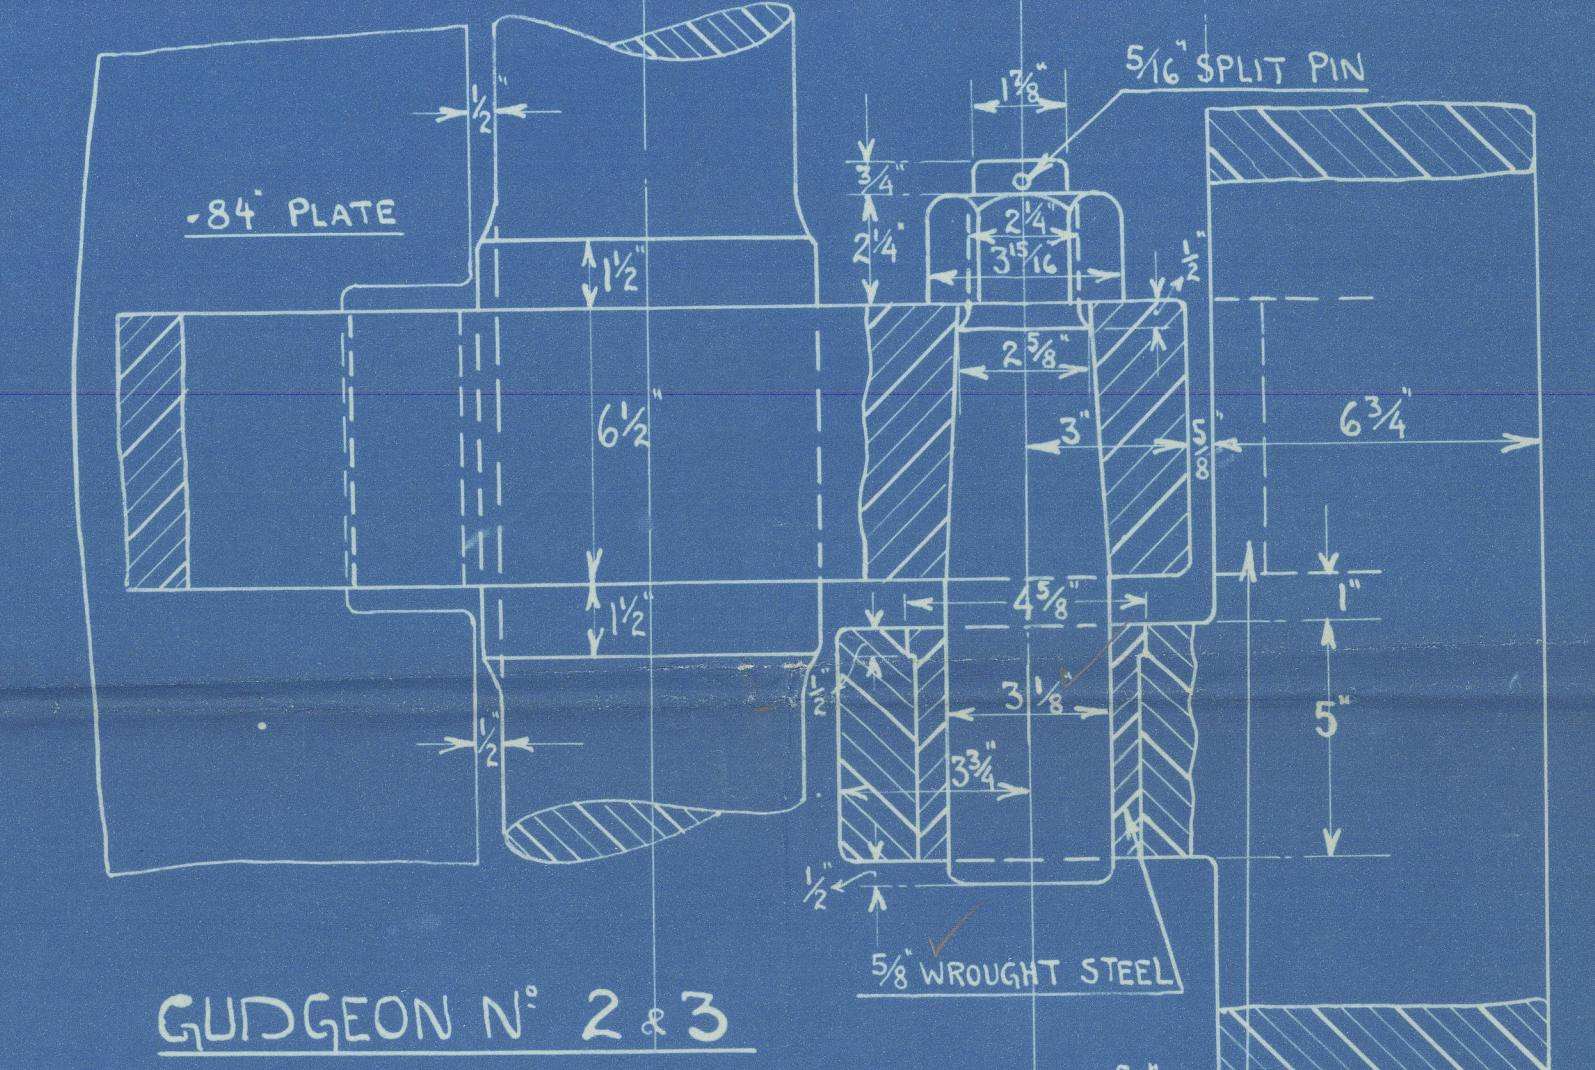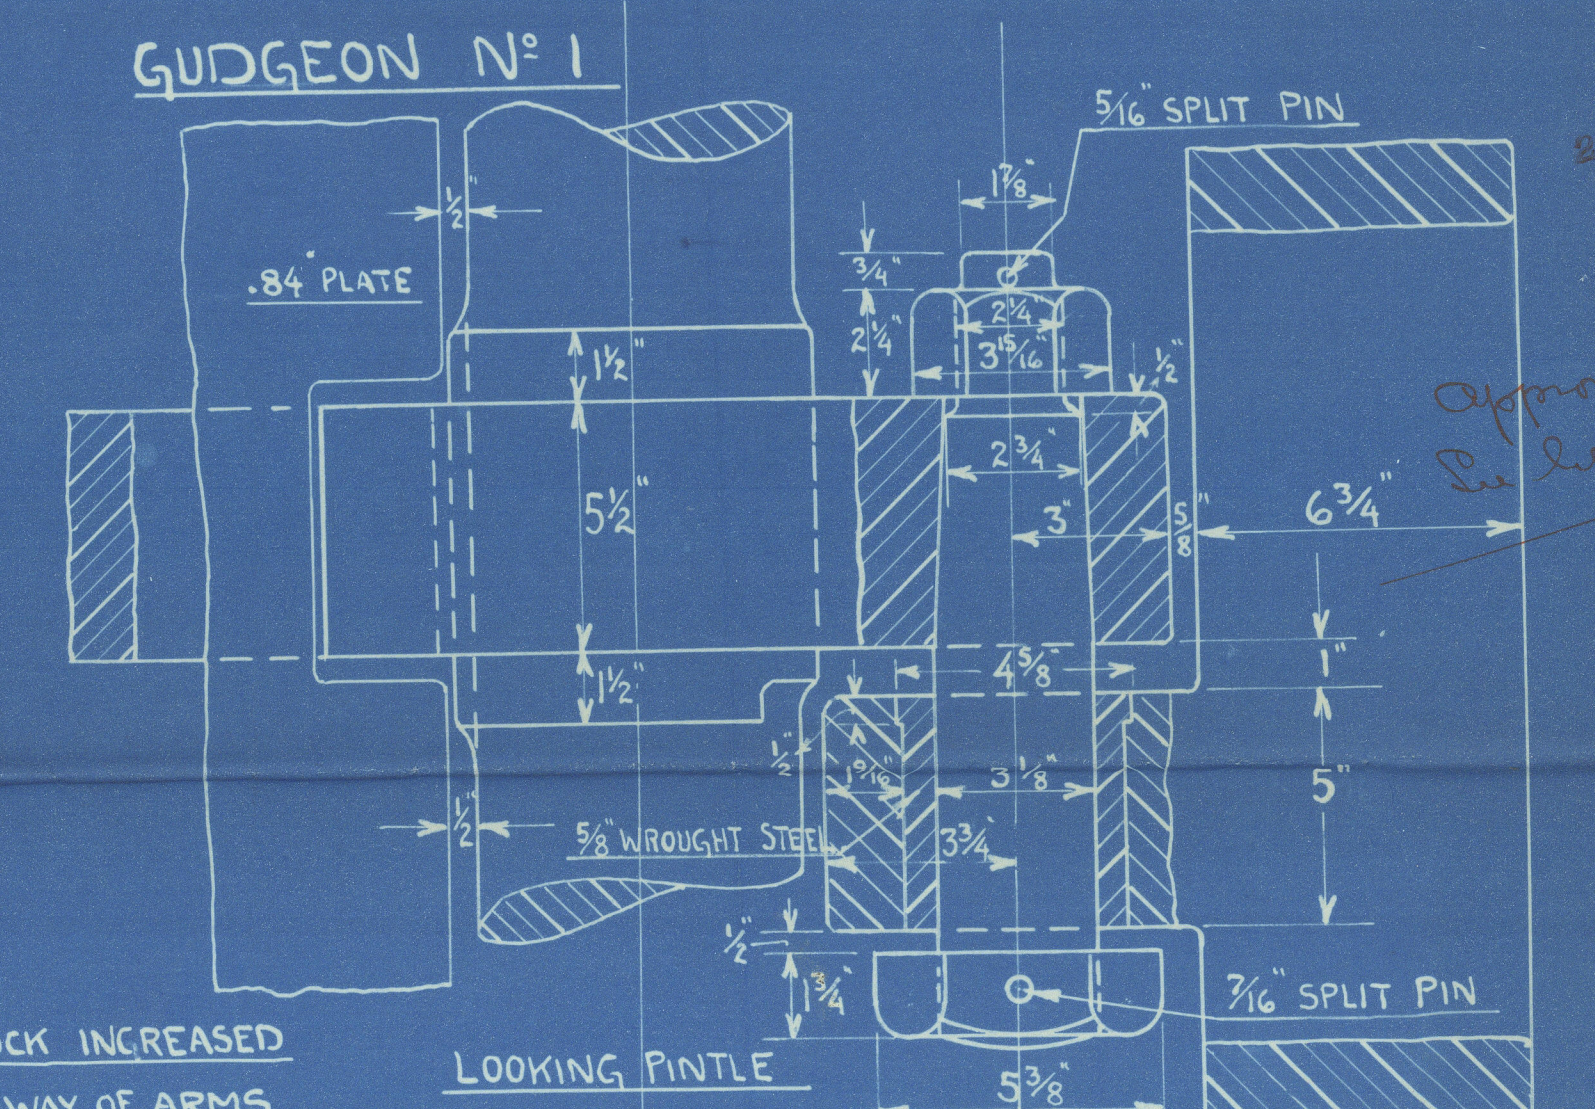

THIS DRAWING IS STRICTLY CONFIDENTIAL AND MUST ON NO ACCOUNT BE COPIED OR DISCLOSED FOR ANY THIRD PERSON. COPENHAGEN, DATE: 1915-3-34. AKTIEGÆLSKABET BURMEISTER & WAIN. MASKIN- & SKIFTEVÆRKT.



STERNPOST & RUDDER. YARD N° 609. 13.6. 15-3-34. 3/4" & 3" = 1'-0".

It

Rudder & Sternpost.


Burmeister & Wain Aht.

No. 609.

22.2.24.

"M WYRALLAH"

Burmeister & Wain No 609.

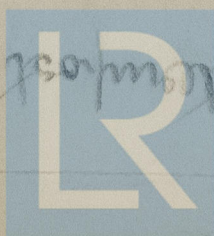

© 2021

Lloyd's Register
Foundation

011427-011432-0194