

12 MAR 1961

71741 -

1 MAR 1961

Index No. (For London Office use)

# LLOYD'S REGISTER OF SHIPPING

## "SANTA FORTUNA" ALTERATIONS TO CONDITIONS OF ASSIGNMENT OF LOADLINES

NEWCASTLE-ON-TYNE No. F.5774

Ship's Name "SANDALWOOD"



Official No. 184595

Port of Registry ~~LONDON~~ Hong Kong

This ship has been under survey at Wallsend-on-Tyne.

on 31st January to 10th February, 1956 and the following alterations to the conditions of assignment of loadlines have now been effected/found:—

Air pipes to oil fuel tanks fitted with steel hoods and wire gauze as shown.

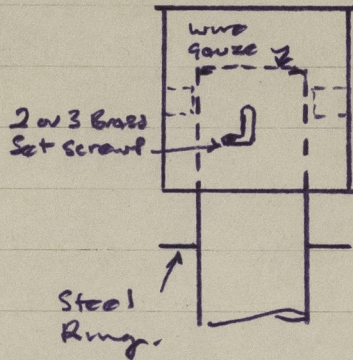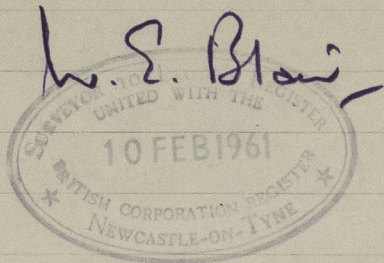

Noted  
at  
3-3-61

A copy of this Report has been placed on board.



© 2021

Lloyd's Register  
Foundation

010890-010904-0025