



Rudder Carrier to be provided

Deckstringer in diesem Bereich ausschneiden u.
nach Montage des Quadranten wieder einschweißen!

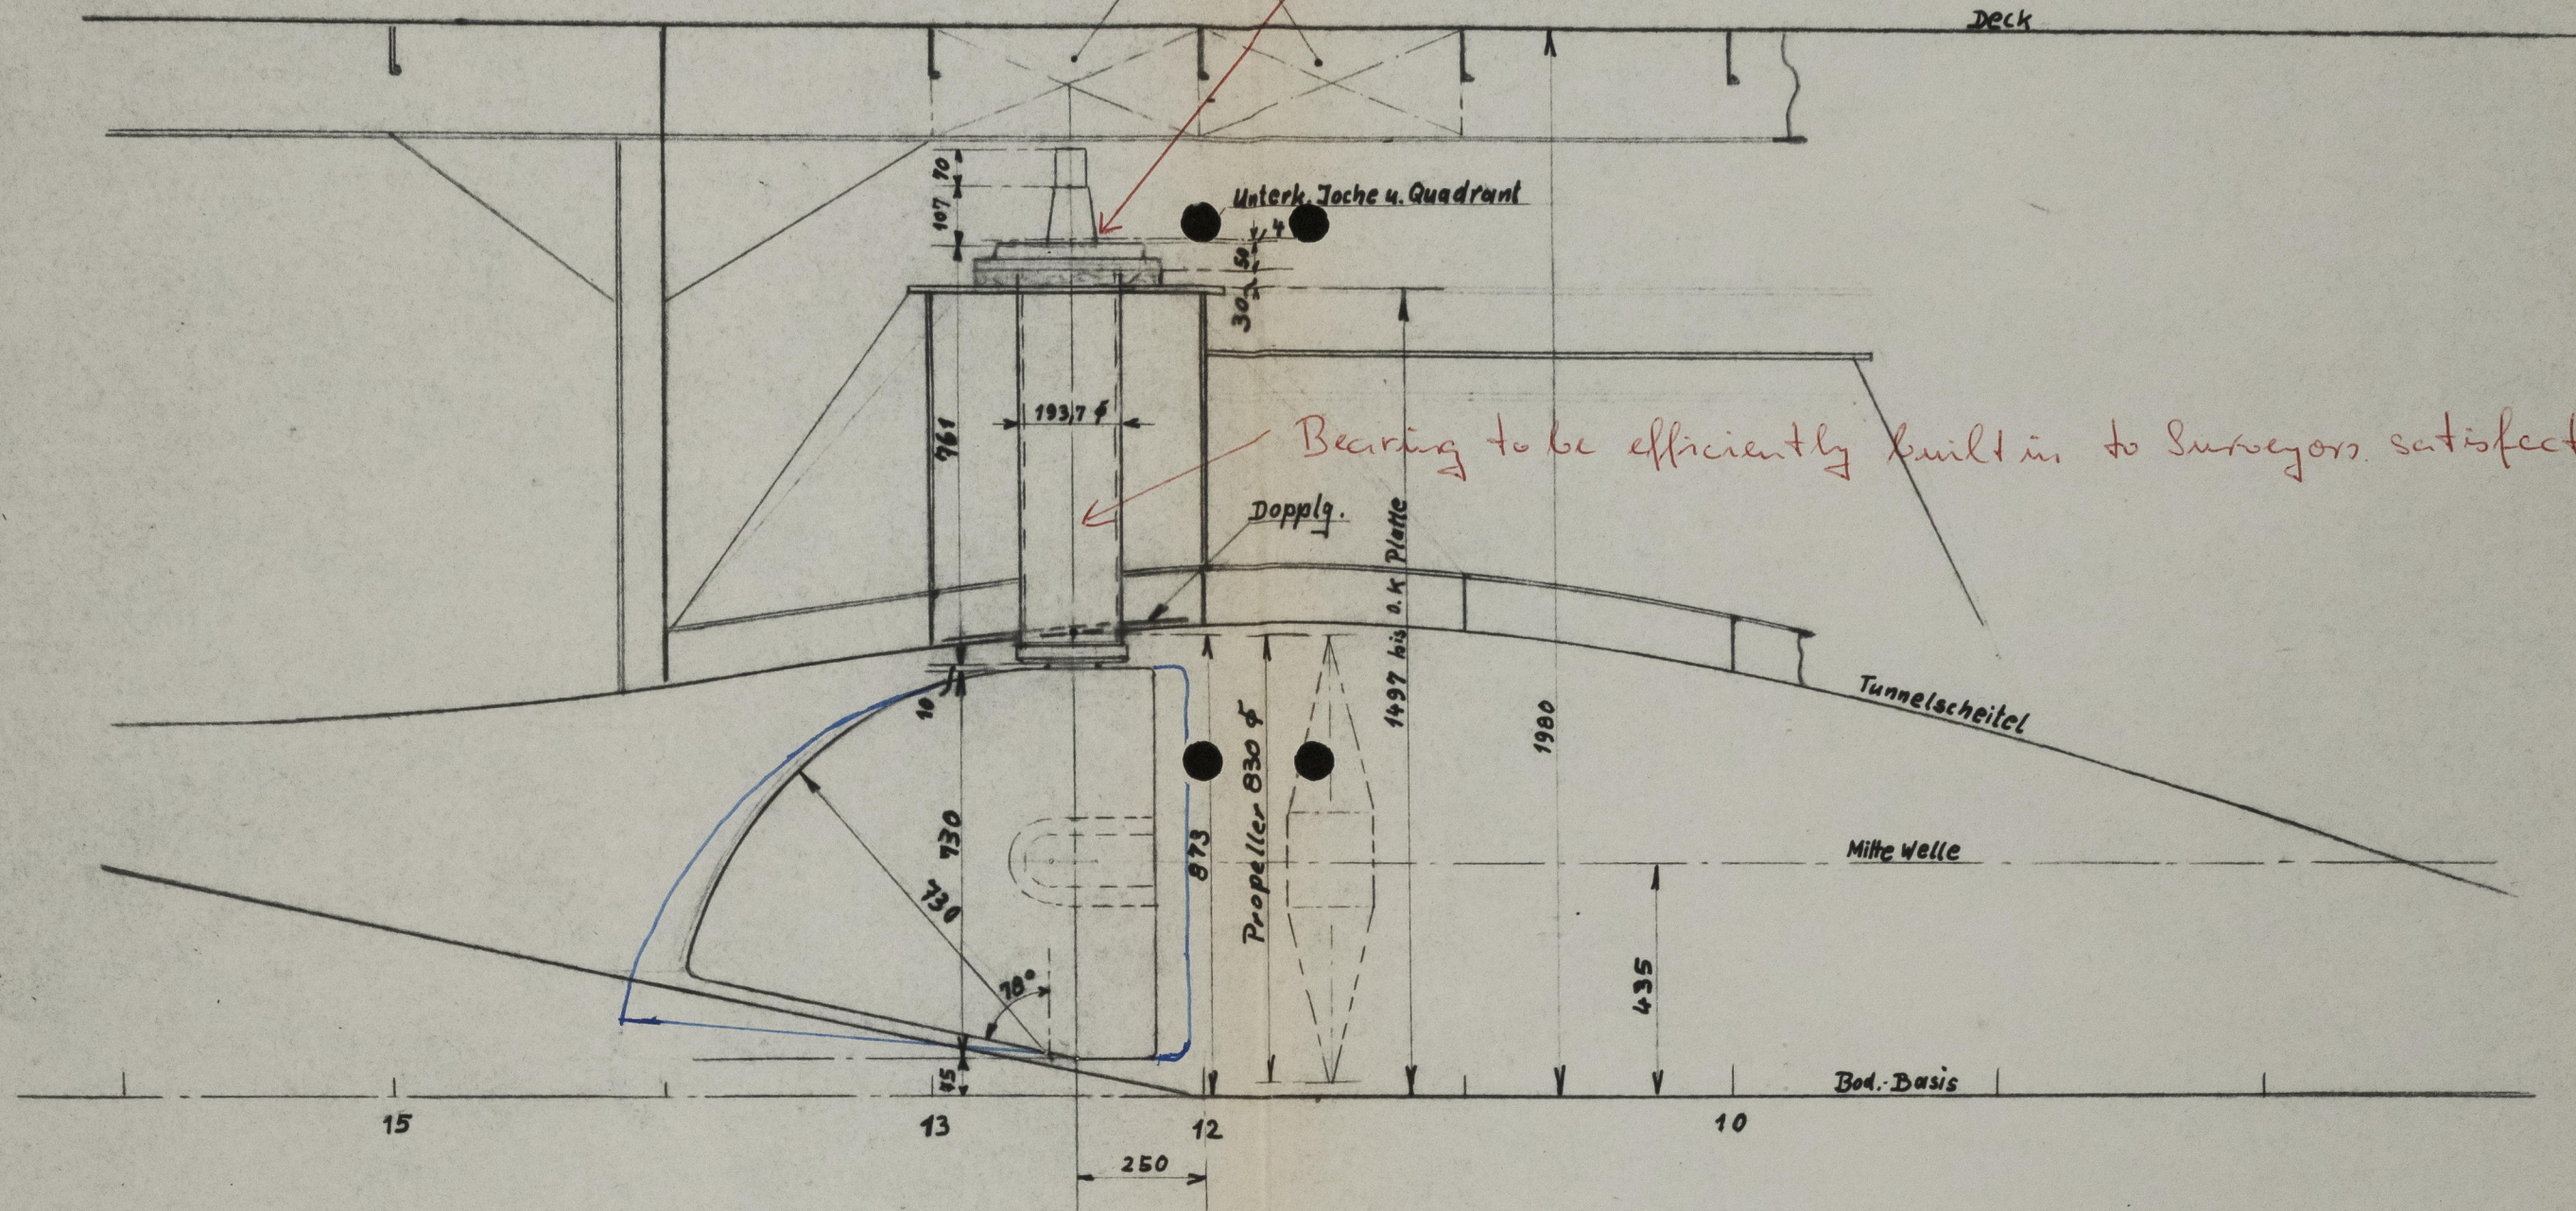

Bearing to be efficiently built in to Surveyors satisfaction

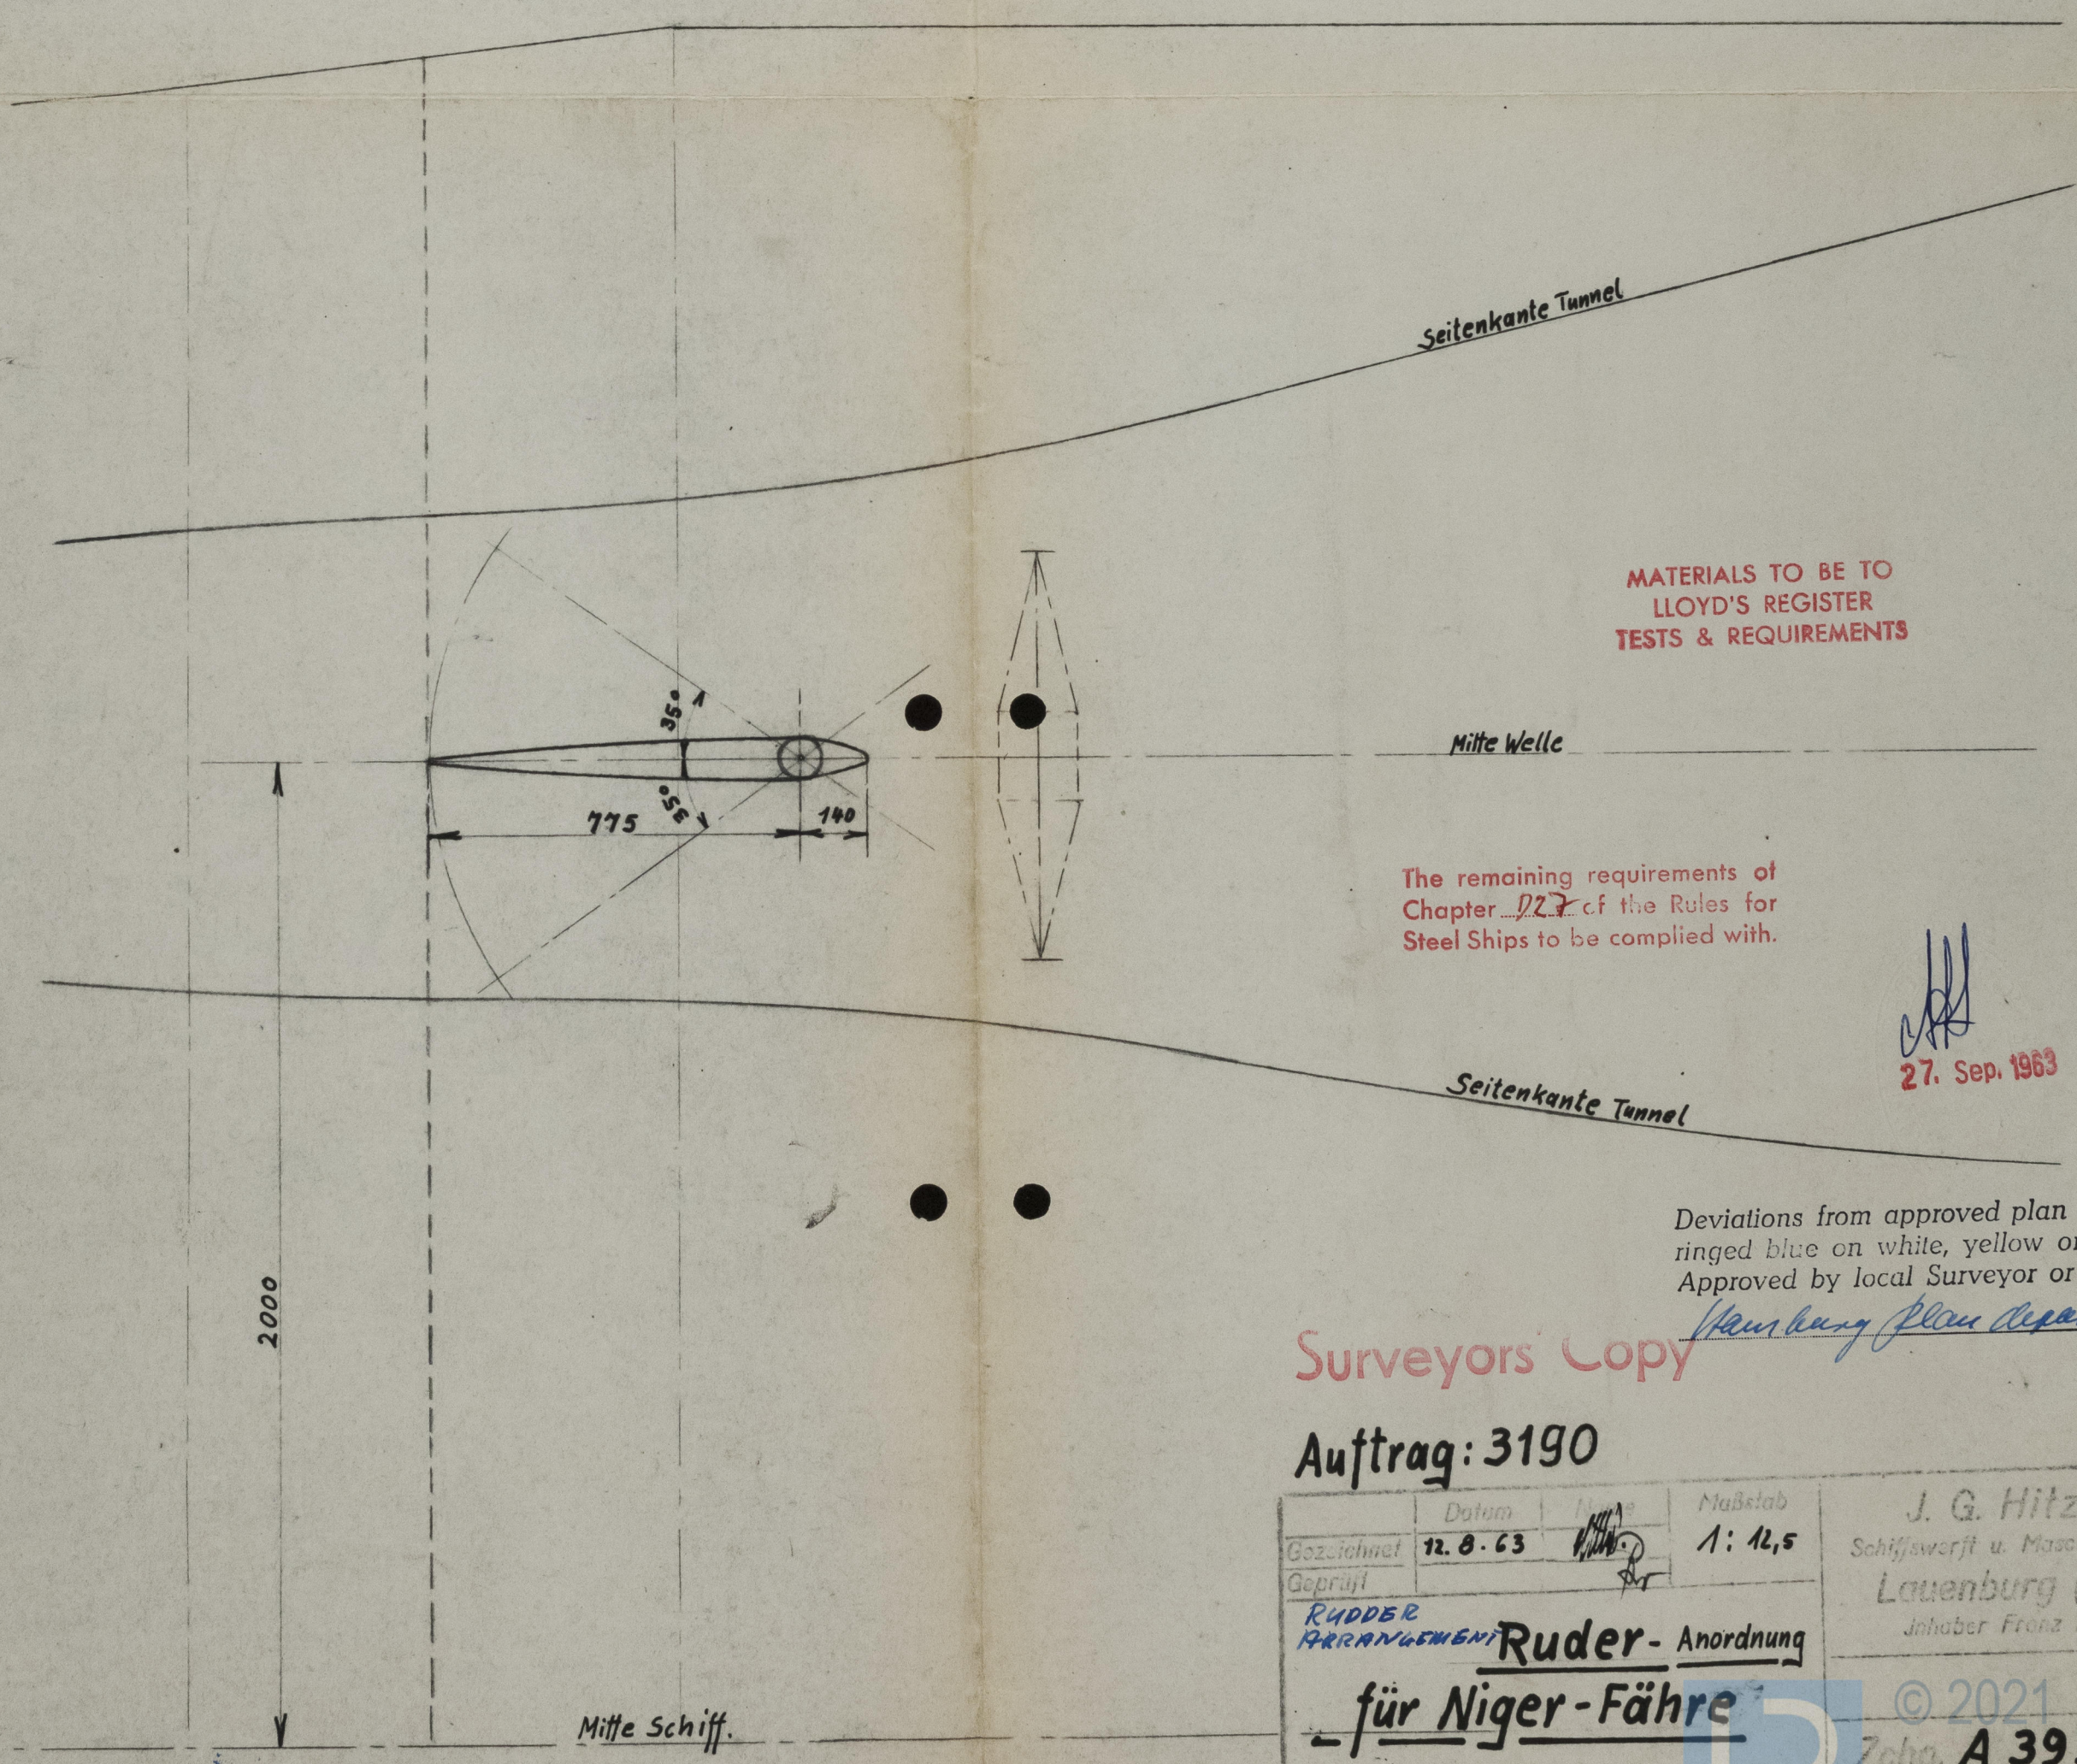

MATERIALS TO BE TO
LLOYD'S REGISTER
TESTS & REQUIREMENTS

The remaining requirements of
Chapter 22 of the Rules for
Steel Ships to be complied with.

27. Sep. 1963

Deviations from approved plan marked or
ringed blue on white, yellow on blue.
Approved by local Surveyor or by

Surveyors Copy

Auftrag: 3190

Gezeichnet	Datum	Maßstab	J. G. Hitzler Schiffswerft u. Maschinenfabrik Lauenburg (Elbe) Inhaber Franz Hitzler
Geprüft	12. 8. 63	1: 12,5	
RUDDER ARRANGEMENT			
Ruder- Anordnung für Niger-Fähre			

RECORDS DEPT.,
LONDON.

6

Rudder Arrangement

Retain with Hamburg

Ship First Entry

Report No. *13516*

SS/MS *"SAPELE"* ★

R. Meier & Söhne,

Yard No. 65



© 2021

Lloyd's Register
Foundation

011438-011484-0061