


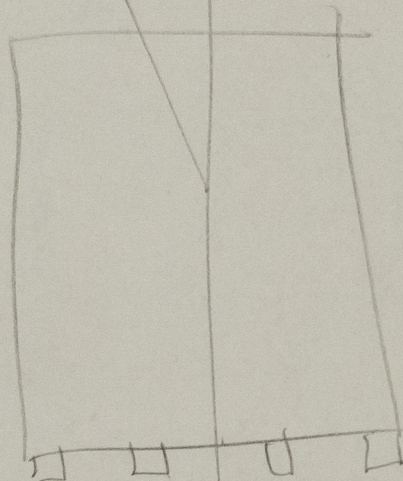


RECORDS DEPT.,
LONDON.

9

OLD



NEW

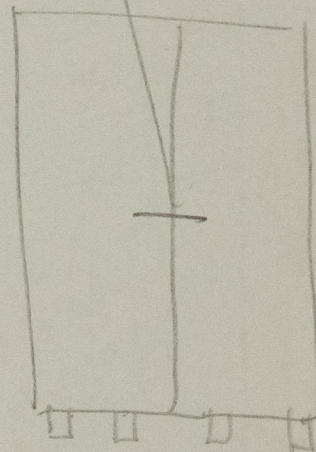

Ramps

Retain with Hamburg
Ship Country
Report 13516
SS/MS "SAPELE" ★

R. Meier & Löhner, Yard No. 65