

No 574. PROFILE & DECKS (As Fitted)

SCALE 1/8" = ONE FOOT.

DIMENSIONS AS PER RULE.
LENGTH B.P. 405.0'
BREADTH MLD. 55.5'
DEPTH MLD. UPP DK 31.50' ABOVE TOP
DEPTH MLD. RQ. DK 33.88' OF KEEL
CLASS HOAI WITH DRAFT OF 23.42' ABOVE TOP
OF KEEL


ALL SECTIONS SPECIFIED ON
THIS PLAN ARE N.B.S.


PARTICULARS OF HULLBOARD
96% OF LENGTH INCLUDING CRUWER STERN 398.84'
LENGTH BETWEEN PERPENDICULARS 405.00'
BREADTH MOULDED 55.50'
DEPTH MID FROM TOP OF KEEL TO UPPER DECK (BEARING ON PLATING) 31.50'
85% OF DEPTH MID TO UPPER DECK 26.73'
MOULDED DISPLACEMENT AT 85% DEPTH MID UPPER DECK 19442 TONS
COEFFICIENT OF FINENESS 7.85
APPROX TONS PER INCH 46.07
ROUND OF BLAM 134'
SCANTLING FLOOR WITH MILD DRAUGHT (FROM TOP OF KEEL) 23.36'
SWER ART SIDE OF STEER PART 4.61' SKEWER CURVE
FORE PERPENDICULAR 9.3' PARABOLIC
LENGTH OF FORECASTLE 24.75' FITTED WITH CLASS I CLOSING APPLIANCES
FORECASTLE 7.5' HIGH
LENGTH OF RAISED QUARTER DECK 279.66'
RAISED QUARTER DECK 23.6' ABOVE UPPER DECK

BOAT DECK

LLOYD'S LONDON STAMP
28 JUNE 1961

AFT DECKHOUSE
TOP

 

SS. "RUSHWOOD" 

J. READHEAD'S 574.



PROFILE & DECKS (AS FITTED)

2 RUSHWOOD
Newcastle-upon-Tyne
Report No. 110442
Yard No. 574

RODOP1

D/S 799

RECORDS DEPT.
LONDON

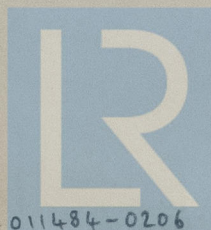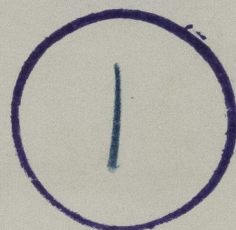

© 2021

Lloyd's Register
Foundation

011478-011484-0206