


SCALE: $\frac{1}{4}'' = \text{ONE FOOT}$

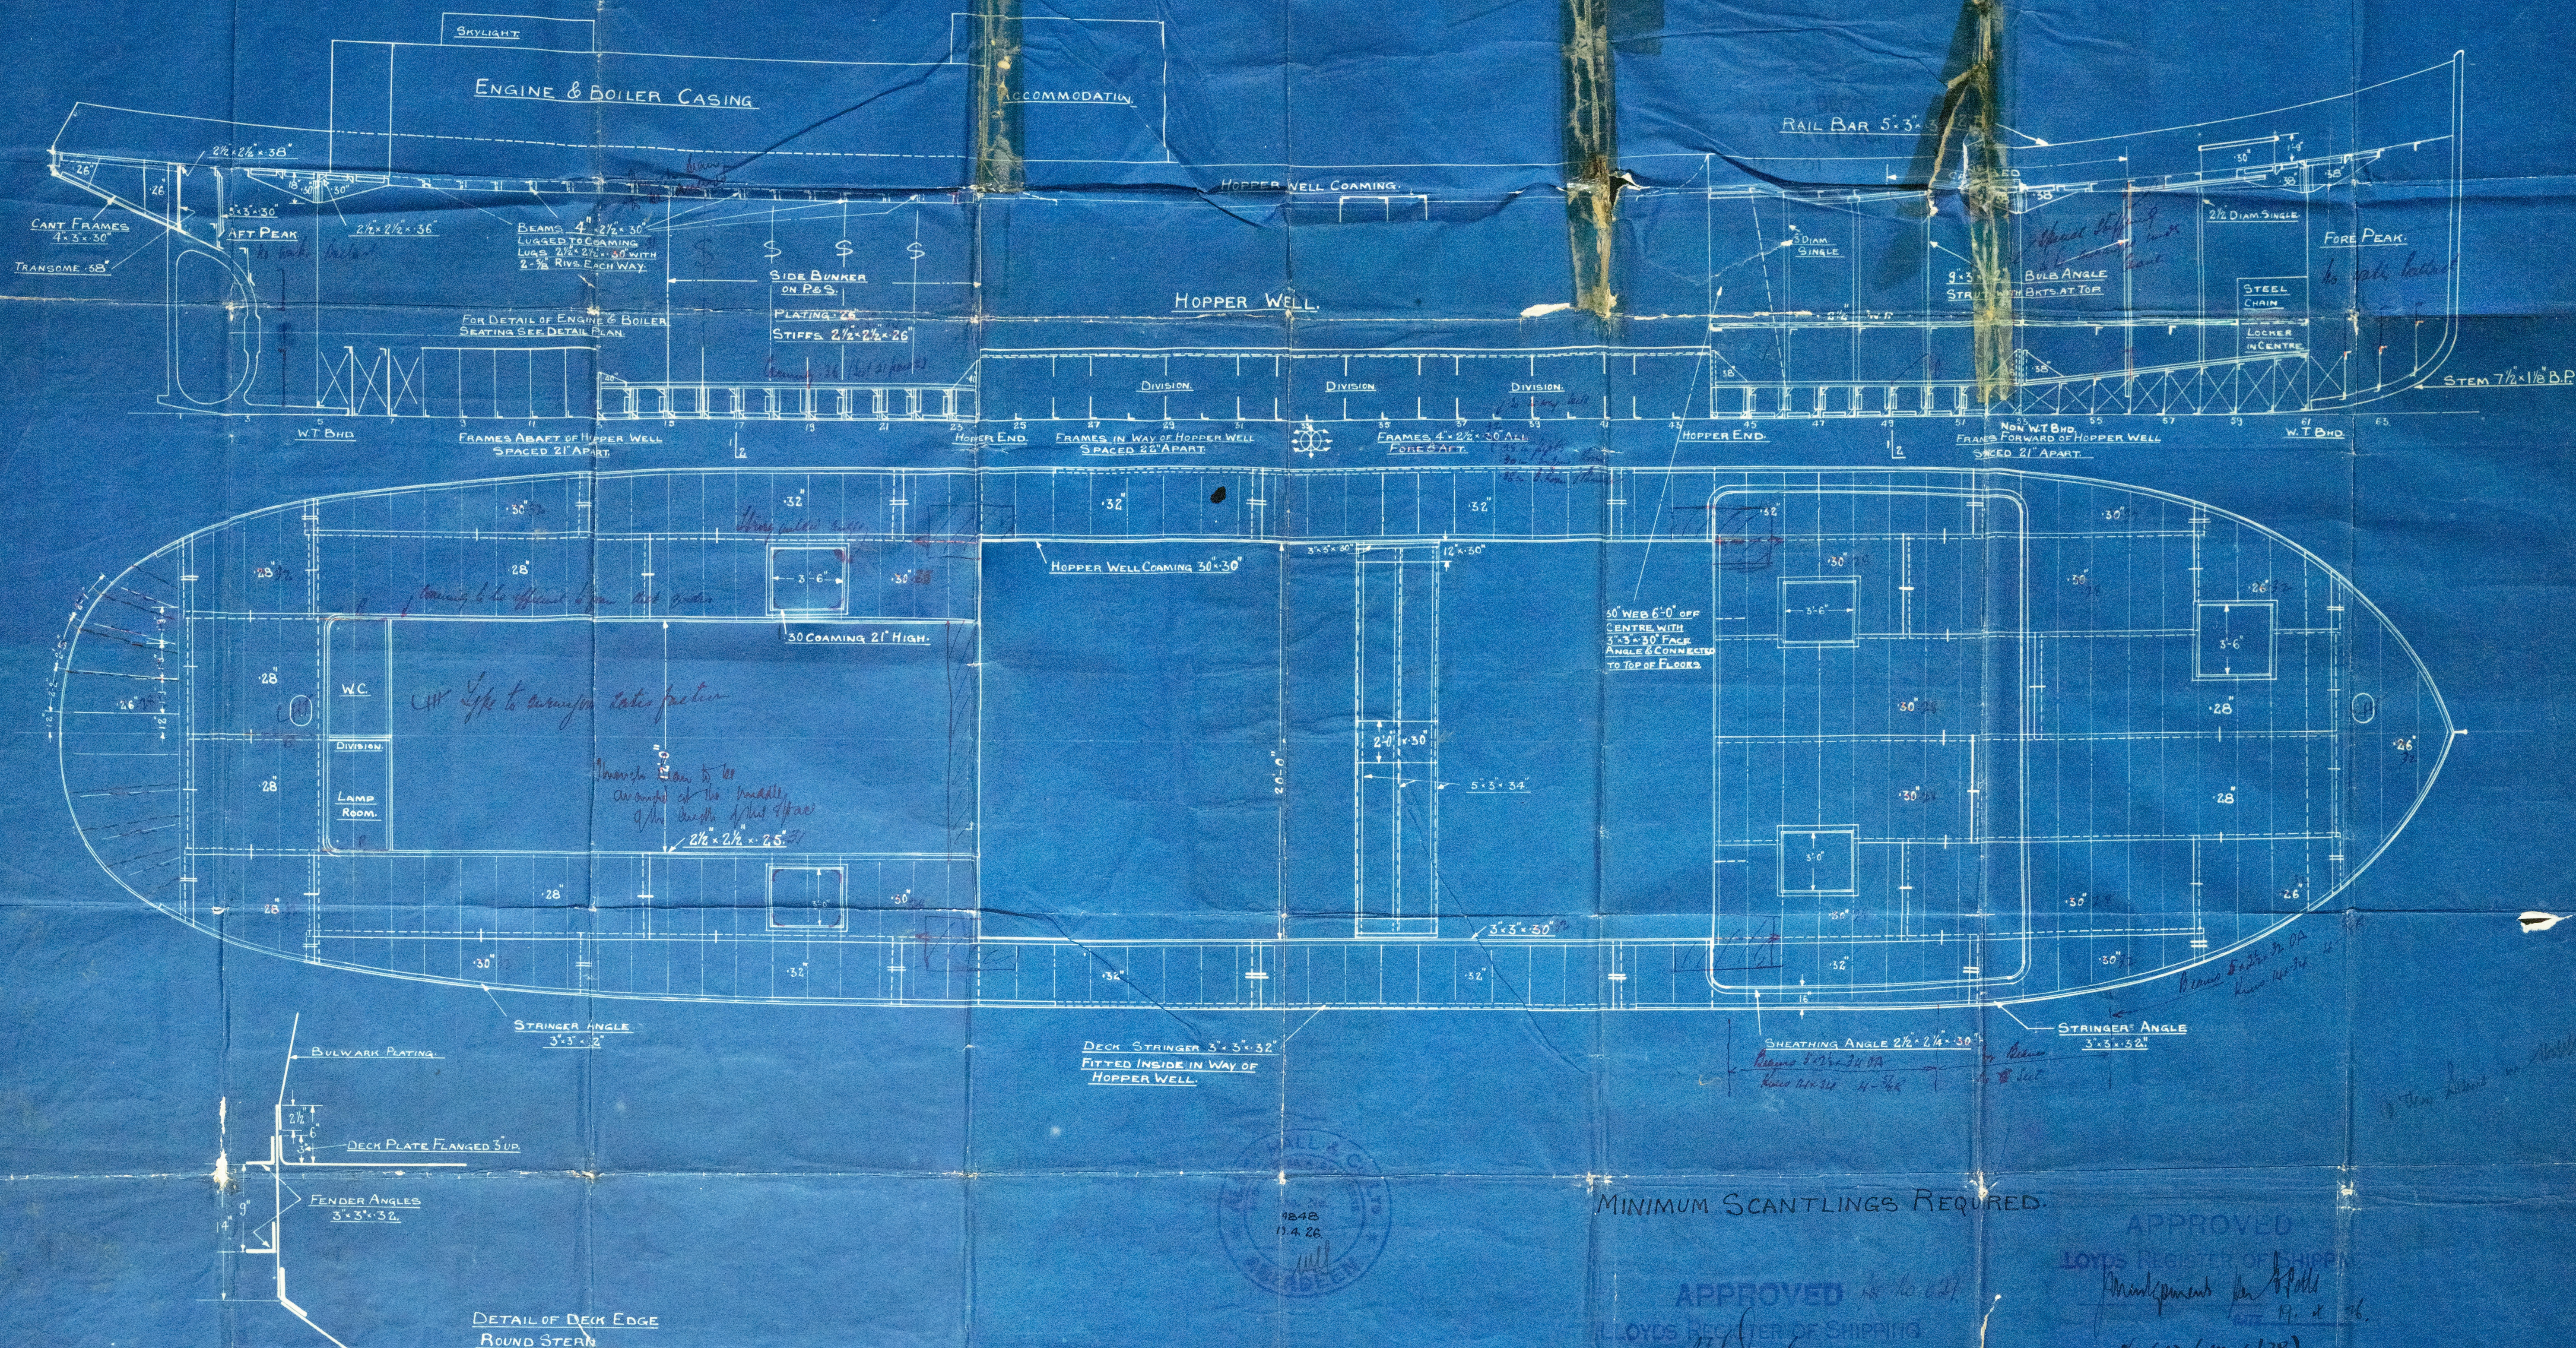

MINIMUM SCANTLINGS REQUIRED.

Management for Gold
DATE 19. 11. 20
No. 612 (14. 6/28)

Nº 601.

MESSRS A. HALL & CO L^D.

PROFILE + DECK.

S.S. "CLEARWAY"

ABN. REPORT. 14676

No. 612

S.S. "FRANCIS GILBERTSON."

ABN. REPORT 15394.

No 629

155

011493-011498-0124



© 2021

Lloyd's Register
Foundation