

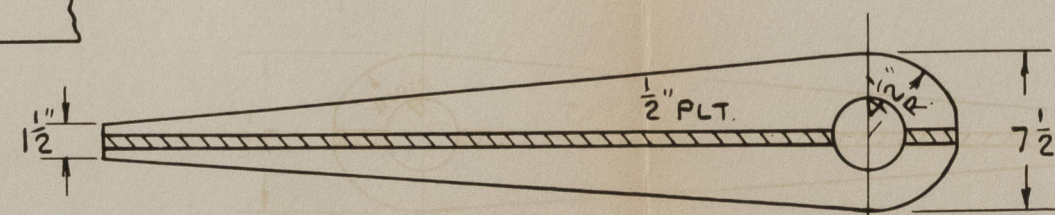



DETAIL OF BOTTOM PINTLE
SCALE :- 3" = 1 FOOT.

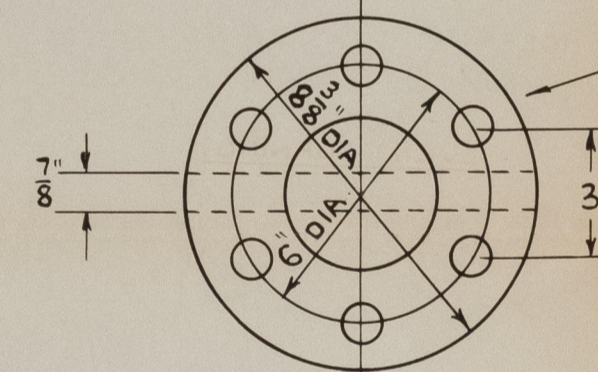

PLAN OF RUDDER STIFFS

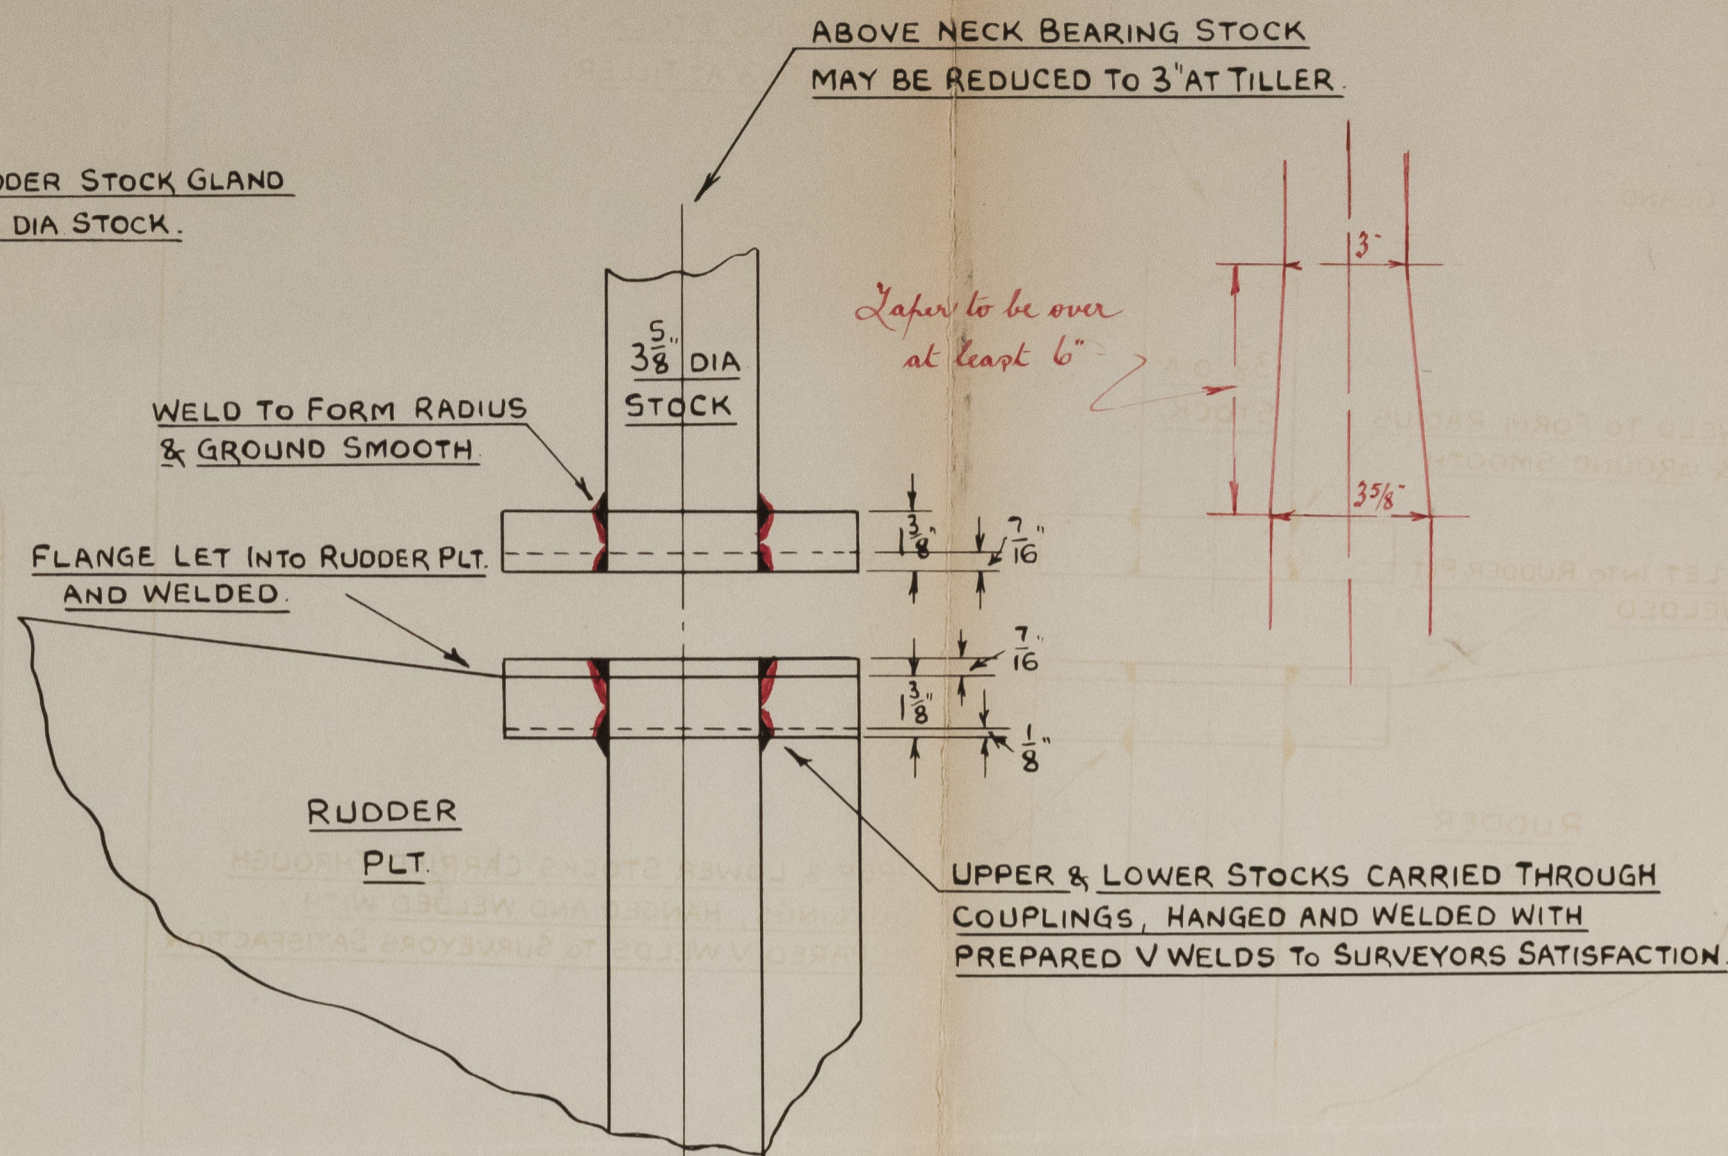

PLAN OF UPPER COUPLING

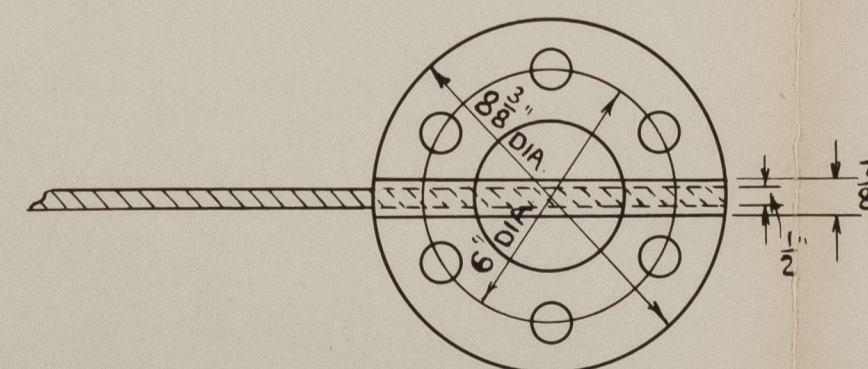

PLAN OF LOWER COUPLING

SCALE :- 3" = 1 FOOT.

HOLES TO SUIT 1" DIA. BOLTS.
EDGES OF HOLES TO BE SLIGHTLY ROUNDED.
BOLT HEADS TO BE SPOT WELDED TO PREVENT TURNING.

Speed not exceeding 8 knots.

APPROVED
LLOYDS REGISTER OF SHIPPING

Date 9/3/61


BERWICK SHIPYARD LTD.
TUG T.I.D. 66
PROPOSED RUDDER
SCALE :- 1 1/2" = 1 FOOT
13-2-61

RUDDER

TID. 66. ★

LEITH REPORT NO 24988

REC'D DEPT.
LO. 701

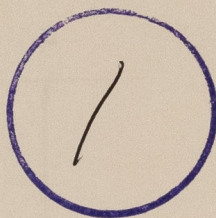

MS "T.I.D. 66"

TO ACCOMPANY... LTH Rpt. No 24988

Dated 7.7.61.

SUBJECT:- Rudder.



© 2021

Lloyd's Register
Foundation

011506-011515-0123