

$\frac{3}{4}$ " = 1 FOOT

Rudder Stock FORGED STEEL Frame FORGED IRON

AREA 56 SQ. FT. CG 2.555' AFT OF  $\frac{1}{2}$  OF PINTLES

A x D 143 . SPEED NOT EXC. 12 KNOTS

RULE DIA<sup>R</sup> 6" FITTED 6½" DIA<sup>R</sup>


L \* D = 240.0' \* 16.58' = 3980

CRUISER STERN.

FRAME SPACING 23" IN PEAKS

Reference No. 2/391

Details  $1\frac{1}{2}" = 1 \text{ foot}$

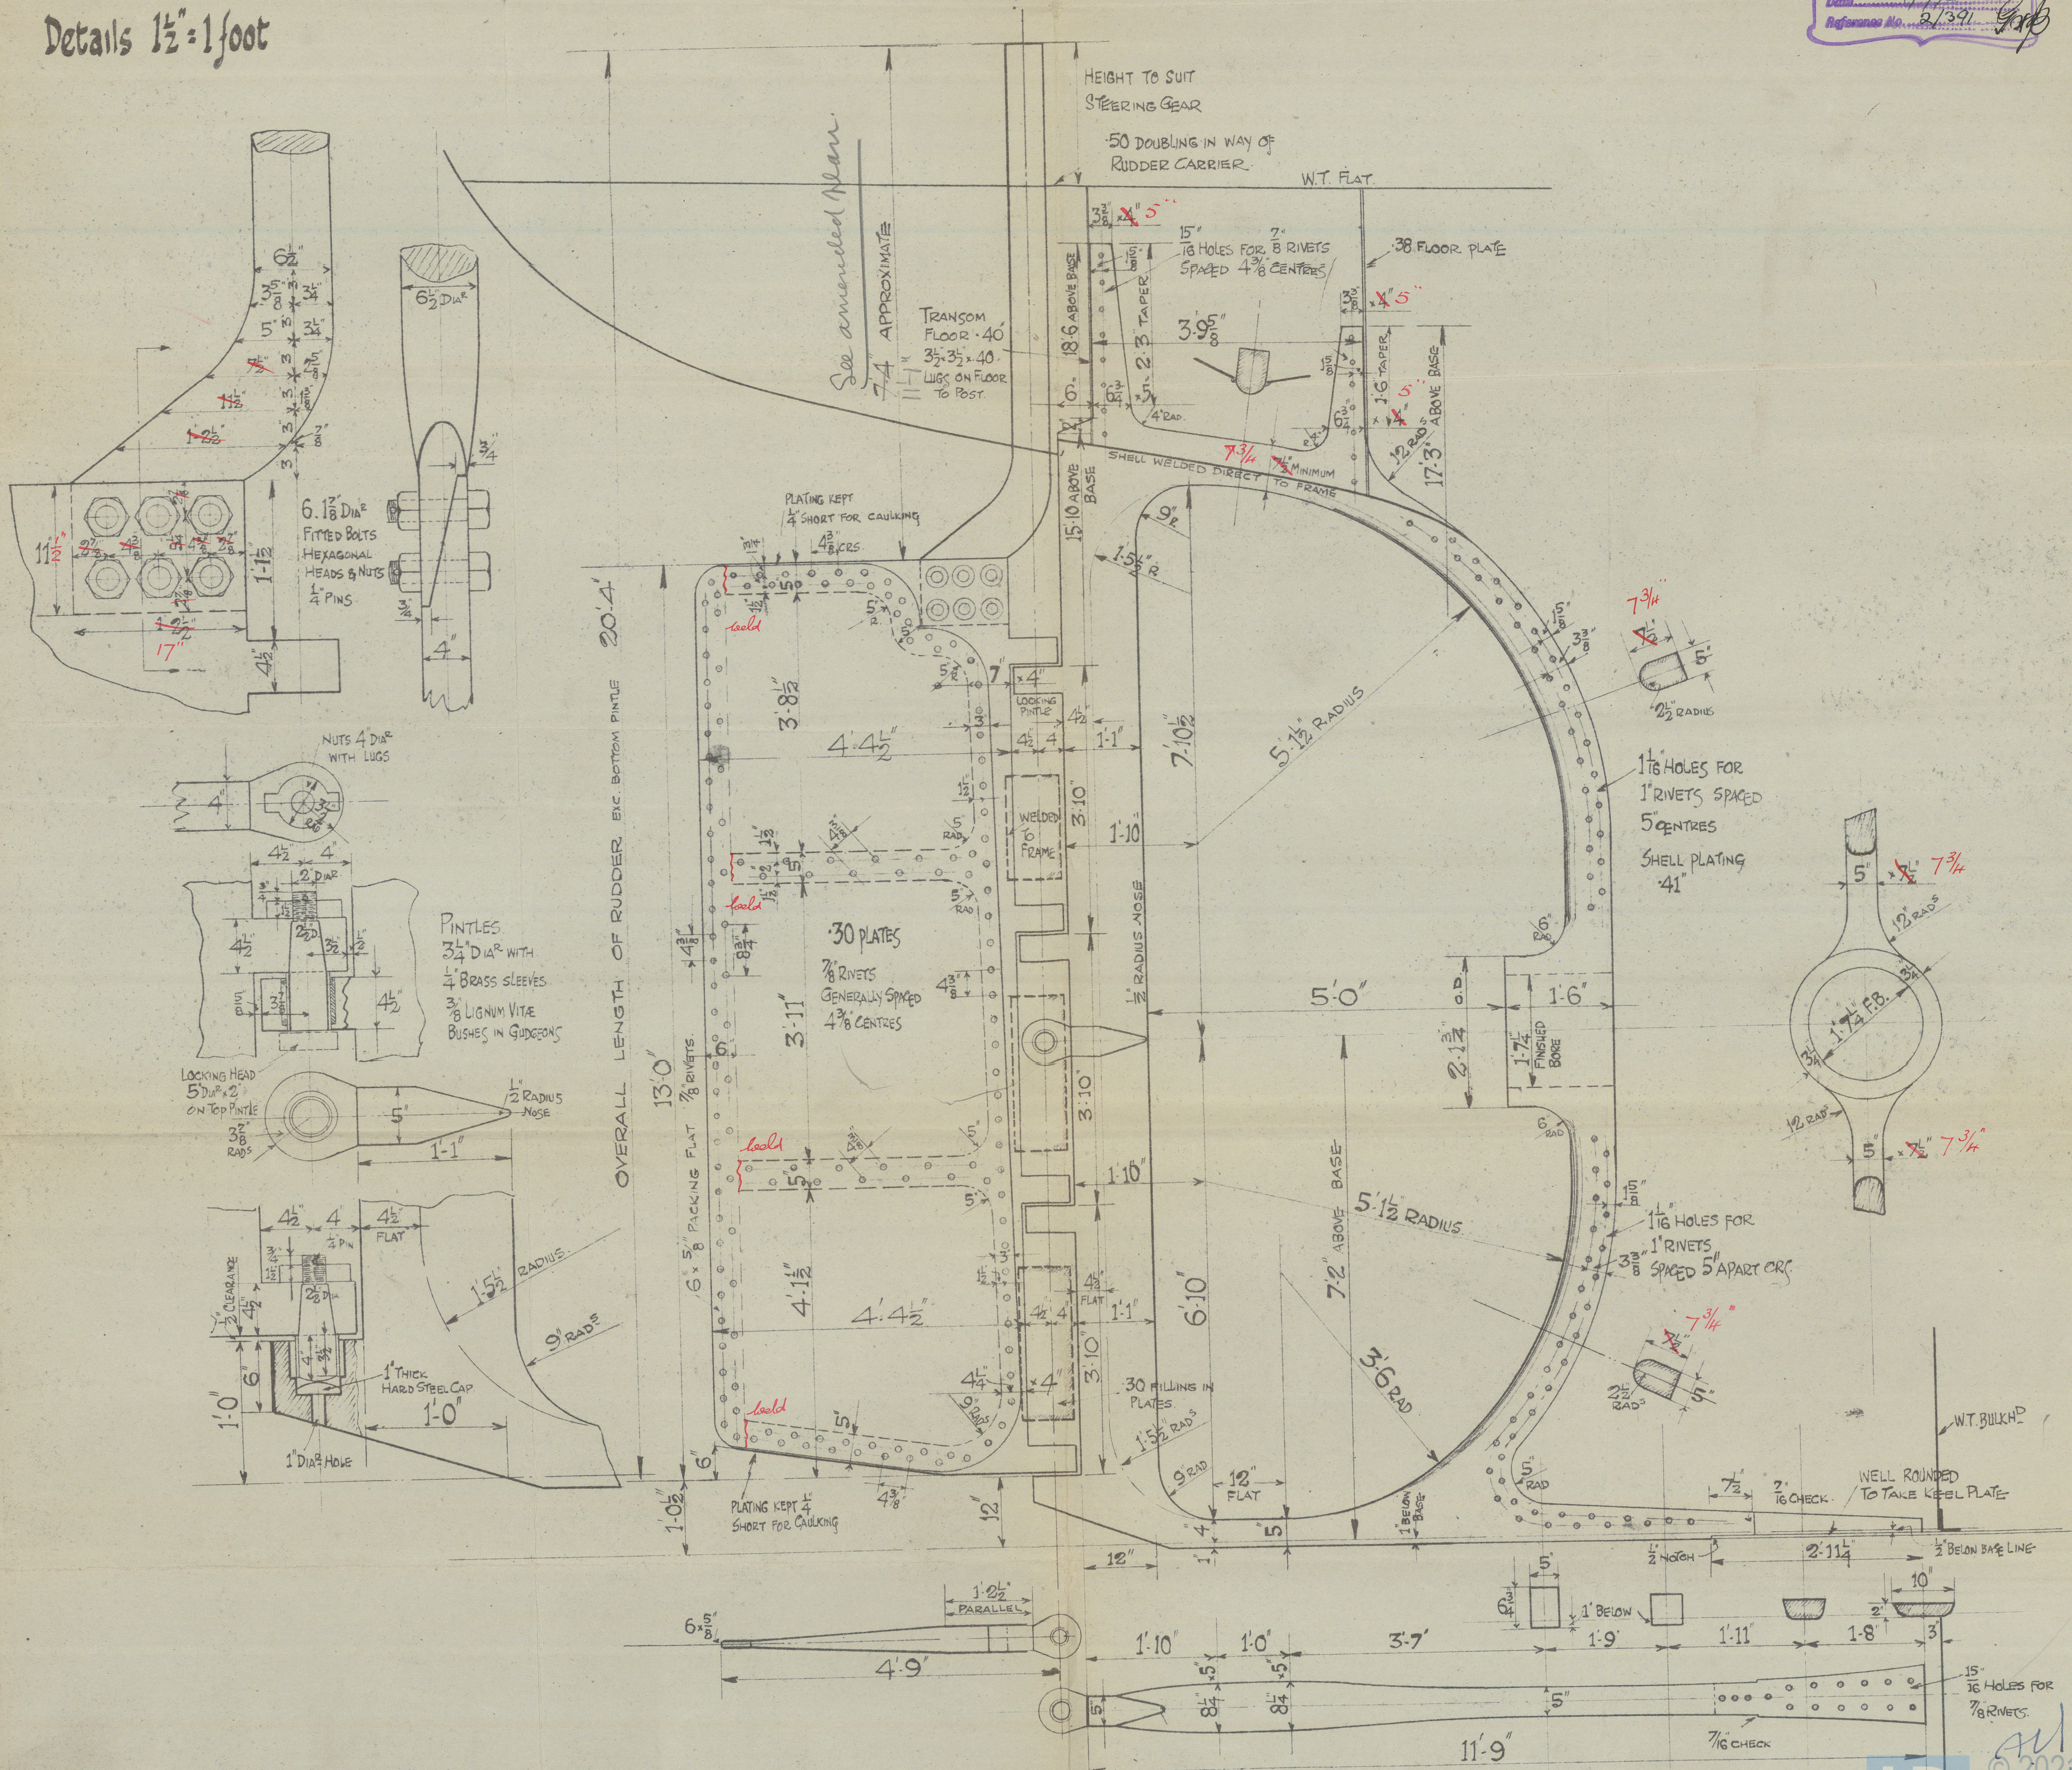



*S. P. Austin & Son.*

*Yard No. 391*

*Rudder & Stern frame.*



© 2021

Lloyd's Register  
Foundation

011516-011523-0143



Austins 391

Sternframe & rudder

BUNDERLAND RPT. NO. 34837

"Blank some"



5



© 2021

Lloyd's Register  
Foundation