

17 AUG 1955

Report No. 23852.

Rpt. C. 11 (Contd.)



Index No.

## Lloyd's Register of Shipping.

Ship's Name "EARNER"

Official No. 169327

Memorandum of alterations reported since ship was surveyed for assignment of Load Lines in

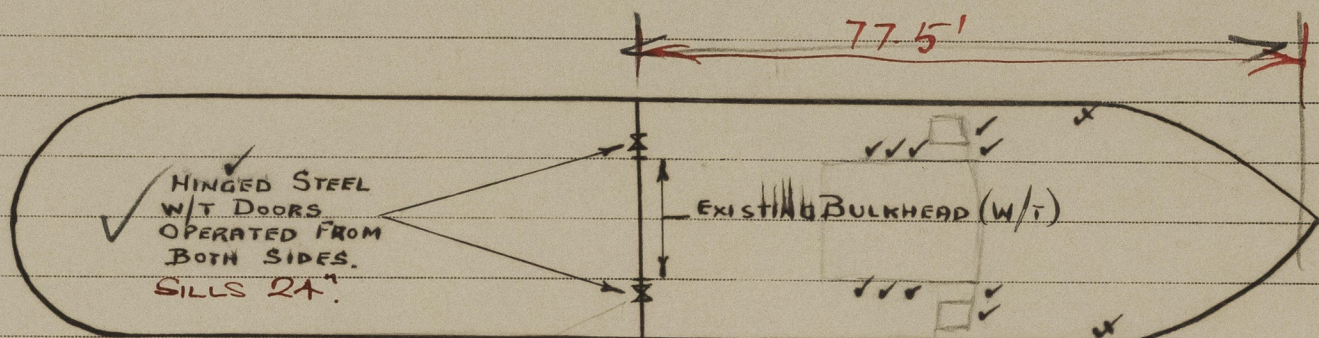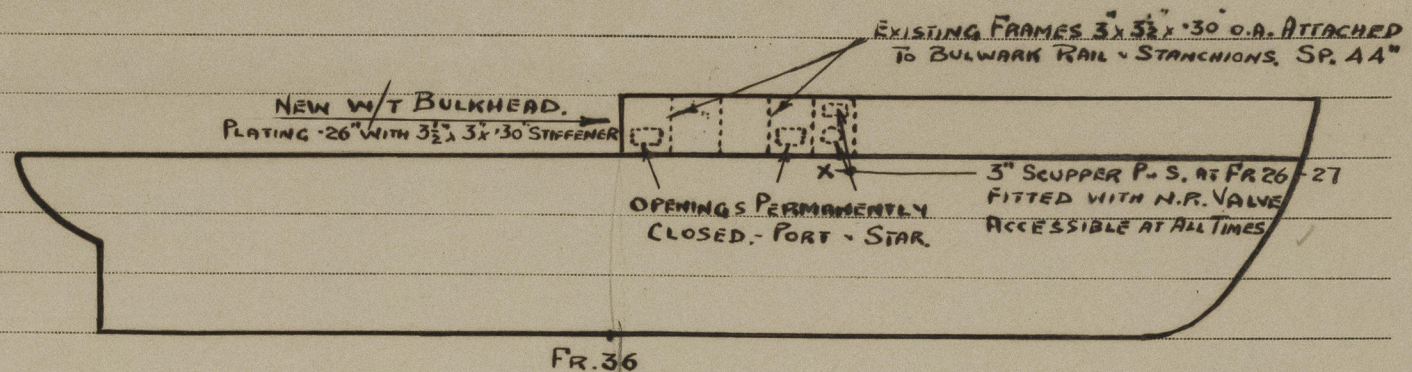

VENT. COAMINGS .30" IN THICKNESS,

HEIGHT 30" ABOARD .25L &amp; 36" + 72" FORWARD

OF .25L VENTS. OVER 36' SUPPORTED

repaired by welding & painting  
 & means of closing.

✓ = 6" STEEL GOOSENECK VENTILATORS WOOD PUGS & CANVAS COVERS  
 ✓ = 6" STEEL MUSHROOM TYPE " CANVAS COVERS.

T. J. Morris

✓  
 air  
 6-9.5'