
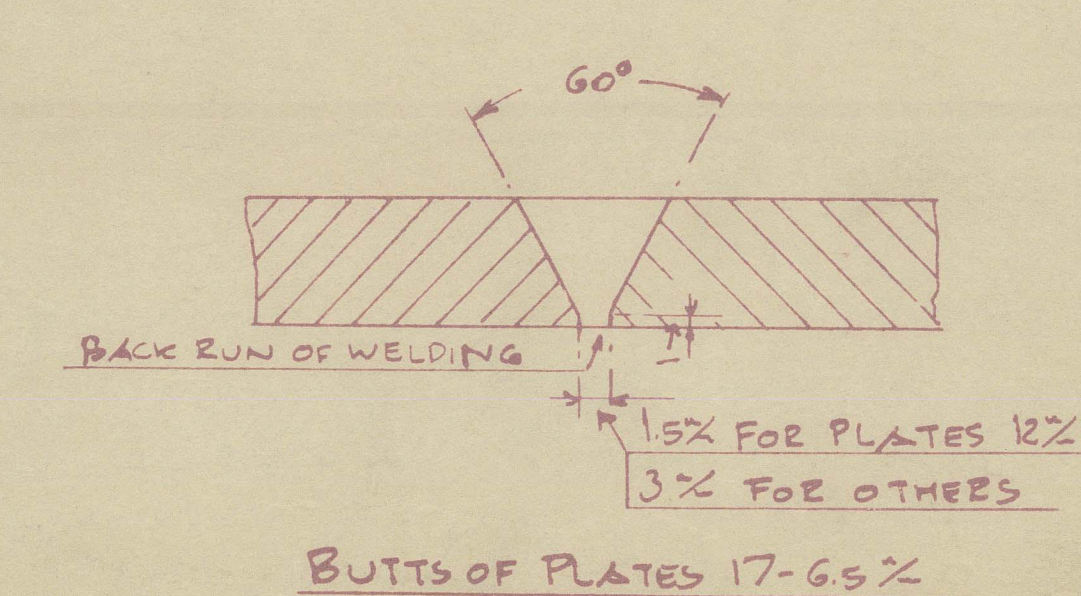


1 SINGLE RITTED
 4 DOUBLE

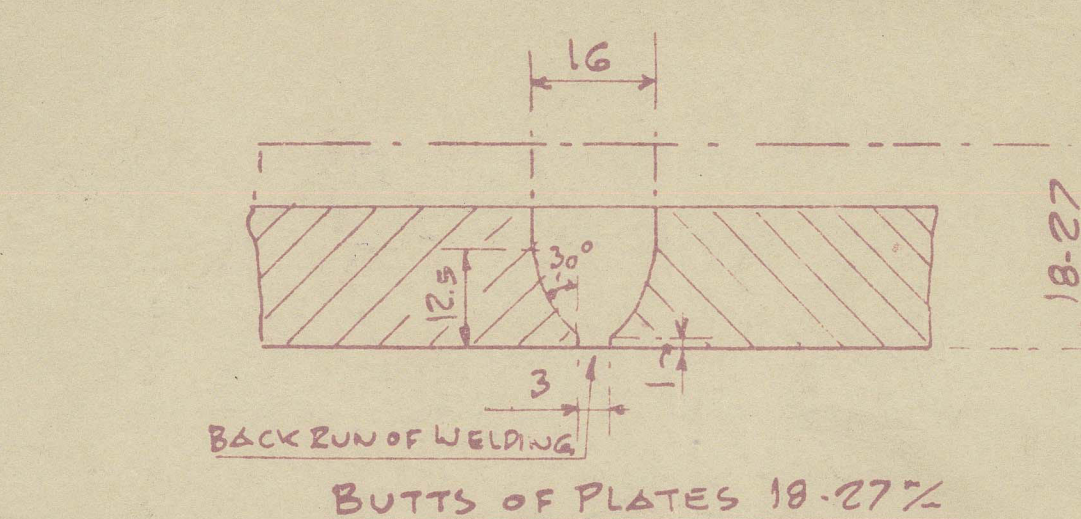

DIMENSIONS:
 LENGTH P.P. = 511'10" = 156.004 m
 BREADTH MOULDED = 52'10" = 16.116 m
 DEPTH = 39'3" = 11.982 m
 CORRECTED FOR NORMAL SHEER = 38'0" = 11.582 m

ALL BULBANGLES NEW GERMAN STANDARD.

REQUIREMENTS OF SECTION 22 OF THE RULES TO BE COMPLIED WITH WHERE APPLICABLE. FLASHPOINT OF THE OIL FUEL NOT TO BE BELOW 180°F.

CLASS:
 LLOYD'S REGISTER 100 A 1 CARRYING PETROLEUM IN BULK. SPECIAL NOTATIONS: "PART ELECTRICALLY WELDED" AND "LONG-TUDINAL BEAMING AT BOTTOM AND DECK"

GOTHENBURG FIRST ENTRY REPORT NO. 14499.

RECORDS:
 LLOYD'S REGISTER GÖTTERVERKEN
 M/S 546 SAN ANTONIO
 LONGITUDINAL SECTION AND PLANS

DATE: 24.12.41

CORRECTED AS APPROVED BY LLOYD'S 30.7.39
 BUILT 23/12-40 FOR M/S 546.550

011574-015285-0005 112004