



LONGITUDINAL SECTION LOOKING ON SIDE OF O.F. TANKS

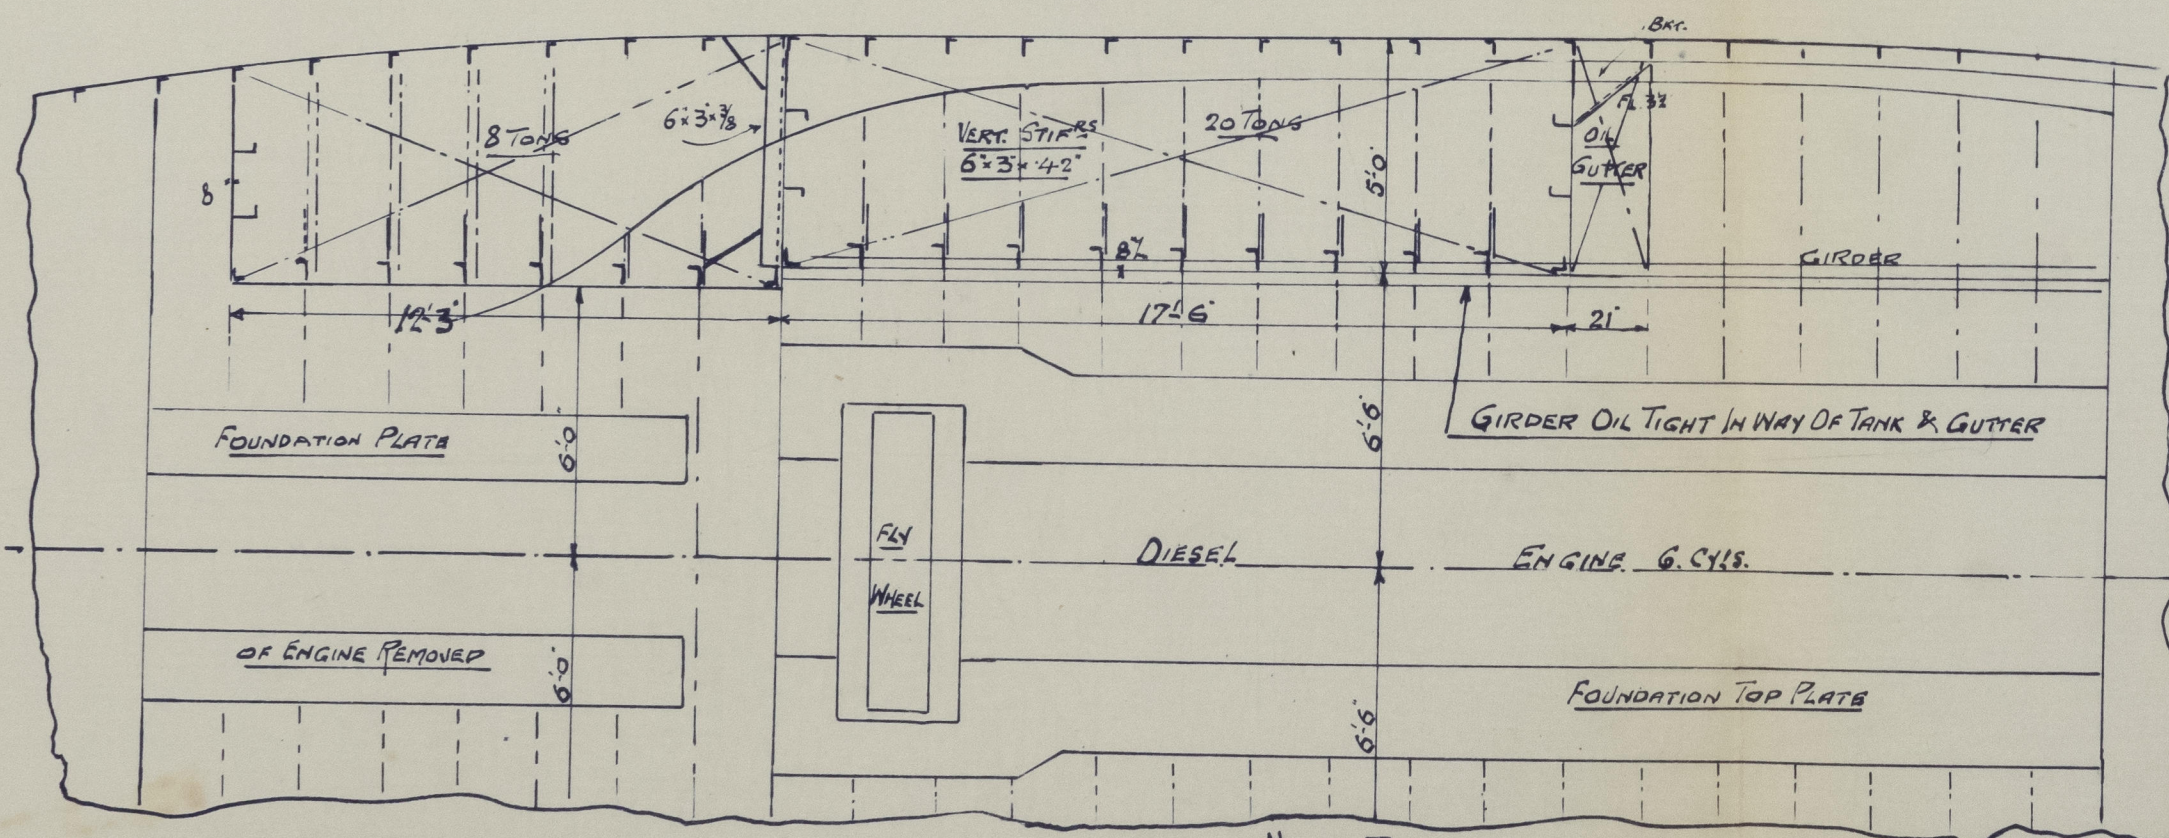

HALF PLAN

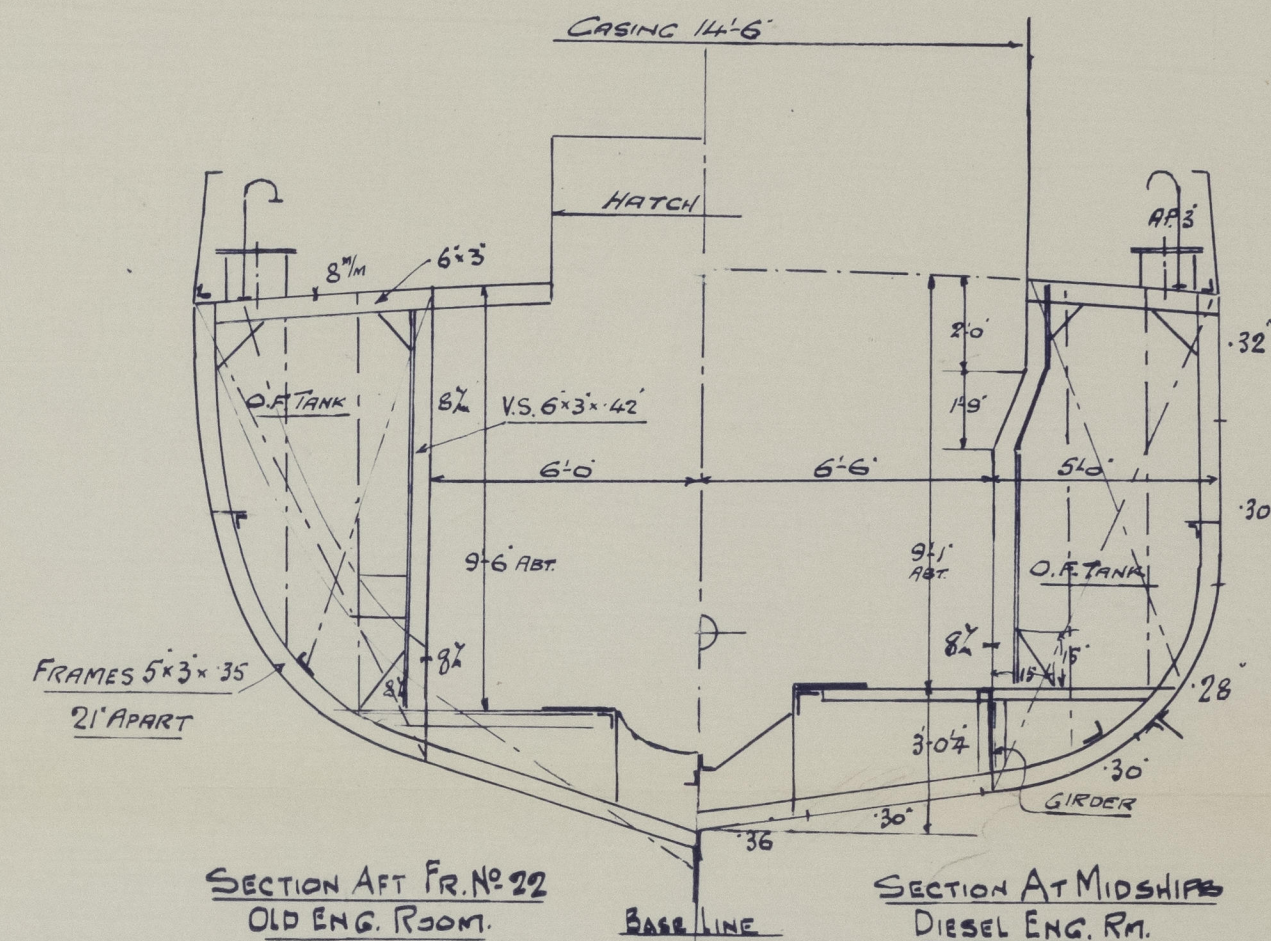

TUG BOAT "AGIOS NIKOLAOS" ex. "ABEILLE 20"
PROPOSED ARRANGEMENT
OF OIL FUEL TANKS

SCALE $\frac{1}{4}$ I.F.

LENGTH 100'0"
BREADTH 23'0"
DEPTH 12'0"

011586-011594-0118

SS/MS " ACHIOS NICHOWAOS.
TO ACCOMPANY..... PIR..... Rpt. No. 8433.
Dated..... 3.60.....
SUBJECT:- OIL FUEL TANKS.

*See also later Gen Engrs
indicating above OF Tanks*



© 2021

Lloyd's Register
Foundation

011586-011594-0118