


BOAT'S PLATING 5-6%  
BEAMS ON EVERY 2<sup>ND</sup> FRAME 120x75x8

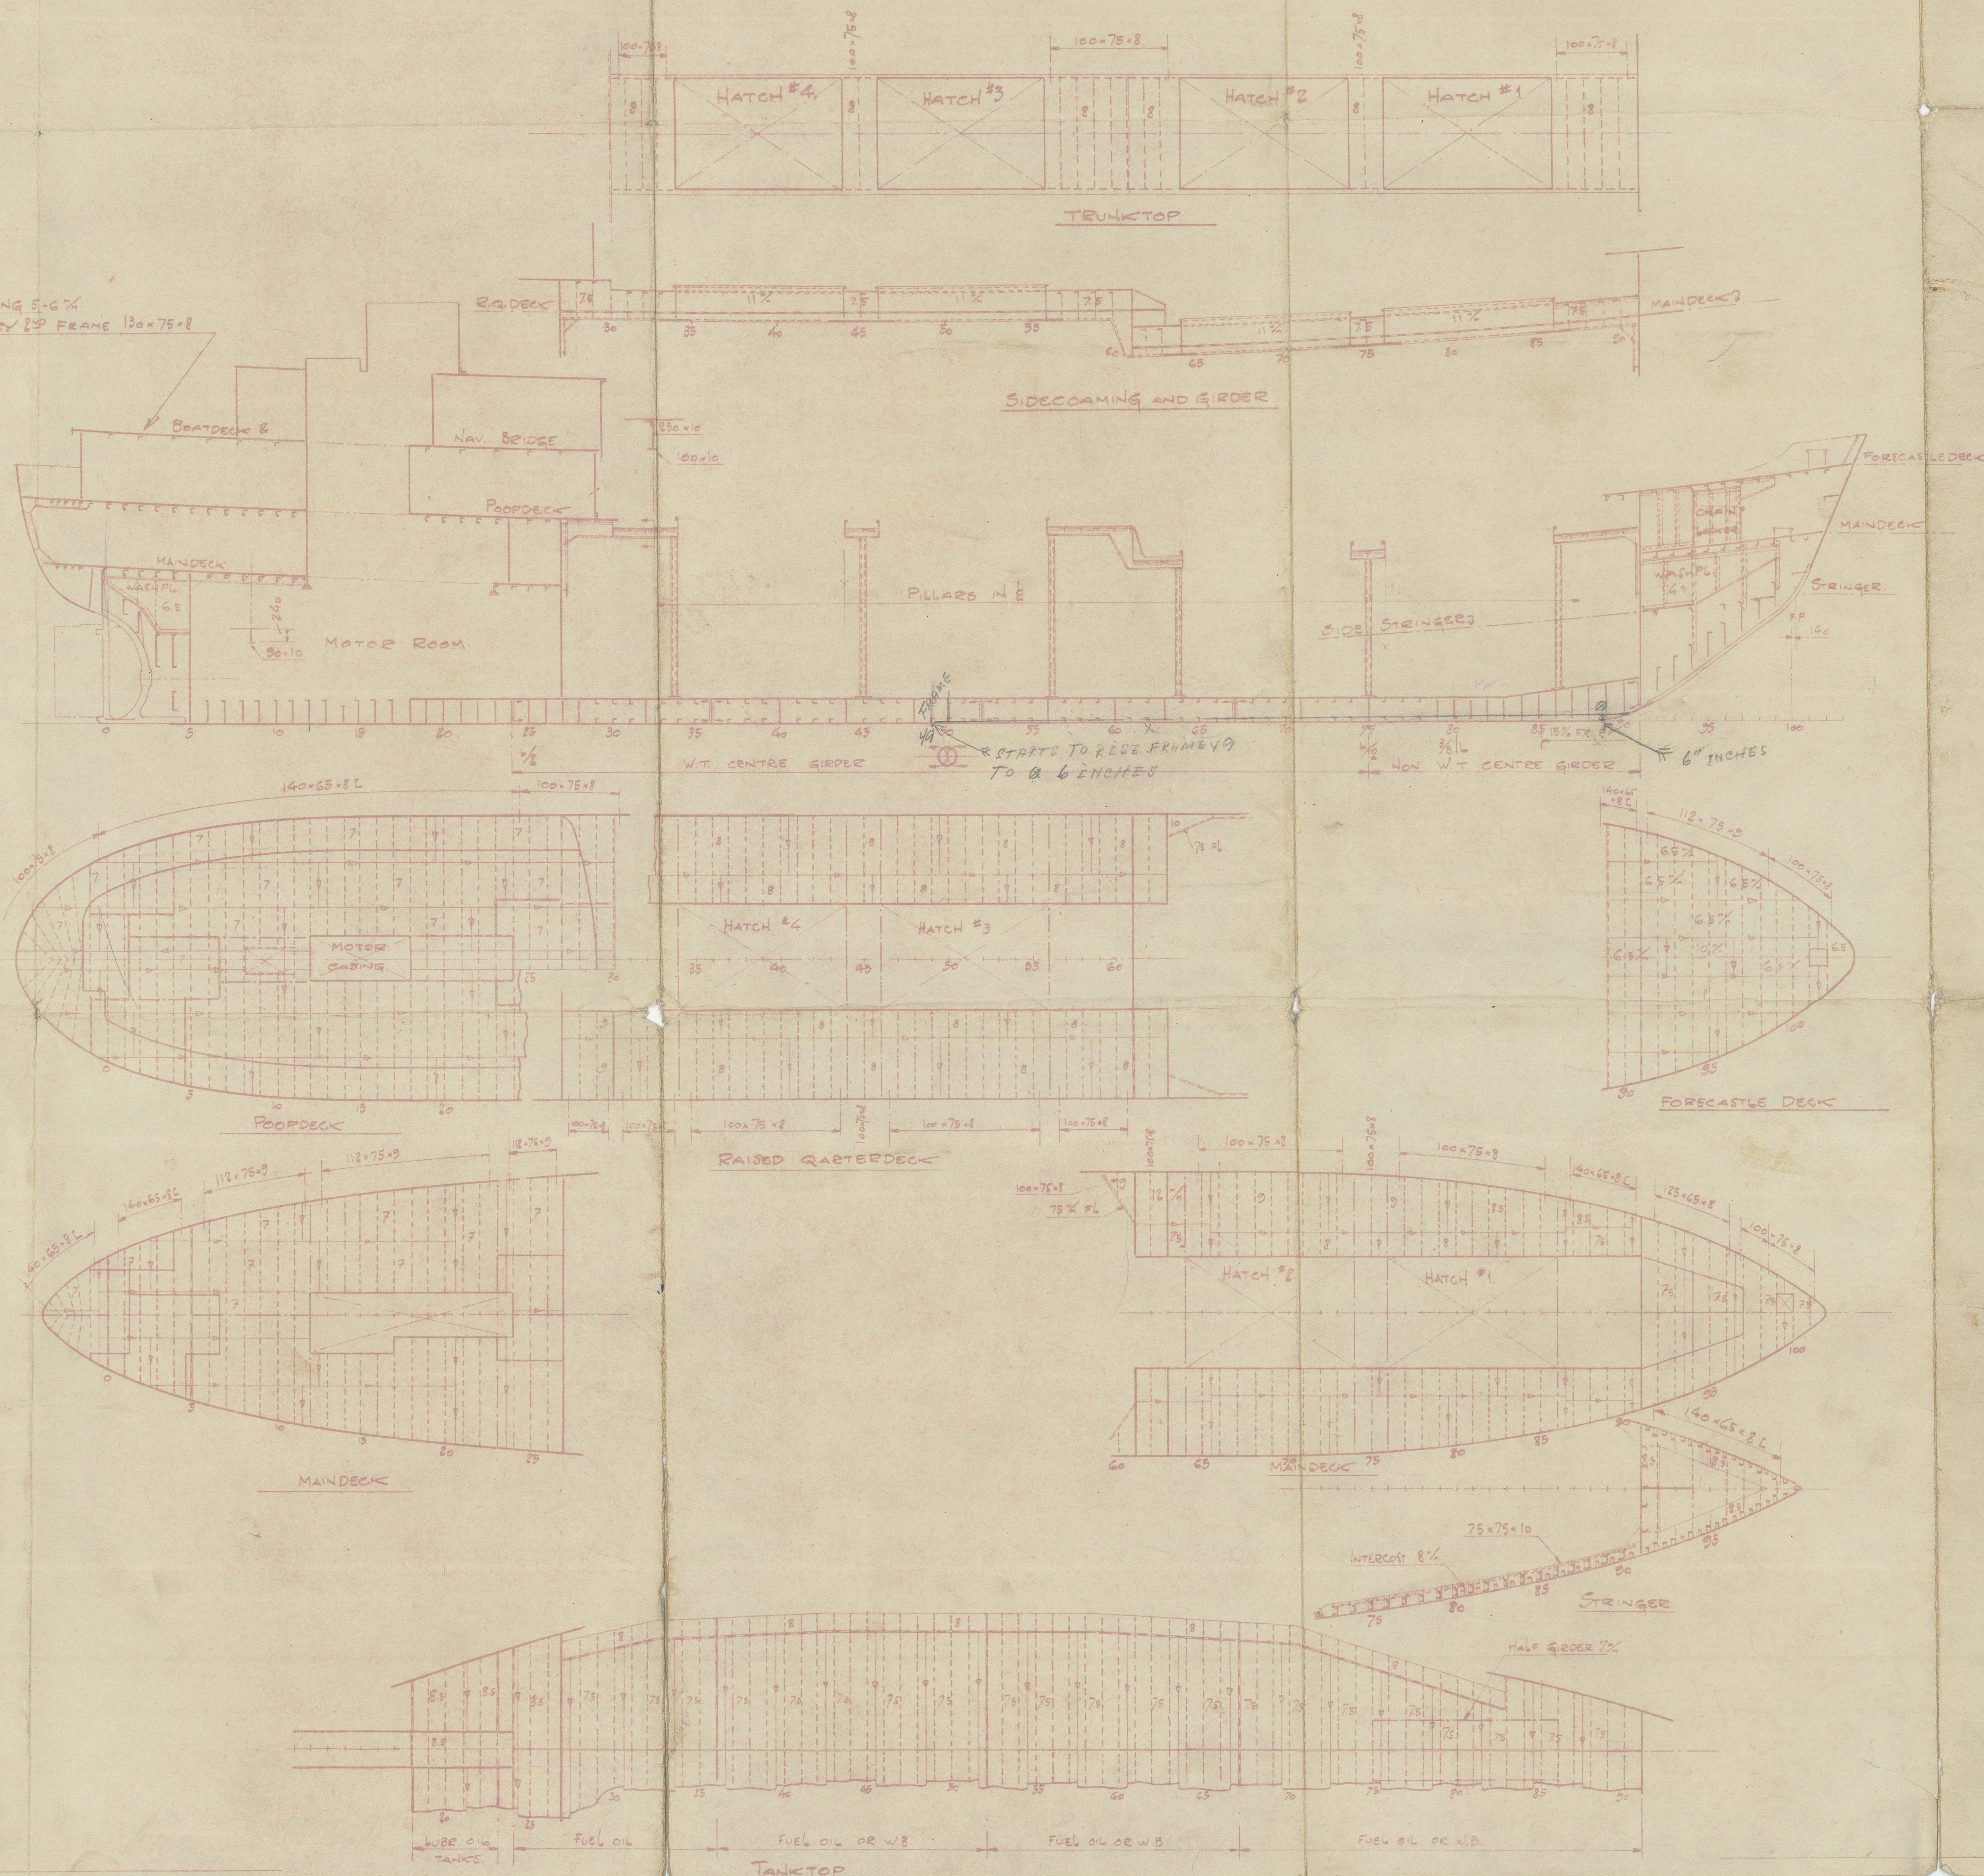

#### DIMENSIONS:

LENGTH BETW. P.P.	184'-8 1/2"	56.14m
BREADTH MOULDED	31'-6"	9.6m
DEPTH TO MAINDECK	14'-6"	4.42m
"    "    " R.Q. DECK	18'-6"	5.64m

#### CLASS

LLOYD'S REGISTER + 100 A1  
STRENGTHENED FOR NAVIGATION IN ICE  
ELECTRICALLY WELDED.

CORRECTED AS APPROVED BY LLOYD'S REG.  
18-7-47 242

LIDINGO NYA WARU 3 WERKST.  
1/3 5  
LONGITUDINAL SECTION  
AND PLANS.

Scale: 1/100    DATUM: 88-7-47    RITN. No

5/53 Naut

011603-011609-00




Lloyd's Register  
Foundation



"Vatnajökull"

Profile & decks.

RECORDS DEPT.,  
LONDON.

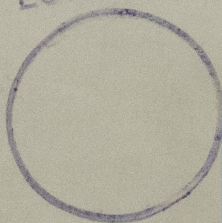

© 2021

Lloyd's Register  
Foundation

011603-01609-0052