
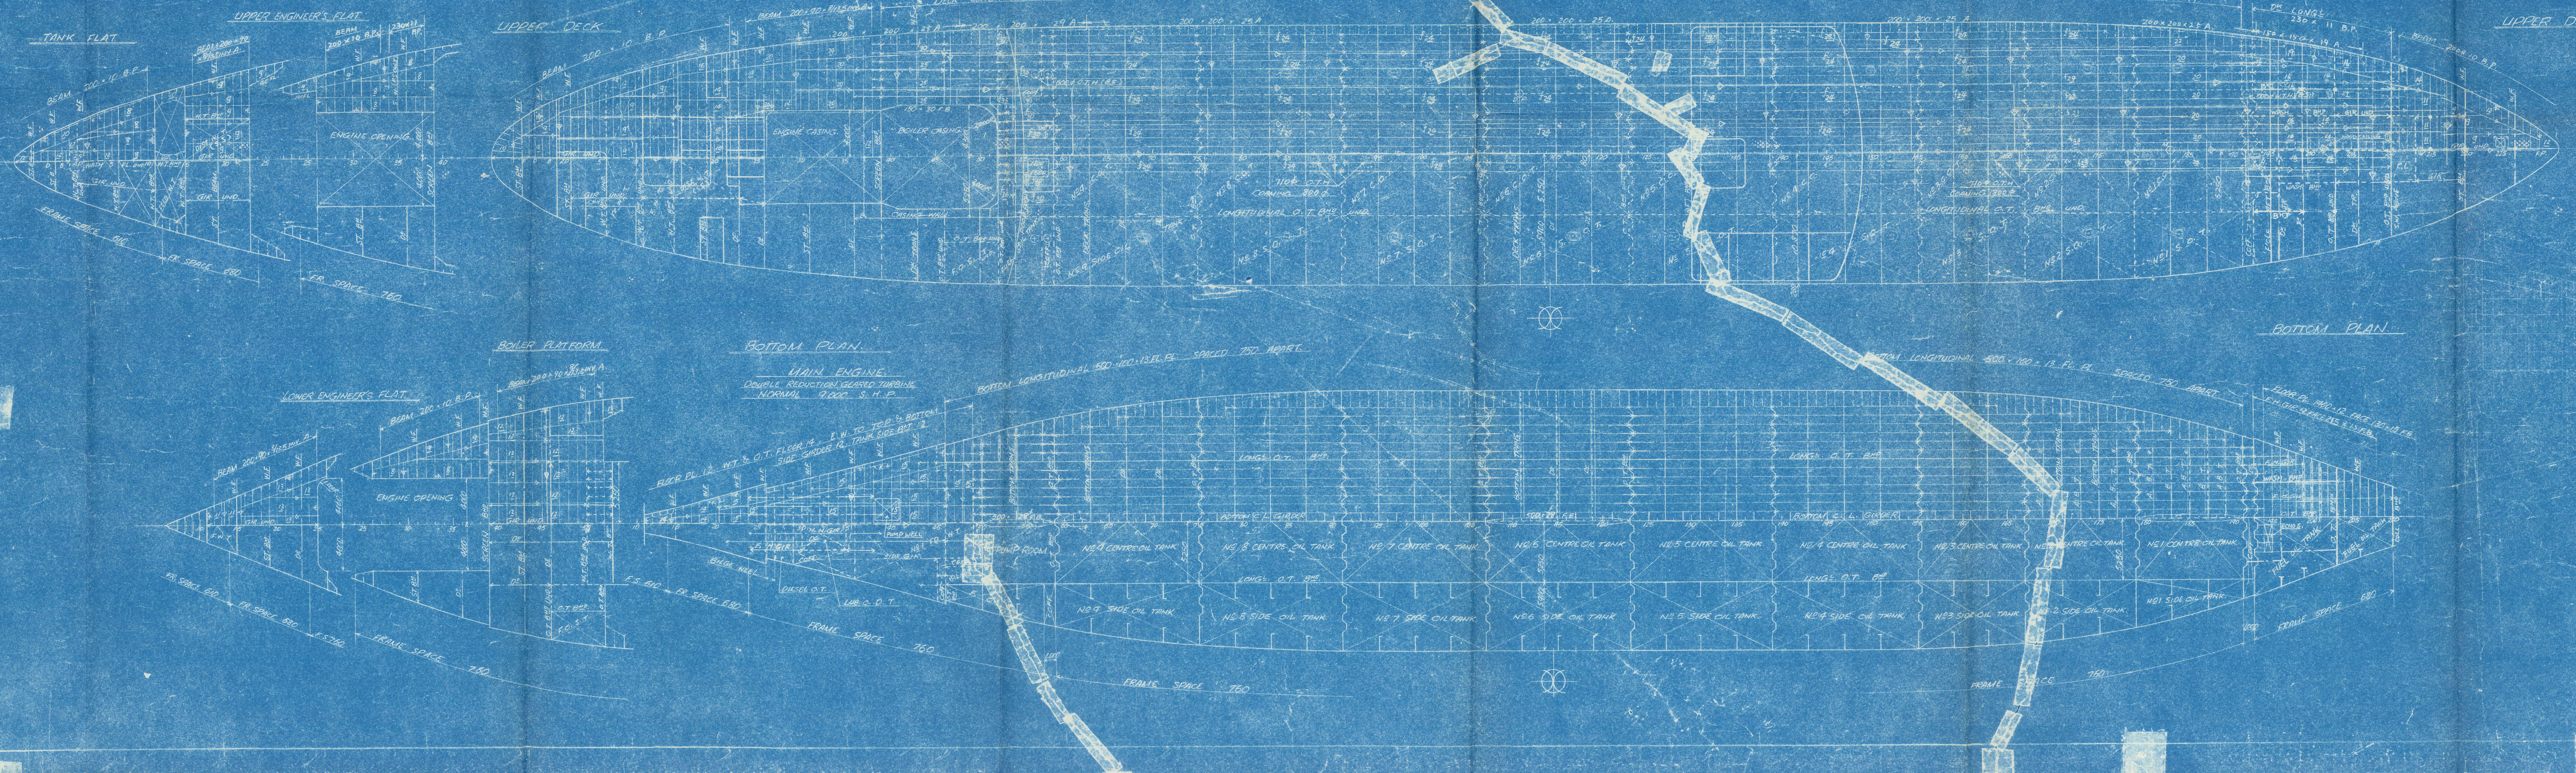
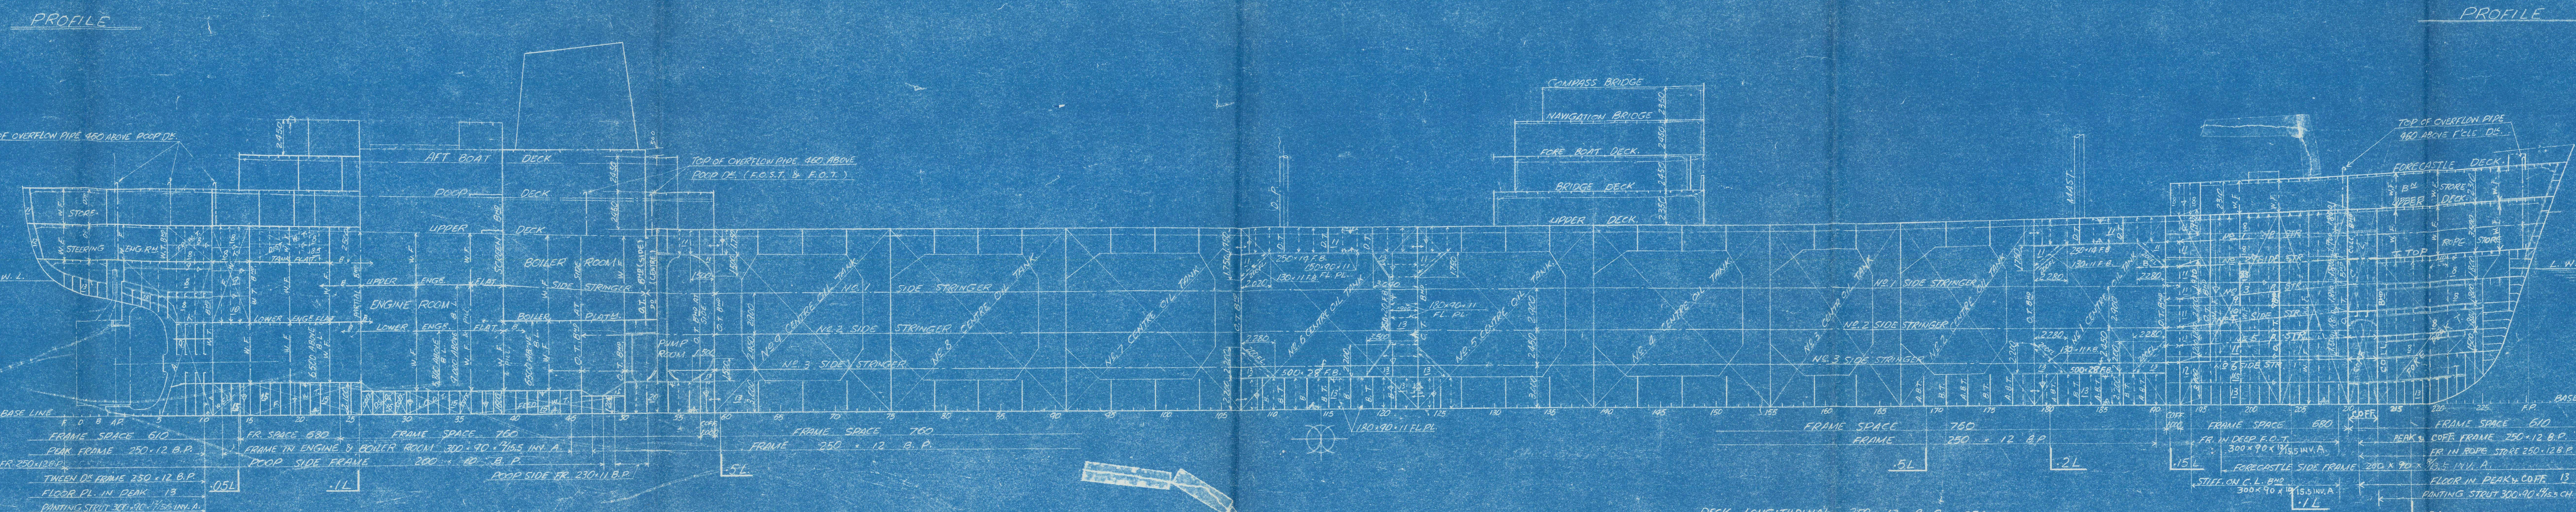


CONSTRUCTION PROFILE & DECK PLAN.

SCALE: 1/200

PRINCIPAL DIMENSIONS
 LENGTH (O.B.P.) 147'0" (44.81)
 LENGTH FROM AFT SIDE OF PARTIAL
 BACK POST 146'11" (44.66)
 BREADTH (MID) 22'30" (6.83)
 DEPTH 12'30" (3.78)
 DRAFT (DESIGNED) 9'50" (2.90)
 SHEER AT A.P. 2'00" (0.61)
 AT A.P. 1'00" (0.30)
 NO. SHEER PART 1/2
 DRAFT EXTREME ACTUAL 9'52" (2.98)

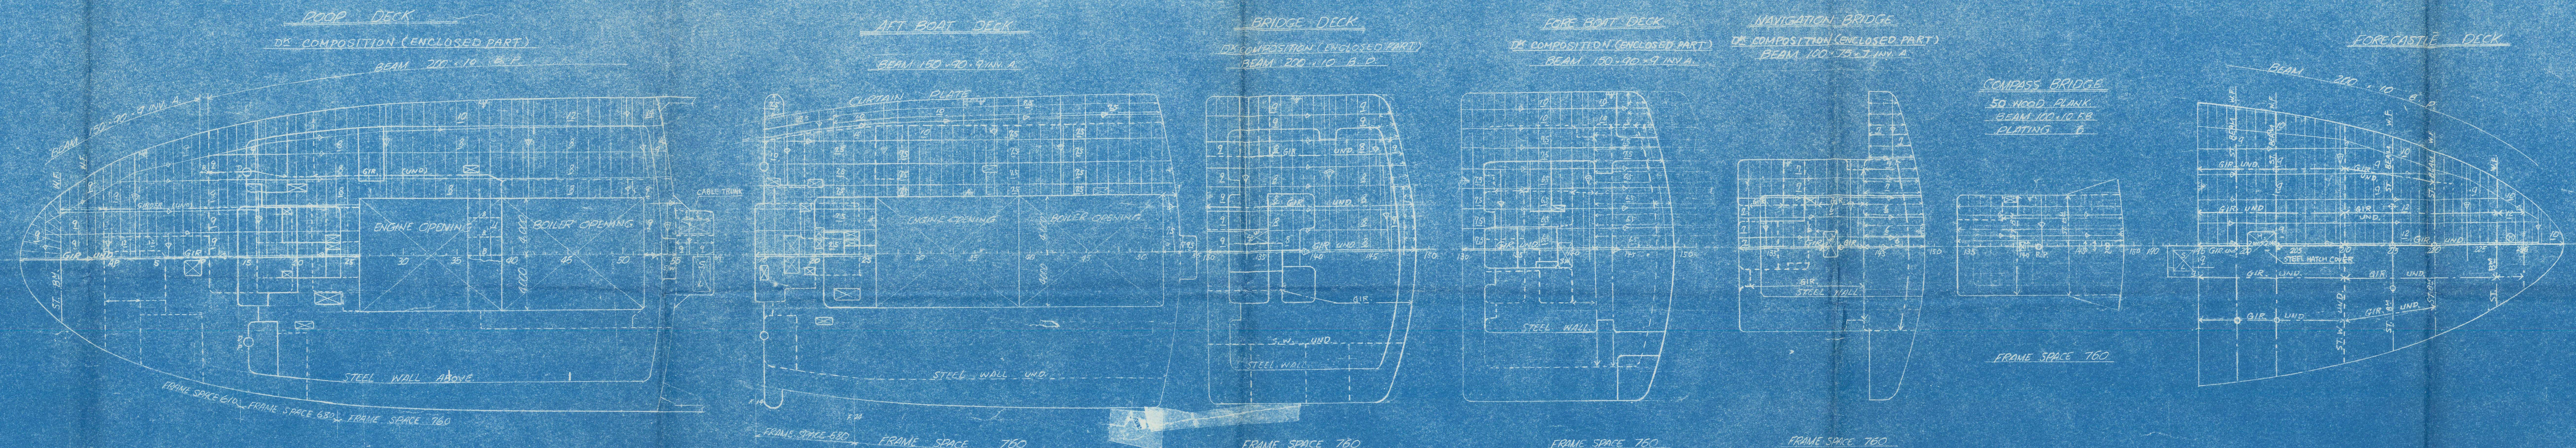

APPROVED BY
 OWNER 17-2-55
 LLOYD 15-2-55
 N.K. 16-5-55

SNO. 495
 JINGU MARU
 CONSTRUCTION
 PROFILE AND
 DECK PLAN
 1955
 DRAWING NO. H-3

SNO. 495
 神宮丸
 鋼材配置
 1955
 尺度 1/200
 30 10 22
 30 10 22
 免版 2
 H-3

APPROVED BY

OWNER 17-2-55


LLOYD 15-2-55

N.K. 16-5-55

SN^o. 495

JINGU MARU


CONSTRUCTION
PROFILE AND
DECK PLAN

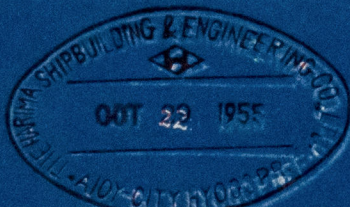

DRAWING NO.

H-3

RECORDS DEPT.,
LONDON.

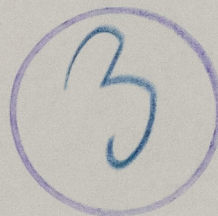

KODE RPT. NO. 3253

DATED. © 2021



Lloyd's Register
Foundation


011614-011627-0073

SN. 495
神宮丸

鋼
杖
配
置

完成圖

尺度

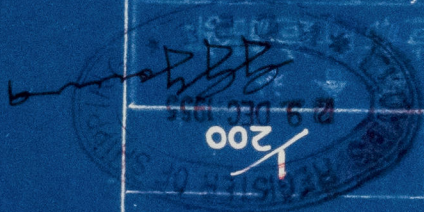

圖面番號	H-3
設計番號	完成 2
圖面日期	30 10 29
出圖號	
校對日期	30 10 22
校對者	
課長	y.s.

011619-011627-6073

TO LLOYD'S