

3.4.29

# N<sup>o</sup> 1684 - S5. PAIDLE FERRY STEAMERS. PROFILE & DECK PLANS.

SCALE:- 1/8 INCH = 1 FOOT.

DIMENSIONS:- 171'-6" x 44'-0" x 7'-6" MLD.

TO CLASS LLOYDS A.I. \* FOR WOOLWICH FERRY PURPOSES.


TO HAVE B.O.T. PASSENGER CERTIFICATE.

LLOYDS NUMERALS:-


TRANSVERSE NO 51.5

LONGITUDINAL NO 8832.

PROPORTIONS 1/2 22.5.

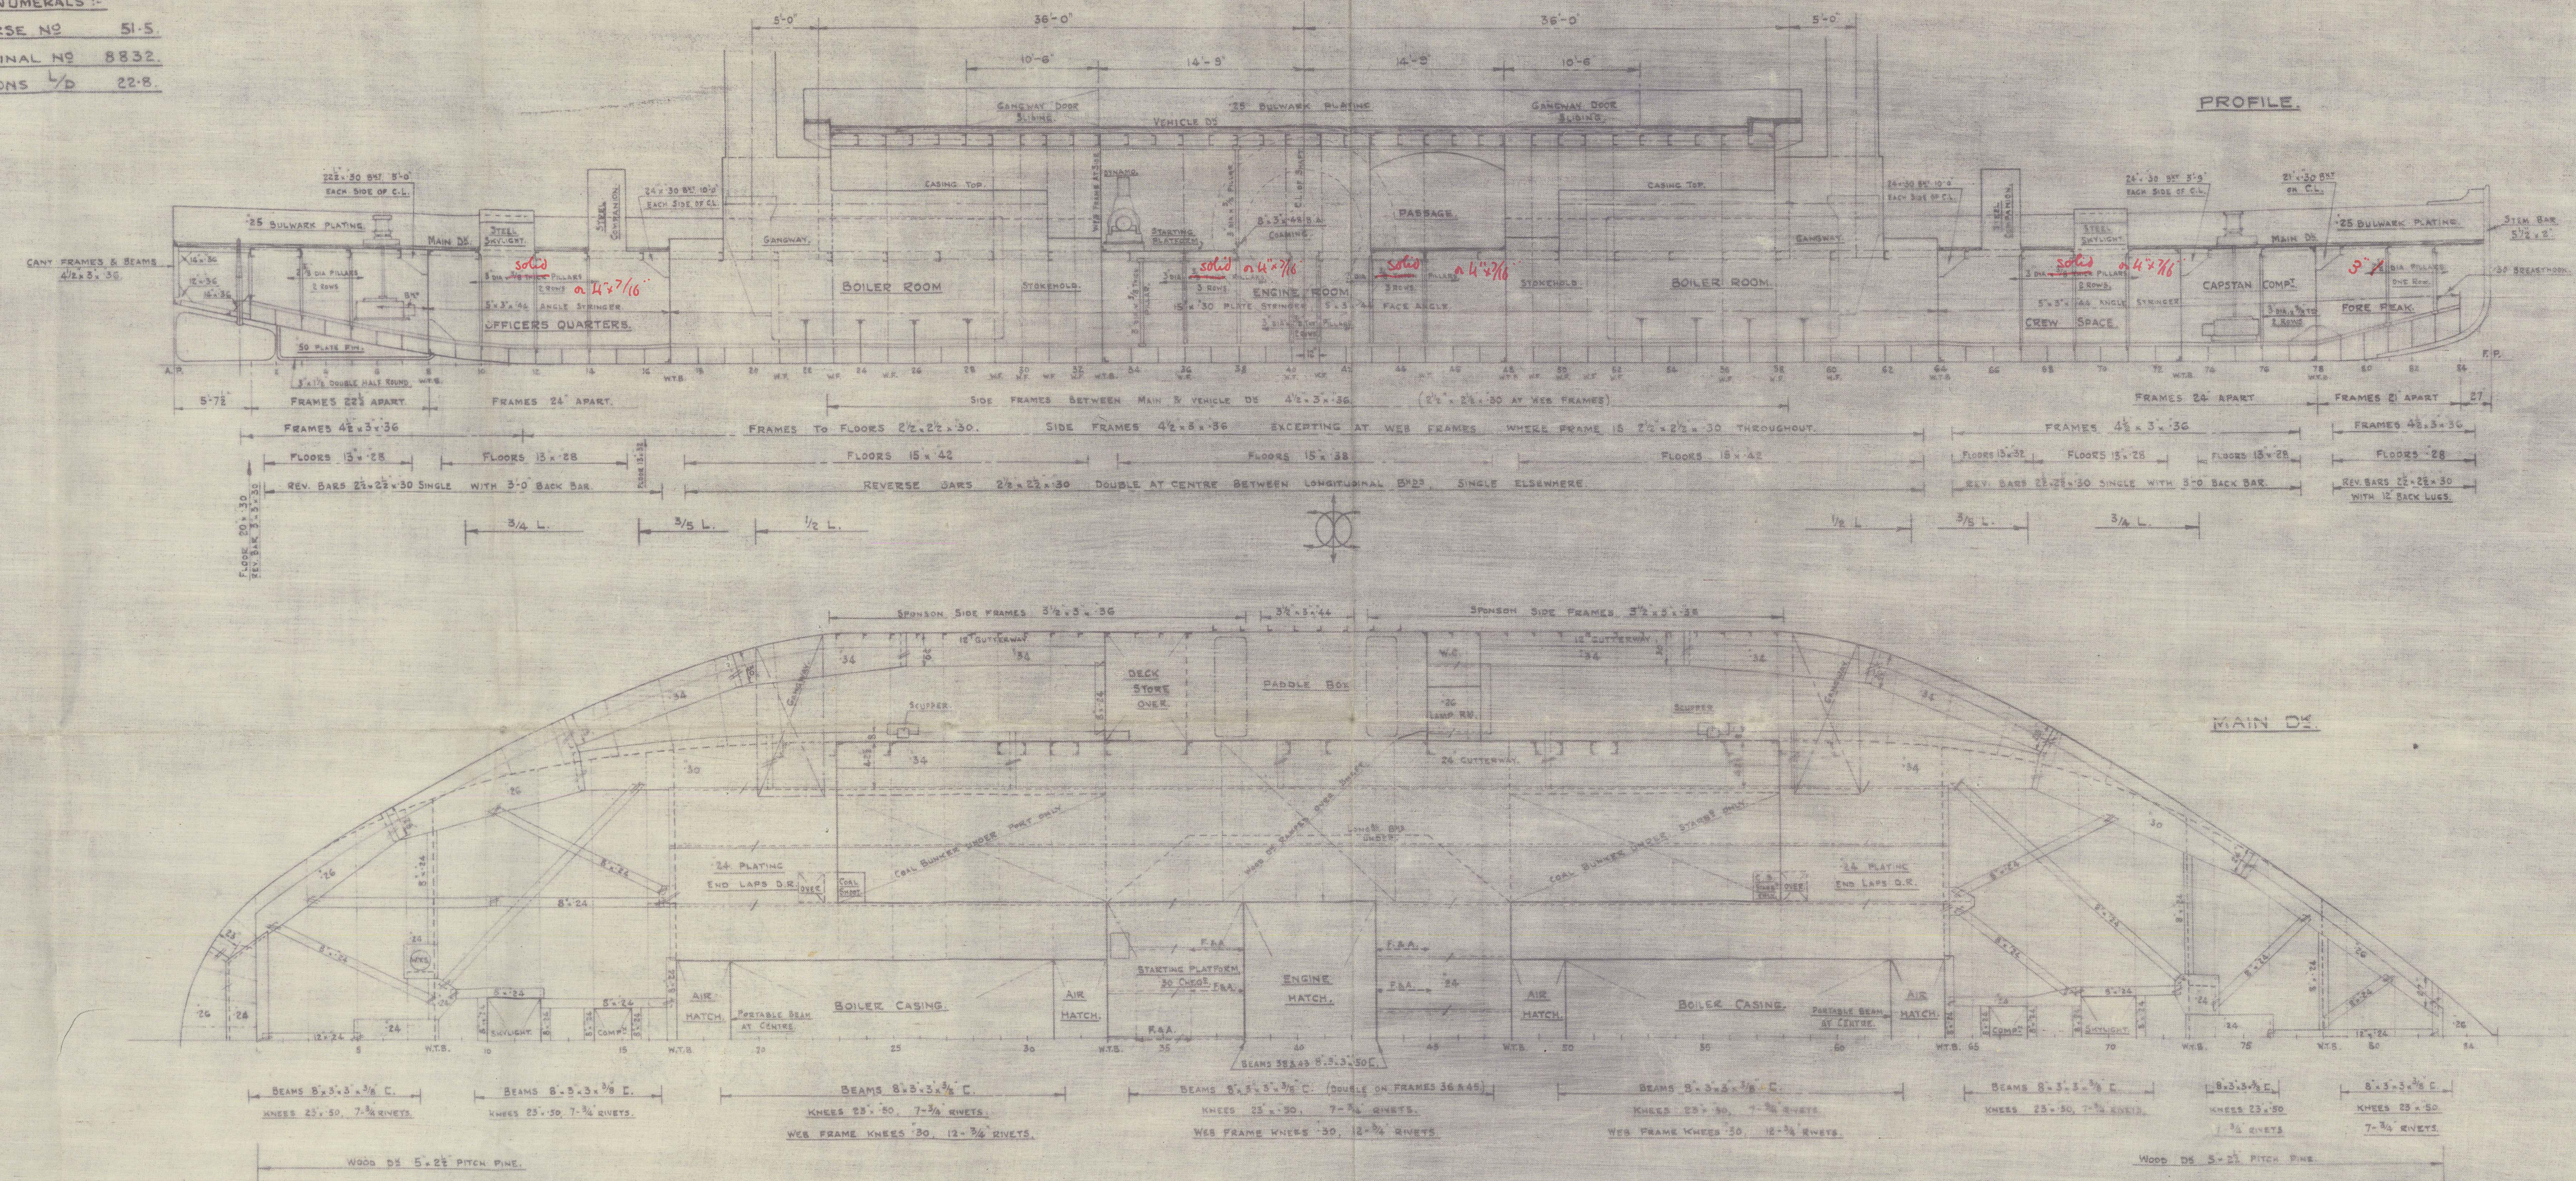

NOTE:- FRAMES ON WHICH THERE IS NO BEAM ARE NOT CONNECTED TO MAIN DS.

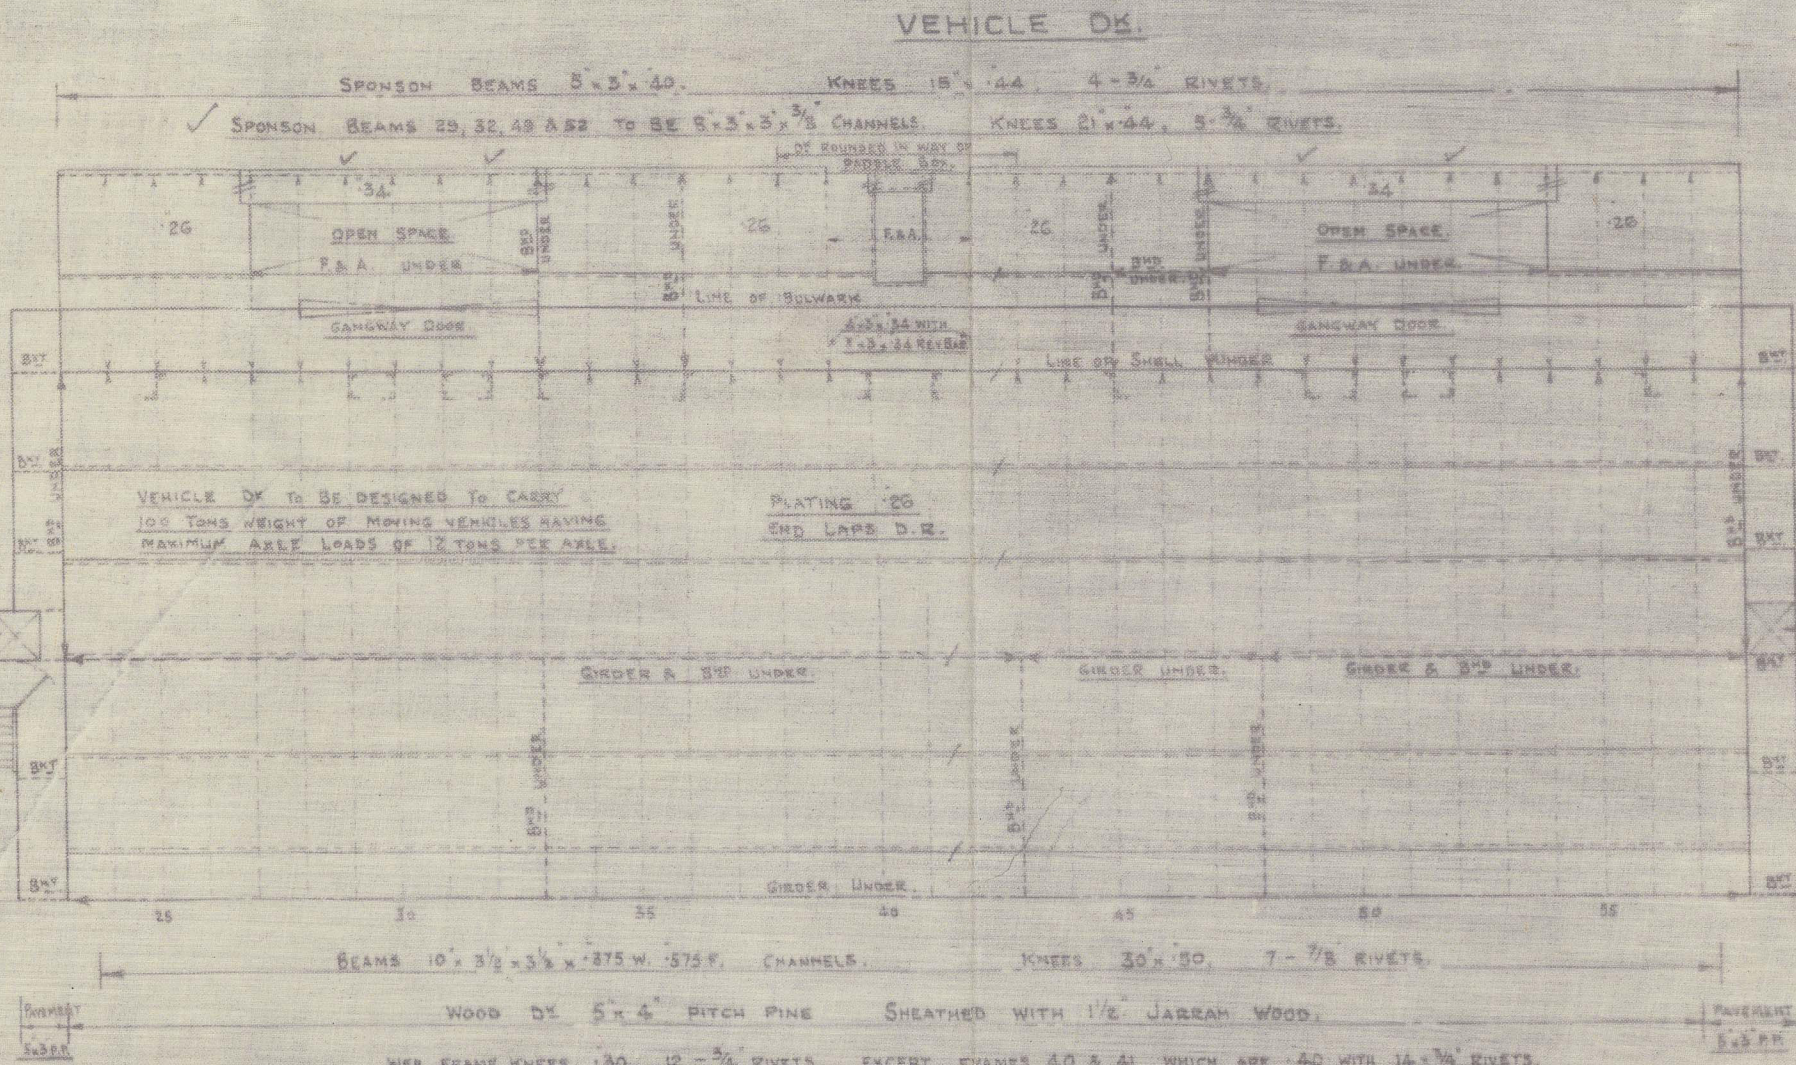

W.T. BULKHEAD SCANTLINGS.							
NO	DEPTH AT C.L.	BOTTOM STRAKE	REMAINDER	STIFFENERS	SPACING	END ATTACHMENTS	FRAME SHE
8	7'-6"	36" x 30	26	4" x 34	30	4" x 34 LUG 2-1/2 RIVETS.	3" x 36
17	8'-1"	42" x 30	26	"	"	"	"
35	8'-1"	42" x 30	26	"	"	"	"
48	8'-1"	42" x 30	26	"	"	"	"
64	8'-1"	42" x 30	26	"	"	"	"
75	8'-5"	42" x 30	26	"	"	"	"
78	8'-5"	40" x 32	26	4" x 38	24	"	3" x 38

BEAMS & BUTTS OF BOTTOM STRAKE DOUBLE RIVETED.  
BEAMS & BUTTS OF REMAINDER SINGLE RIVETED.  
RIVETS CONNECTING STIFFENERS TO BHP TO BE SPACED 4 DIAS.  
FOR 15" OF LENGTH FROM EACH END. REMAINDER 7 DIAS.

DRAWING N<sup>o</sup> 1.

3.4.29



" " "  
WILL CROOKS & JOHN BENN"

N<sup>o</sup>s. 1684-5.

J. Samuel White & Co Ltd

Lee. Woolwich Ferry.

PROFILE & DECK PLANS.

Approved 3/4/29

RETAIN



© 2021

Lloyd's Register  
Foundation

01619-01627-0113

No. 3 1684-5.

J. Samuel White & Co Ltd

Lee Woolwich Ferries

Profile & Deck Plans

011619-011627-0113



© 2021

Lloyd's Register  
Foundation